


DUNHAM SURVEYING, S.C.
SURVEYING & SUBDIVIDING
DELAVER, WISCONSIN 53115

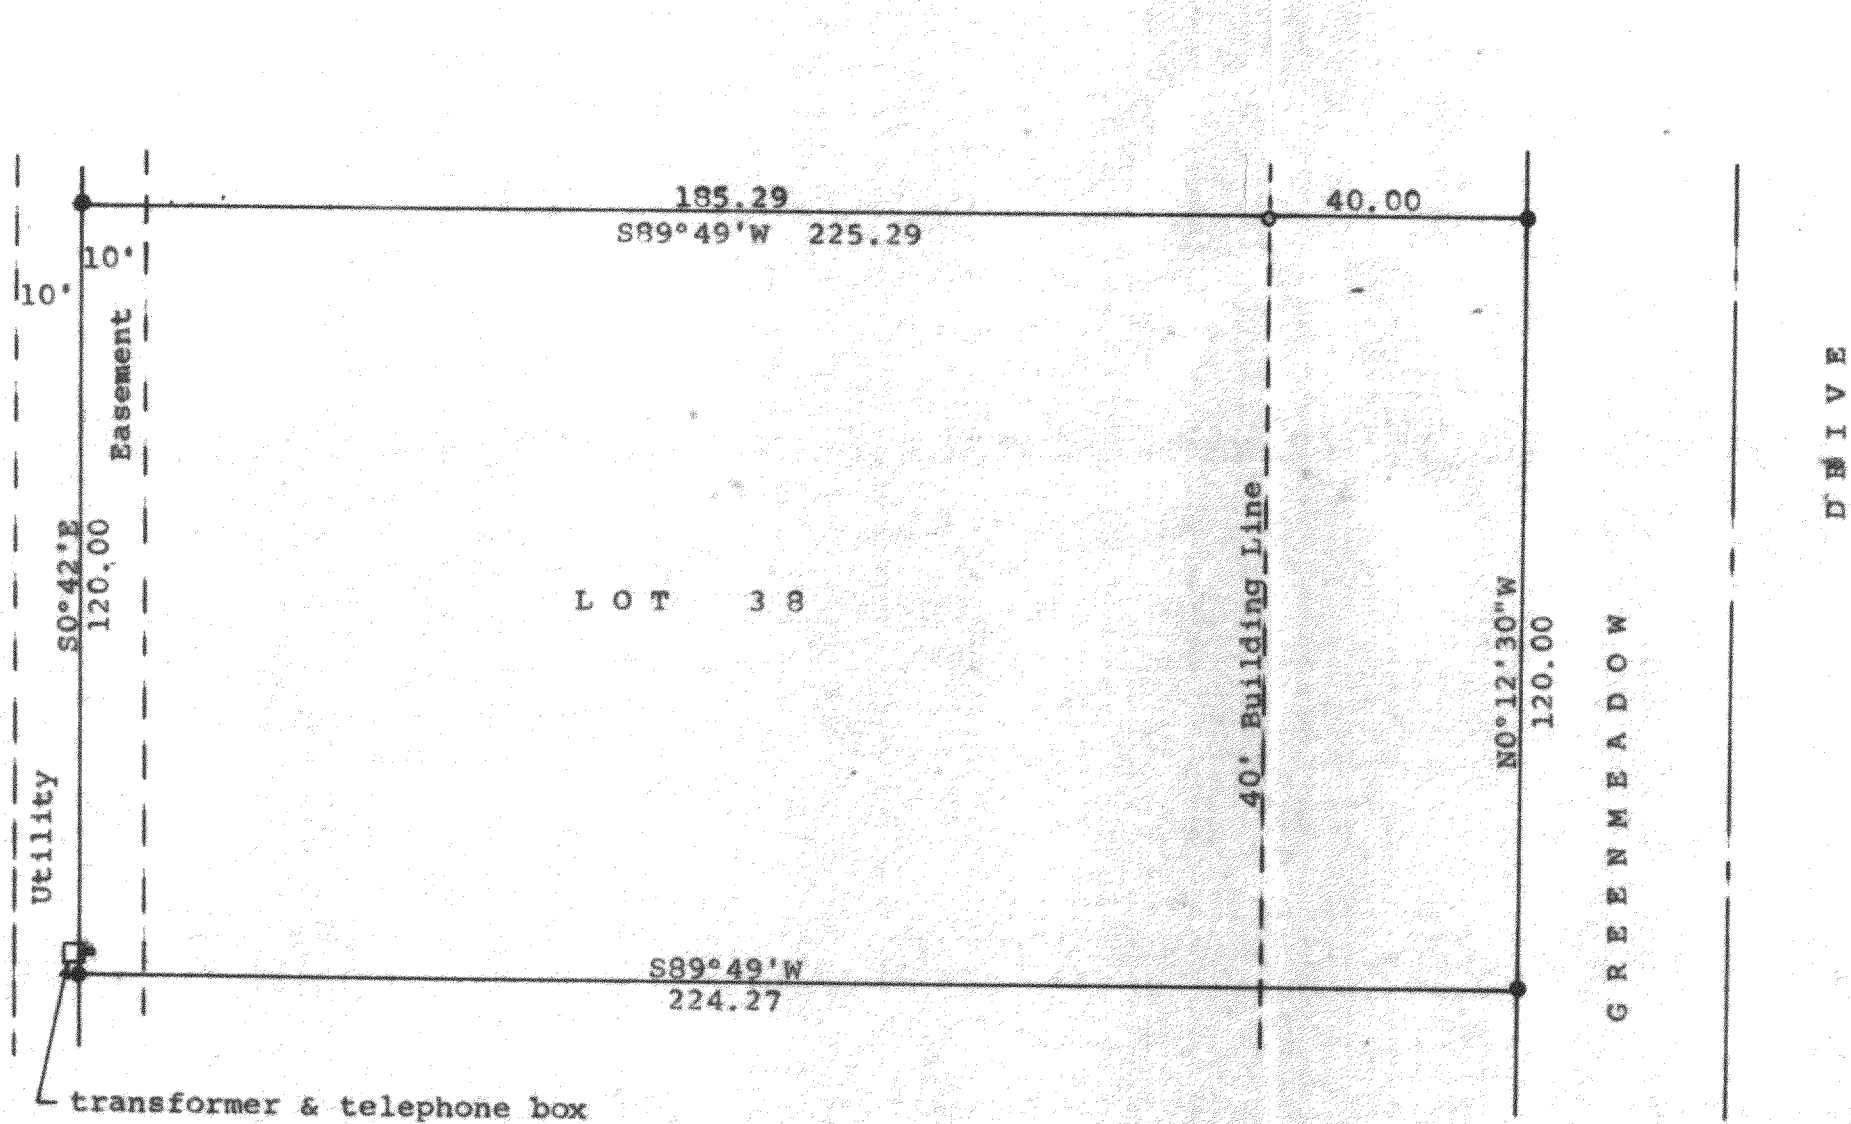


Scale - 1" = 30'
● = 1 1/16" Dia. iron rod found
○ = 1/2" Iron Pipe Found
Bearings used are the same as on the
recorded plat of Oak Meadow Subdivision
Survey ordered by:
Century 21, Skandia Realty
312 South 7th Street
Delaver, WI 53115

STATE OF WISCONSIN)
COUNTY OF WALWORTH) SS

I, George T. Dunham, Surveyor, certify that I have surveyed the
property described as follows:

Lot 38 in Oak Meadow Subdivision, located in the Northeast 1/4 of
Section 29, T 2 N, R 16 E, Walworth County, Wisconsin
and that the plat shown hereon is a correct representation thereof and shows
the size and location of the property, its exterior boundaries, the location
of all visible structures and dimensions of all principal buildings thereon,
boundary fences, apparent easements, roadways and visible encroachments, if
any, and that I have surveyed the property hereon described, according to the
official records, to the best of my knowledge and belief.
October 26, 1988

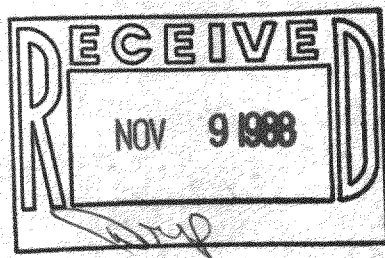

George T. Dunham
George T. Dunham, Surveyor

