


DUNHAM SURVEYING, S.C.
SURVEYING & SUBDIVIDING
DELAVER, WISCONSIN 53115

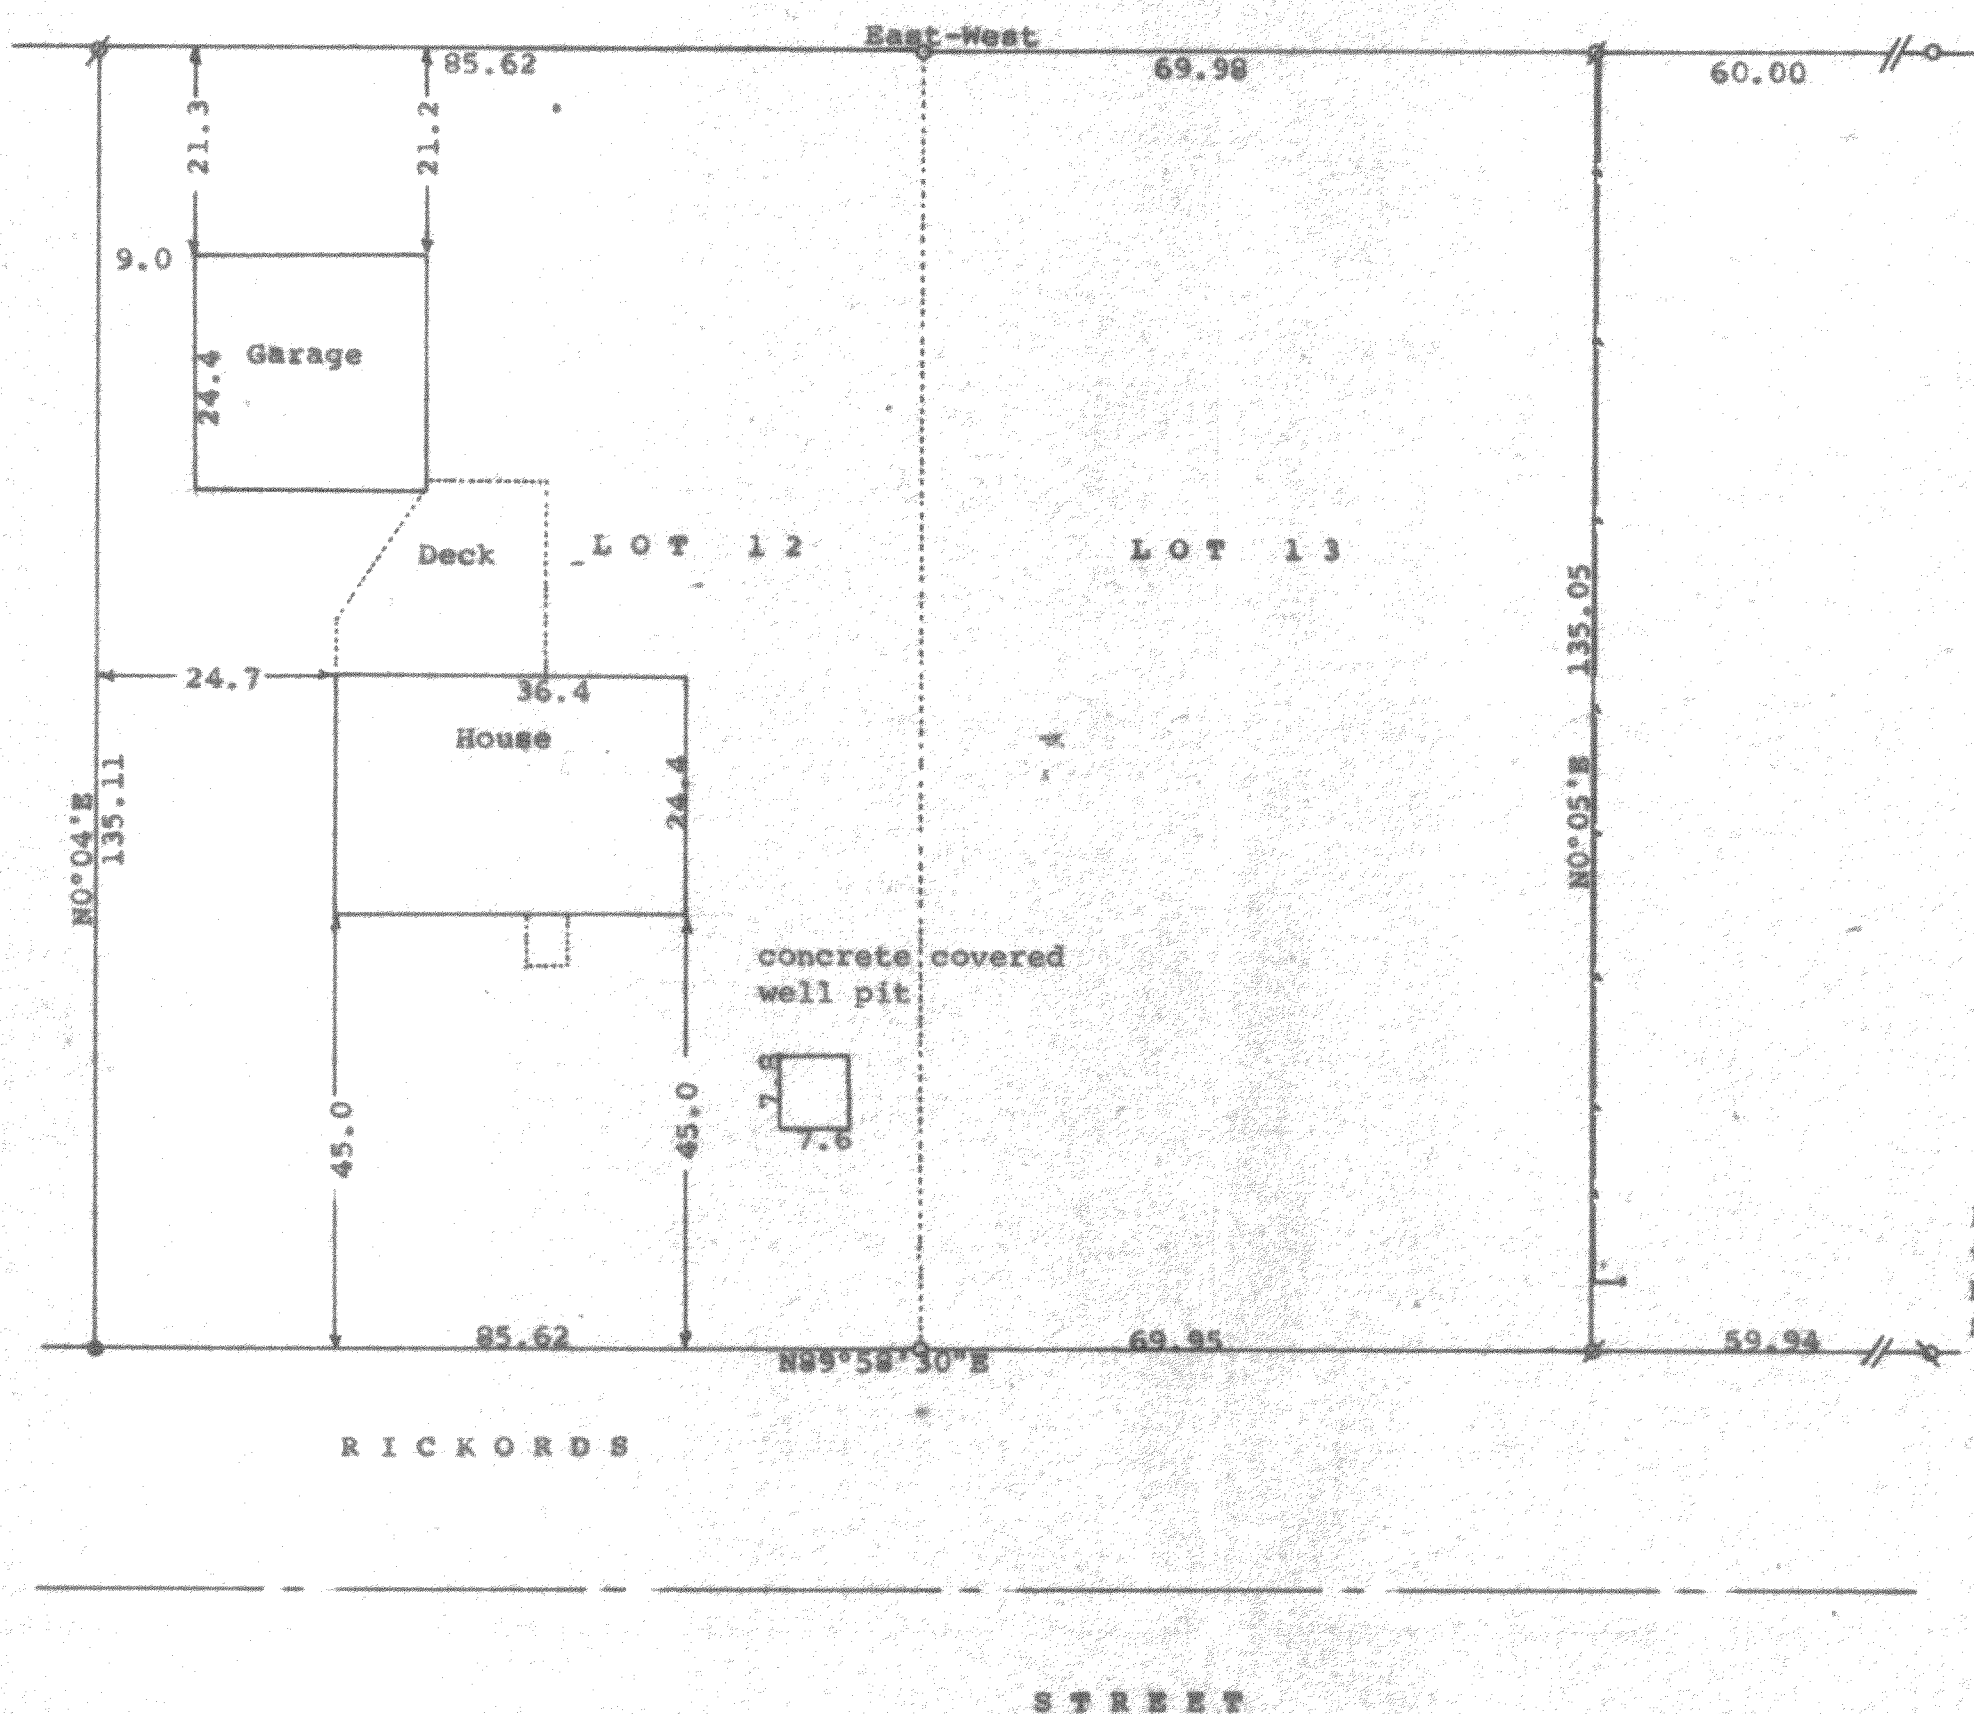

Scale - 1" = 20'

o = 1" Iron Pipe Found

⌘ = 1" Bent iron pipe found and corrected

* = rust mark in subsoil found

1"X24" Iron Pipe Set

— = fence line

Bearings referenced to the north line of the lots, with the recorded bearing of East-West

Survey ordered by: Realty World, Carmin Realtors, 511 East Geneva Street, Delavan, WI 53115

⌘ = 1" Iron Pipe Found


STATE OF WISCONSIN) SS
COUNTY OF WALWORTH)

I, George T. Dunham, Surveyor, certify that I have surveyed the property described as follows:

Lots 12 and 13 in Block 5 of Delmar, a subdivision located in Section 27, T 2 N, R 16 E, Walworth County, Wisconsin,

and that the plat shown hereon is a correct representation thereof and shows the size and location of the property, its exterior boundaries, the location of all visible structures and dimensions of all principal buildings thereon, boundary fences, apparent easements, roadways and visible encroachments, if any, and that I have surveyed the property hereon described, according to the official records, to the best of my knowledge and belief.

October 13, 1988

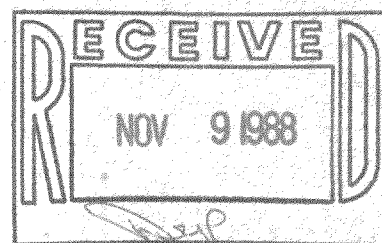

George T. Dunham
George T. Dunham, Surveyor

