
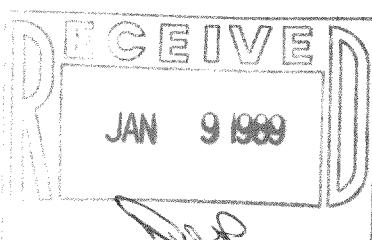


ABELL  
SURVEYING & MAPPING  
DELAVAL, WISCONSIN 53115  
414-728-6737

PLAT OF SURVEY OF

LOT 24, BLOCK "C", DELAVAN LAKE  
ASSEMBLY GROUNDS, T2N, R16E,  
WALWORTH COUNTY, WISCONSIN.

ORDERED BY: TOD ISAACSON  
1119 N. DUNTON ST.  
ARLINGTON HEIGHTS, IL.  
60004

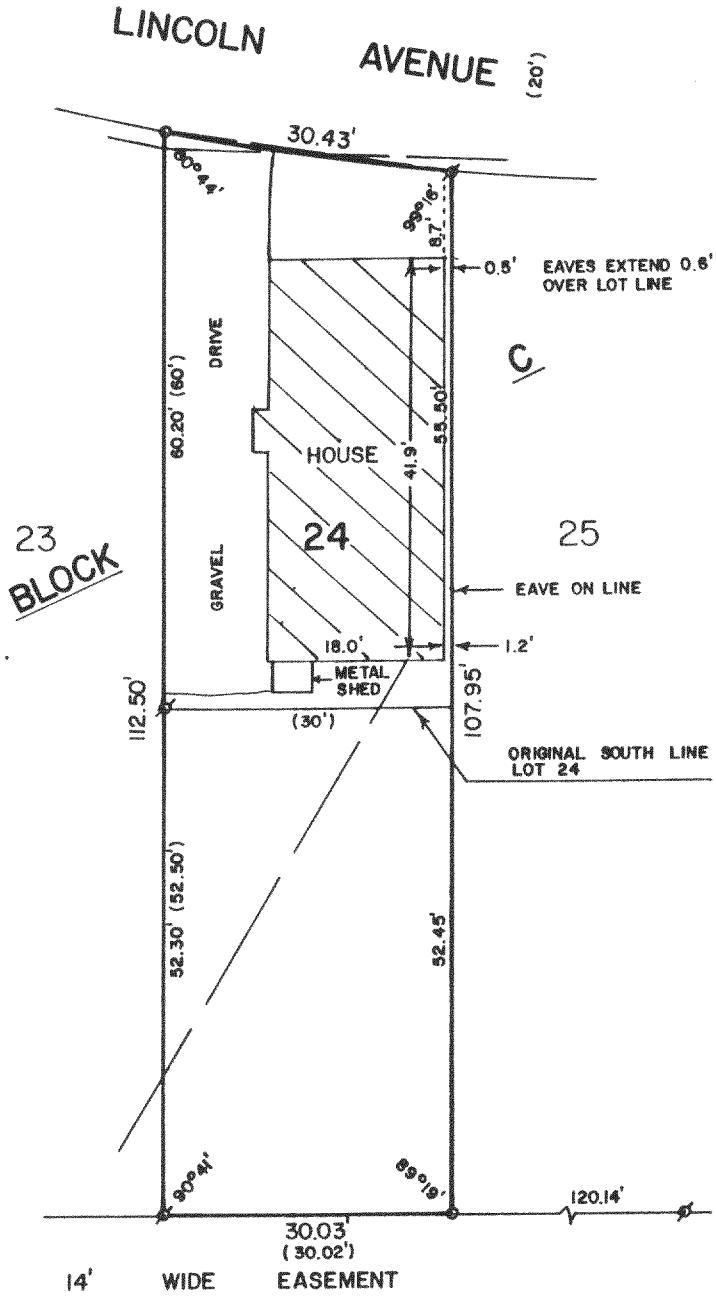

SCALE - 1"=20'

LEGEND

- ♂ - IRON PIPE FOUND
- - IRON PIPE SET
- ( ) - RECORDED AS
- - OVERHEAD UTILITY LINES

I HEREBY CERTIFY THAT I HAVE SURVEYED THE ABOVE DESCRIBED PROPERTY AND THAT THE ABOVE MAP IS A TRUE REPRESENTATION THEREOF AND SHOWS THE SIZE AND LOCATION OF THE PROPERTY, ITS EXTERIOR BOUNDARIES, THE LOCATION OF ALL VISIBLE STRUCTURES AND DIMENSIONS OF ALL PRINCIPAL BUILDINGS THEREON, BOUNDARY FENCES, APPARENT EASEMENTS, ROADWAYS AND VISIBLE ENCROACHMENTS, IF ANY, TO THE BEST OF MY KNOWLEDGE AND BELIEF.

THIS SURVEY IS MADE FOR THE USE OF THE PRESENT OWNERS OF THE PROPERTY, AND ALSO THOSE WHO PURCHASE, MORTGAGE, OR GUARANTEE THE TITLE THERETO WITHIN ONE (1) YEAR FROM DATE HEREOF.

*David F. Abell*

DAVID F. ABELL  
WISCONSIN REGISTERED LAND SURVEYOR, S-1596

*October 18, 1988*

DATE JOB NUMBER - 88238  
NOTE: THIS IS NOT A CERTIFIED COPY UNLESS SEALED.

216-1134