

TOWN ROAD (66' WIDE)

NE 1/4 CORNER OF
SECTION 13 T2N R1E


N

EAST
107.25

220.99

33

33

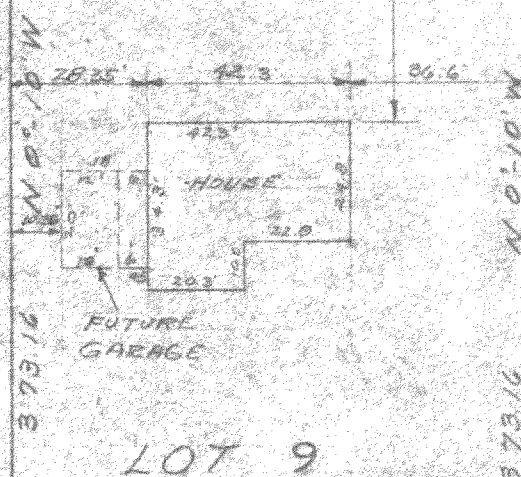

0 IRON PIPE

STATE HIGHWAY NO 67

STATE OF WISCONSIN)⁵⁵
COUNTY OF WALWORTH]

I, LLOYD L. JENSEN, DO HEREBY CERTIFY THAT I HAVE SURVEYED
THE PROPERTY DESCRIBED HEREON ACCORDING TO THE OFFICIAL RECORDS AND
THAT THE PLAT HERE ON IS A CORRECT REPRESENTATION OF THE LOT
LINES AND PRINCIPAL LINES OF BUILDINGS THEREON.

ELKHORN WISCONSIN MARCH 29, 1955

Lloyd L. Jensen
SURVEYOR

PLAT OF SURVEY
OF

LOT 9 ELKWOOD A
SUBDIVISION LOCATED IN THE
NE 1/4 OF THE NE 1/4 OF SECTION 13
T2N R1E WALWORTH COUNTY
WISCONSIN

Lloyd L. Jensen
SURVEYOR

SCALE 1" = 40'

DATE MARCH 29, 1955

FSW-9