
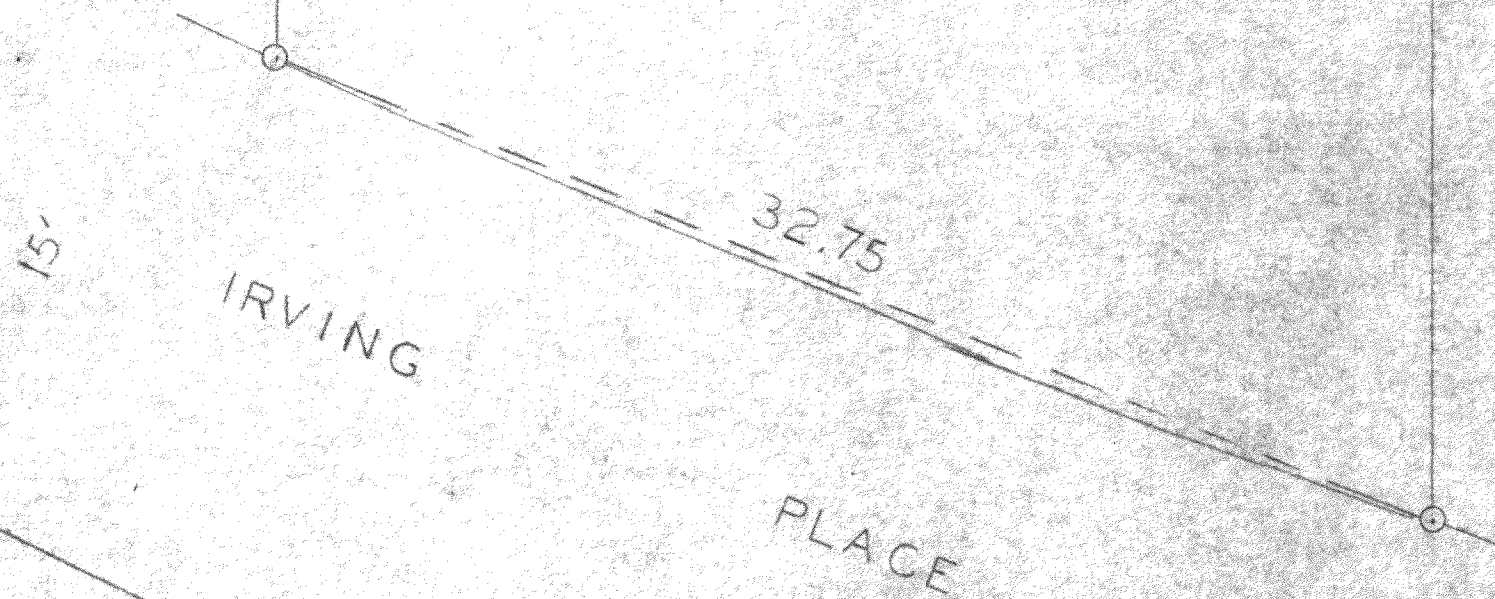


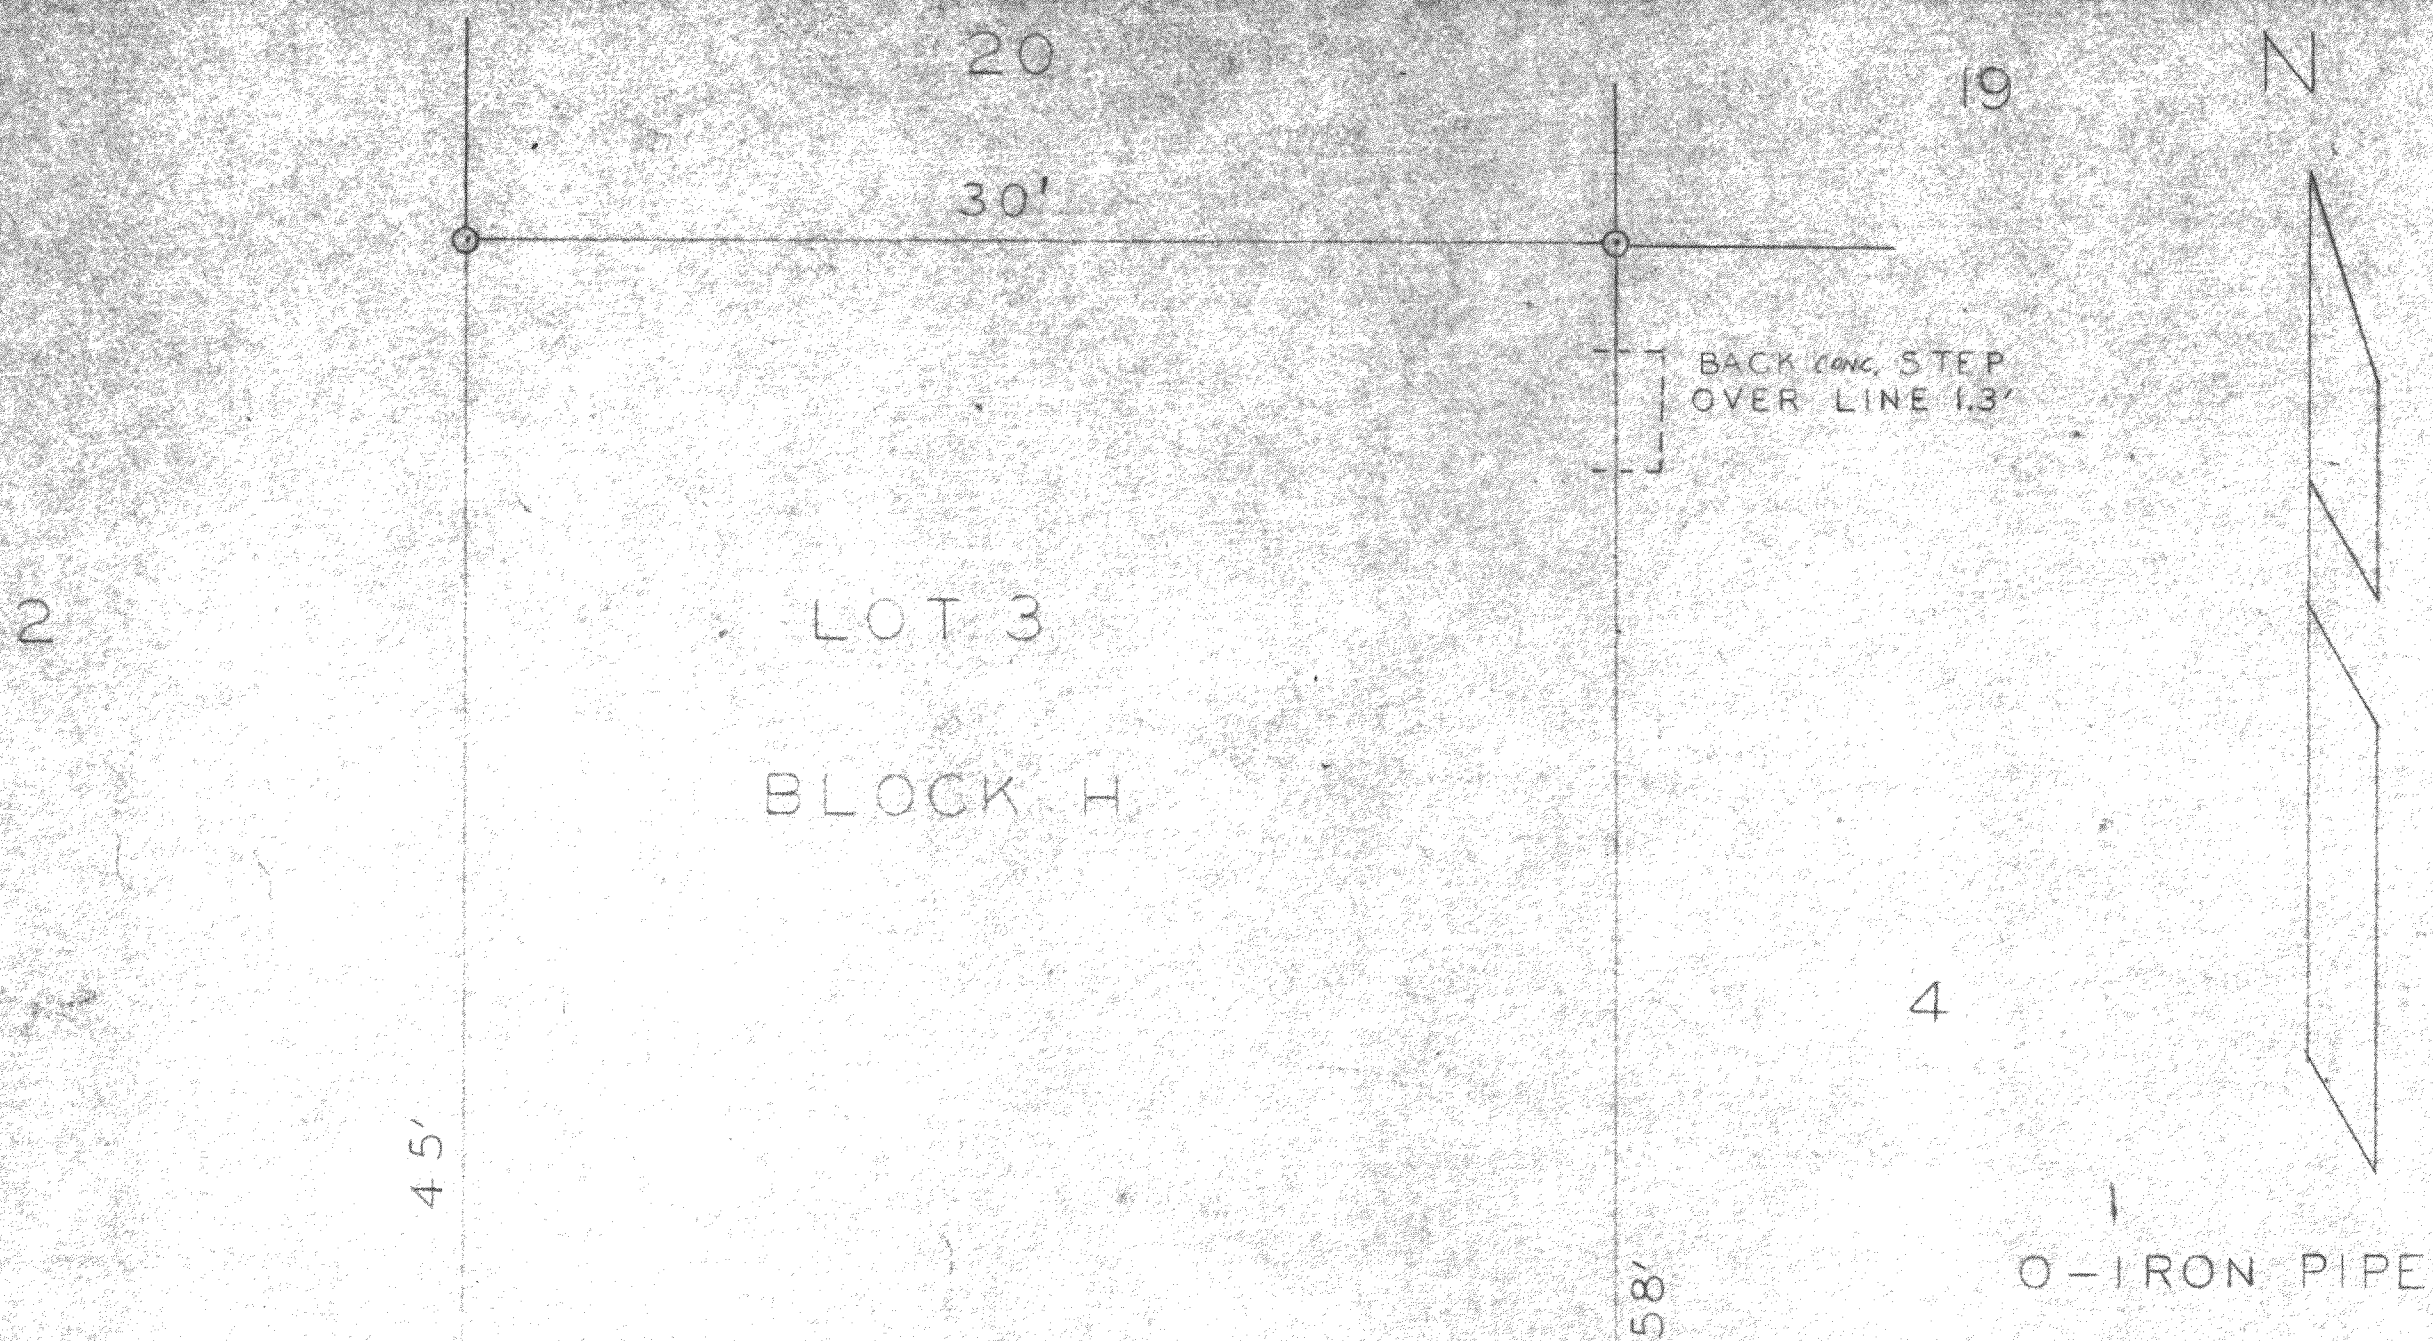

**PLAT OF SURVEY
OF**

LOT 3 OF BLOCK H. OF
DELANE LAKE ASSEMBLY GROUNDS
LOCATED IN T2N R16E
WALWORTH COUNTY, WISCONSIN

Lloyd L. Jensen
SURVEYOR

SCALE 1" = 5'

DATE MAY 1956