

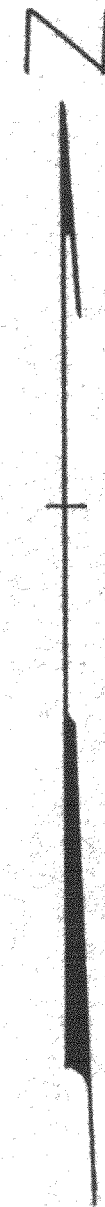


DUNHAM SURVEYING, S.C.
SURVEYING & SUBDIVIDING
DELAVER, WISCONSIN 53115

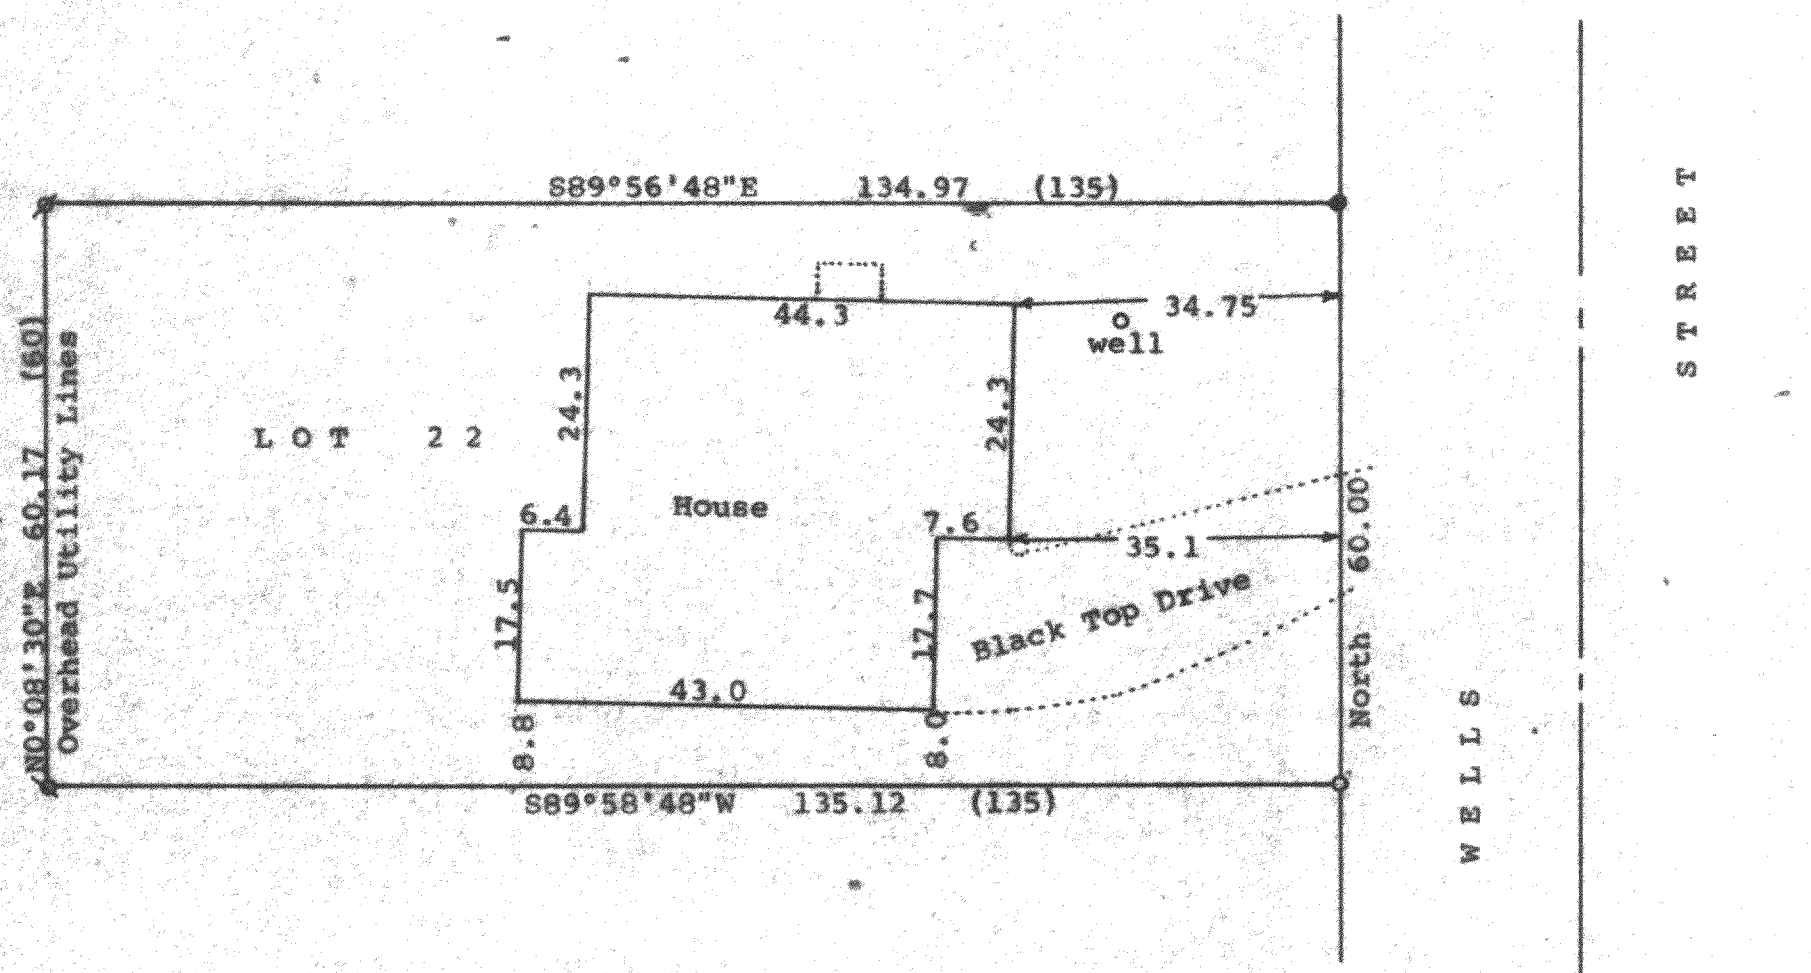

Scale - 1" = 20'
 ⦿ = 3/4" Iron Pipe Found
 ◐ = 1 1/2" Iron Pipe Found
 ○ = 1" Iron Pipe Found down 1'
 1 1/2" Iron Pipe Set over it at ground surface
 (0.00) = recorded distance
 Bearings referenced to the assumed bearing of North along the west line of Wells St.
 Survey ordered by:
 Edward F. Thompson
 Attorney at Law
 Clair Law Offices, S.C.
 Delavan, WI 53115
 ● = 2" Iron Pipe found over 1" iron pipe. Removed 2" and straightened 1"

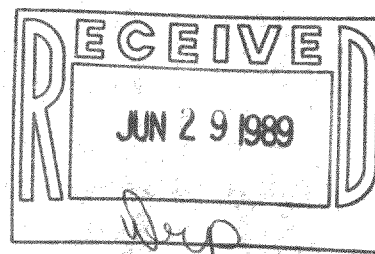

STATE OF WISCONSIN)
COUNTY OF WALWORTH) SS

I, George T. Dunham, Surveyor, certify that I have surveyed the property described as follows:

Lot 22 in Block 15, Delmar, a subdivision located in Section 27, T 2 N, R 16 E, Walworth County, Wisconsin, and that the plat shown hereon is a correct representation thereof and shows the size and location of the property, its exterior boundaries, the location of all visible structures and dimensions of all principal buildings thereon, boundary fences, apparent easements, roadways and visible encroachments, if any, and that I have surveyed the property hereon described, according to the official records, to the best of my knowledge and belief.
May 23, 1989

George T. Dunham
George T. Dunham, Surveyor

216-1179

