



DUNHAM SURVEYING, S.C.
 SURVEYING & SUBDIVIDING
 DELAVAN, WISCONSIN 53115

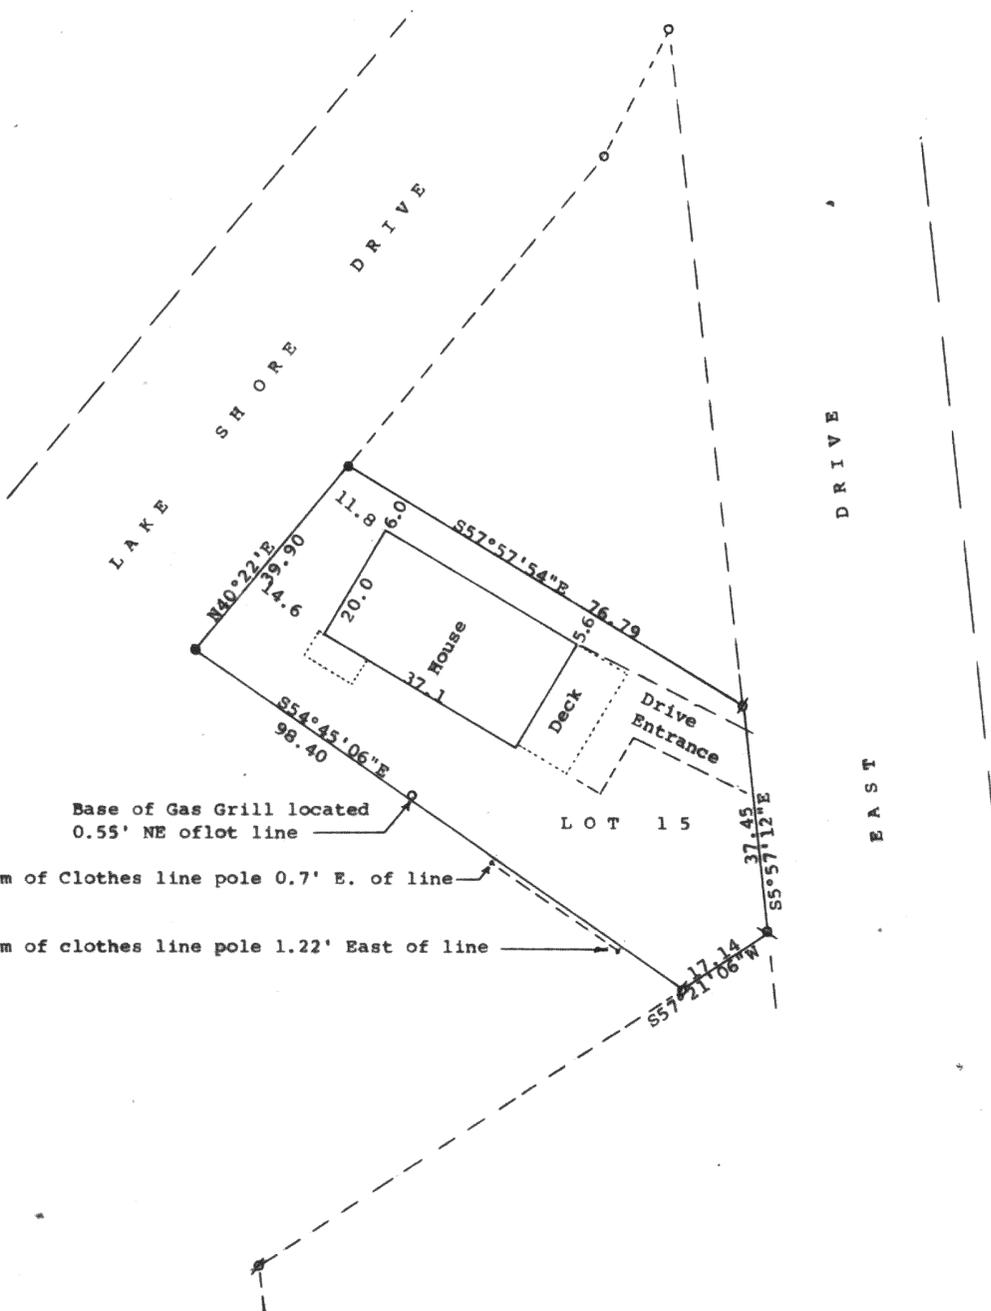

Scale - 1" = 20'
 ● = Iron Pipe Found 1'+ below ground
 Set 1 1/4" X 24" above at ground level
 ⌀ = 3/4" Iron Pipe Found
 ◻ = 1" Iron Pipe Found
 ○ = Iron Pipe Found. Size not noted
 Bearings referenced to the assumed bearing of
 N40°22'E along the northerly line of Lot 15
 Survey ordered by: Realty World, Carmin Realtors
 811 East Geneva Street
 Delavan, WI 53115

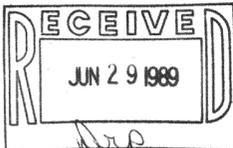

STATE OF WISCONSIN) SS
 COUNTY OF WALWORTH)

I, George T. Dunham, Surveyor, certify that I have surveyed the property described as follows:
 Lot 15 in Block 1 of South Shore Manor, a subdivision located in Section 32, T 2 N, R 16 E, Walworth County, Wisconsin,
 and that the plat shown hereon is a correct representation thereof and shows the size and location of the property, its exterior boundaries, the location of all visible structures and dimensions of all principal buildings thereon, boundary fences, apparent easements, roadways and visible encroachments, if any, and that I have surveyed the property hereon described, according to the official records, to the best of my knowledge and belief.
 June 21, 1989

George T. Dunham
 George T. Dunham, Surveyor

216-1180

