



DUNHAM SURVEYING, S.C.
 SURVEYING & SUBDIVIDING
 DELAVAN, WISCONSIN 53115

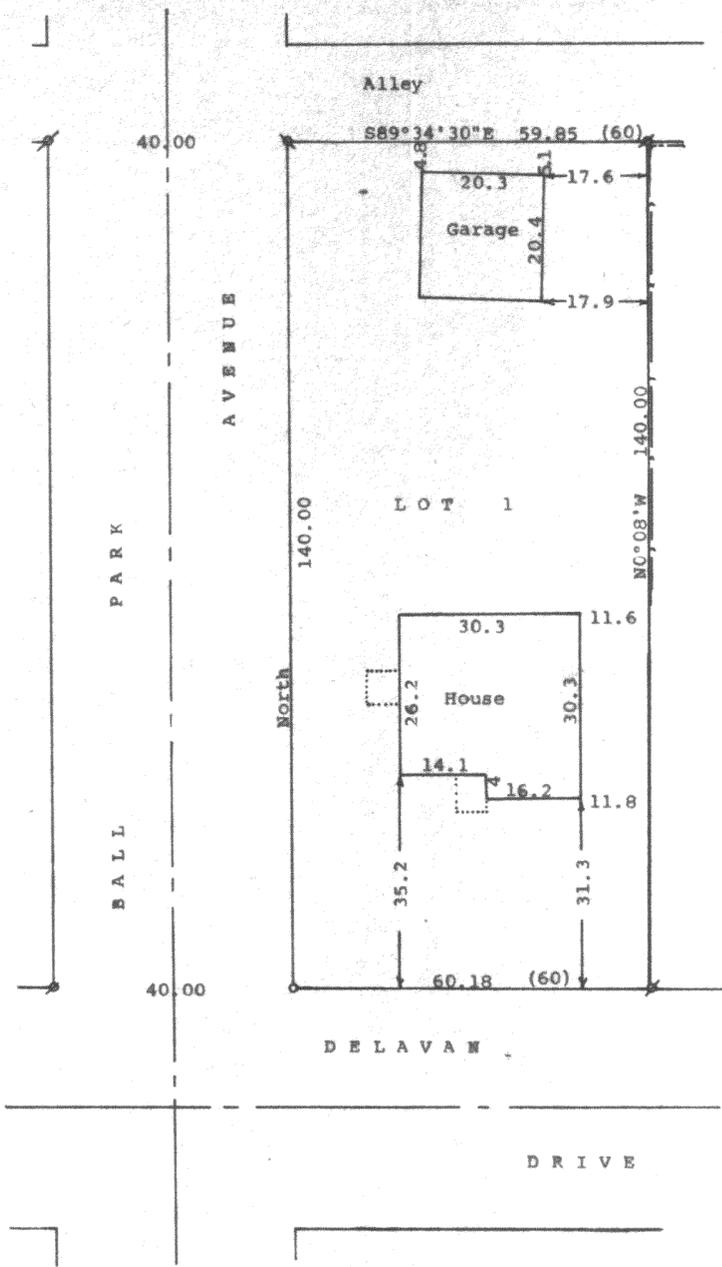

Scale - 1" = 20'
 # = 3/4" Iron Pipe Found
 o = 3/4" X 24" Iron Pipe Set
 R = 1/2" X 24" Iron Pipe Set
 --- = Fence Line
 Bearings referenced to the east line of Ball Park Avenue with the assumed bearing of North
 Survey ordered by:
 Ed Clair
 Attorney at Law
 Delavan, WI 53115
 (00.00) = recorded distance

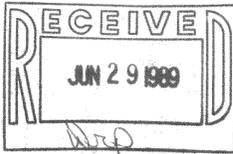

STATE OF WISCONSIN) SS
 COUNTY OF WALWORTH)

I, George T. Dunham, Surveyor, certify that I have surveyed the property described as follows:

Lot 1 in Block 4., Inlet Oaks Subdivision No. 4, located in Section 15, T 2 N, R 16 E, Walworth County, Wisconsin

and that the plat shown hereon is a correct representation thereof and shows the size and location of the property, its exterior boundaries, the location of all visible structures and dimension of all principal buildings thereon, boundary fences, apparent easements, roadways and visible encroachments, if any, and that I have surveyed the property hereon described, according to the official records, to the best of my knowledge and belief.

March 13, 1989

George T. Dunham
 George T. Dunham, Surveyor

216-1182

