



DUNHAM SURVEYING, S. C.
SURVEYING & SUBDIVIDING
DELAVER, WISCONSIN 53115



Scale - 1" = 20'
● = 1" Iron Pipe Found
○ = 3/4" Iron Pipe Found
⊗ = 1/2" X 24" Iron Pipe Set
○ = 3/4" Iron Pipe Set

Bearings referenced to the assumed bearing of N65°38'E along the northerly line of Lots 28 and 29.

Survey ordered by:
Michael Besch
4054 Oriole
Norridge, IL 60634

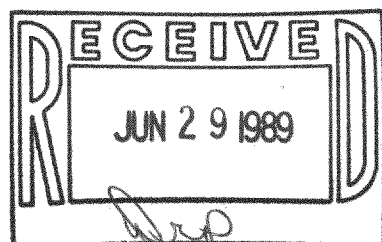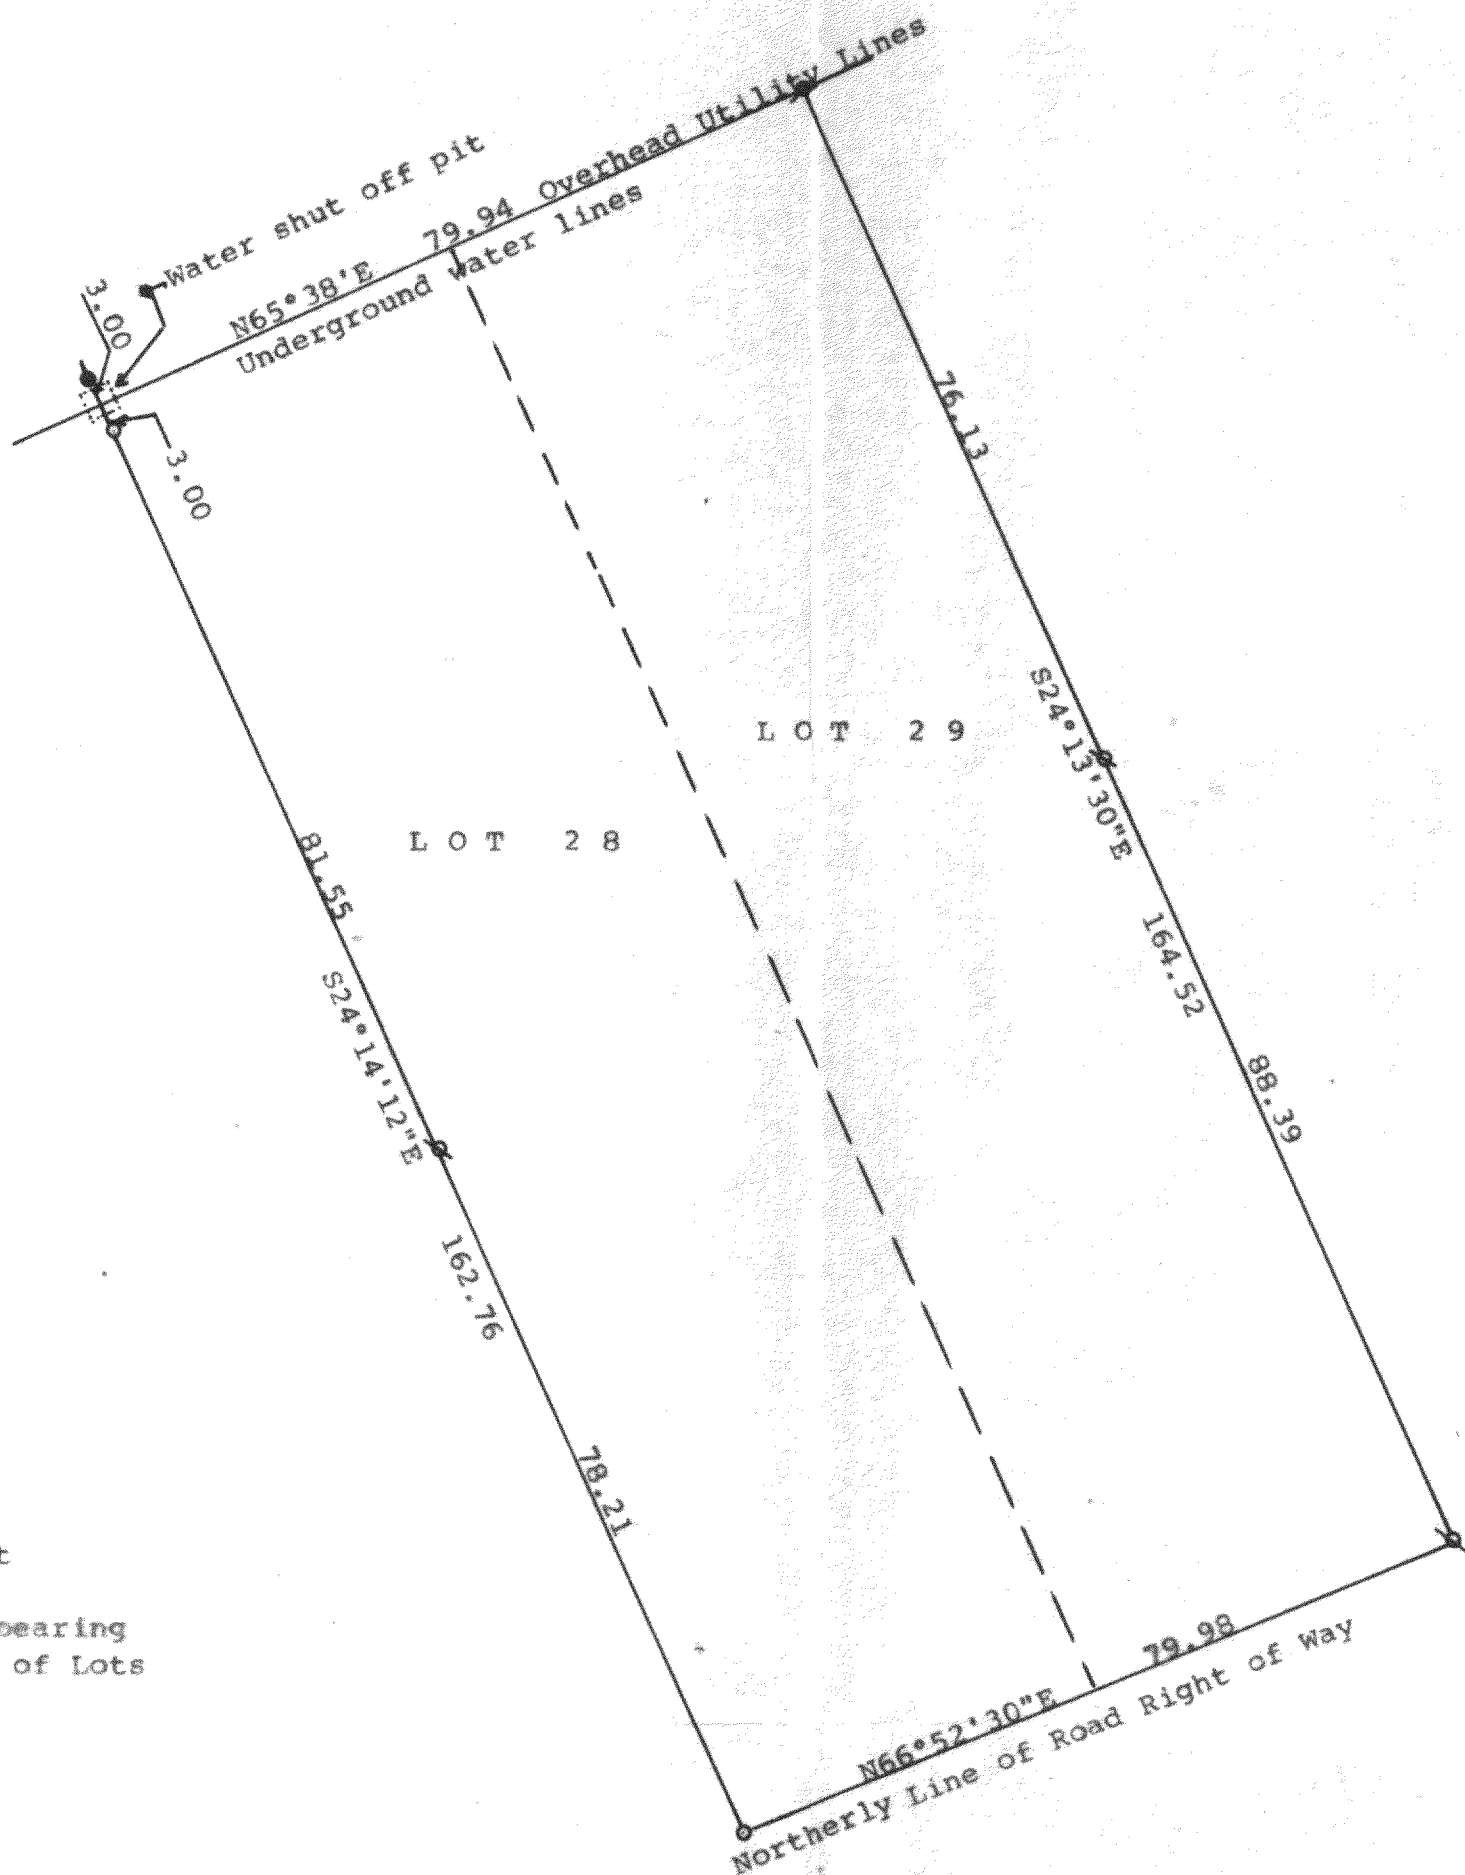

STATE OF WISCONSIN) SS
COUNTY OF WALWORTH)

I, George T. Dunham, Surveyor, certify that I have surveyed the property described as follows:

Lots 28 and 29 in Block 19 of Delavan Lake View Crest, a subdivision located in Section 31, T 2 N, R 16 E, Walworth County, Wisconsin, and that the plat shown hereon is a correct representation thereof and shows the size and location of the property, its exterior boundaries, the location of all visible structures and dimensions of all principal buildings thereon, boundary fences, apparent easements, roadways and visible encroachments, if any, and that I have surveyed the property hereon described, according to the official records, to the best of my knowledge and belief.
November 8 and 9, 1988

George T. Dunham
George T. Dunham, Surveyor
216-1189

