

ABELL  
SURVEYING & MAPPING  
DELAVER, WISCONSIN 53115  
414-728-6787

PLAT OF SURVEY OF

LOT 37, BLOCK 7, INLET OAKS SUBDIVISION NO. 4,  
LOCATED IN SECTION 15, T2N, R16E, WALWORTH COUNTY,  
WISCONSIN.

ORDERED BY: KEEFE REAL ESTATE  
704 MAIN STREET  
LAKE GENEVA, WI. 53147

EAVES AND GUTTER EXTEND 1.7' FROM HOUSE,  
GUTTER EXTENDS 0.4' OVER LOT LINE.

HOUSE

GRAVEL

DRIVE

0.16 ACRES

BLOCK


FOUND IRON PIPE 0.93' N.E. OF  
CORNER ON LINE



SCALE - 1"=20'

LEGEND

- Ø - IRON PIPE FOUND
- - IRON ROD SET
- ( ) - RECORDED AS

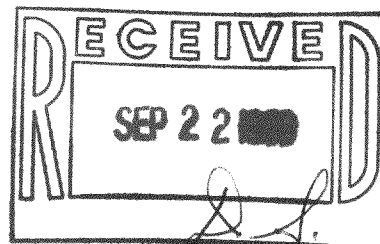

I HEREBY CERTIFY THAT I HAVE SURVEYED THE ABOVE  
DESCRIBED PROPERTY AND THAT THE ABOVE MAP IS A  
TRUE REPRESENTATION THEREOF AND SHOWS THE SIZE  
AND LOCATION OF THE PROPERTY, ITS EXTERIOR  
BOUNDARIES, THE LOCATION OF ALL VISIBLE STRUCTURES  
AND DIMENSIONS OF ALL PRINCIPAL BUILDINGS THEREON,  
BOUNDARY FENCES, APPARENT EASEMENTS, ROADWAYS AND  
VISIBLE ENCROACHMENTS, IF ANY, TO THE BEST OF MY  
KNOWLEDGE AND BELIEF.  
THIS SURVEY IS MADE FOR THE USE OF THE PRESENT  
OWNERS OF THE PROPERTY, AND ALSO THOSE WHO  
PURCHASE, MORTGAGE, OR GUARANTEE THE TITLE THERETO  
WITHIN ONE (1) YEAR FROM THE DATE HEREOF.

*David F. Abell*  
DAVID F. ABELL  
WISCONSIN REGISTERED LAND SURVEYOR, S-1596

*August 10, 1989*  
DATE JOB NUMBER - 89163  
NOTE: THIS IS NOT A CERTIFIED COPY UNLESS SEALED.