
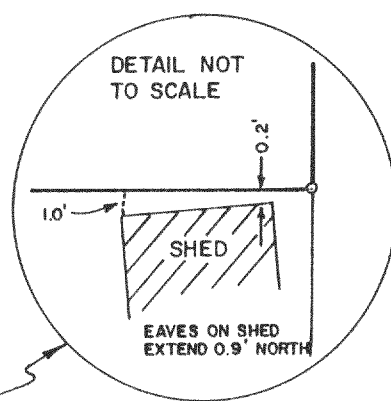
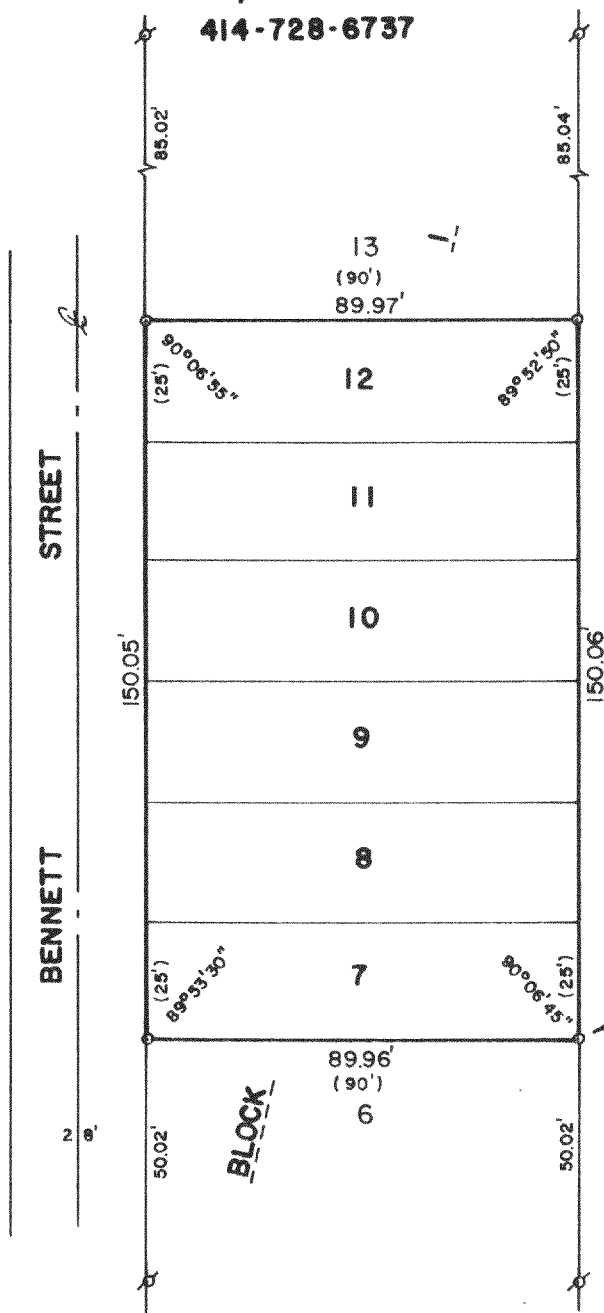


ABELL
SURVEYING & MAPPING
DELAVER, WISCONSIN 53115
414-728-6737

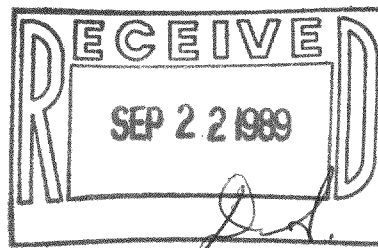

PLAT OF SURVEY OF

LOTS 7-12, BLOCK 1 OF ROBBINS SUBDIVISION LOCATED
IN SECTION 32, T2N, R16E, WALWORTH COUNTY, WISCONSIN.

ORDERED BY: TED GAMRAT
4444 TRAILSIDE COURT
HOFFMAN ESTATES, IL. 60195



SCALE - 1"=40'

LEGEND

- ⊗ - IRON PIPE FOUND
- - IRON ROD SET
- () - RECORDED AS

I, DAVID F. ABELL, DO HEREBY CERTIFY
THAT I HAVE SURVEYED THE PROPERTY
HEREON DESCRIBED ACCORDING TO THE
OFFICIAL RECORDS AND THAT THE PLAT
HEREON IS A CORRECT REPRESENTATION
OF THE PROPERTY LINES TO THE BEST OF
MY KNOWLEDGE AND BELIEF.

David F. Abell

DAVID F. ABELL
WISCONSIN REGISTERED LAND SURVEYOR, S-1596

June 22, 1989

DATE JOB NUMBER - 89111

NOTE: THIS IS NOT A CERTIFIED COPY UNLESS SEALED.

FRO - 4

T-5 FLOWING

216-1215