

Farris, Hansen & Associates, Inc.

7 RIDGEWAY COURT, P.O. BOX 437, ELKHORN, WISCONSIN

TEL. 414-723-2098

LOCATION: GENEVA WEST ESTATES-LOT 20
DELAVAN TOWNSHIP, WALWORTH CO., WIS.

MAP LEGEND


- IRON PIPE STAKE FOUND
- IRON PIPE STAKE SET
- IRON ROD STAKE FOUND
- IRON ROD STAKE SET
- CONCRETE MONUMENT FOUND
- (XXXXX) RECORD DIMENSION

WORK ORDERED BY: SUPERB BUILDERS

MAP SCALE IN FEET



NOTE: THIS SURVEY AND ITS CERTIFICATE BASED SOLELY UPON INFORMATION SHOWN ON THE ORIGINAL SUBDIVISION PLAT FOR GENEVA WEST ESTATES RECORDED IN THE OFFICE OF THE REGISTER OF DEEDS FOR WALWORTH COUNTY WISCONSIN ON MAY 18, 1988 IN CABINET B, SLIDE 84 & 85 AS DOCUMENT NO. 162316. USERS OF THIS PLAT MUST DETERMINE IF ANY SUBSEQUENT DOCUMENTS AFFECT TITLE TO THE SUBJECT LOT.

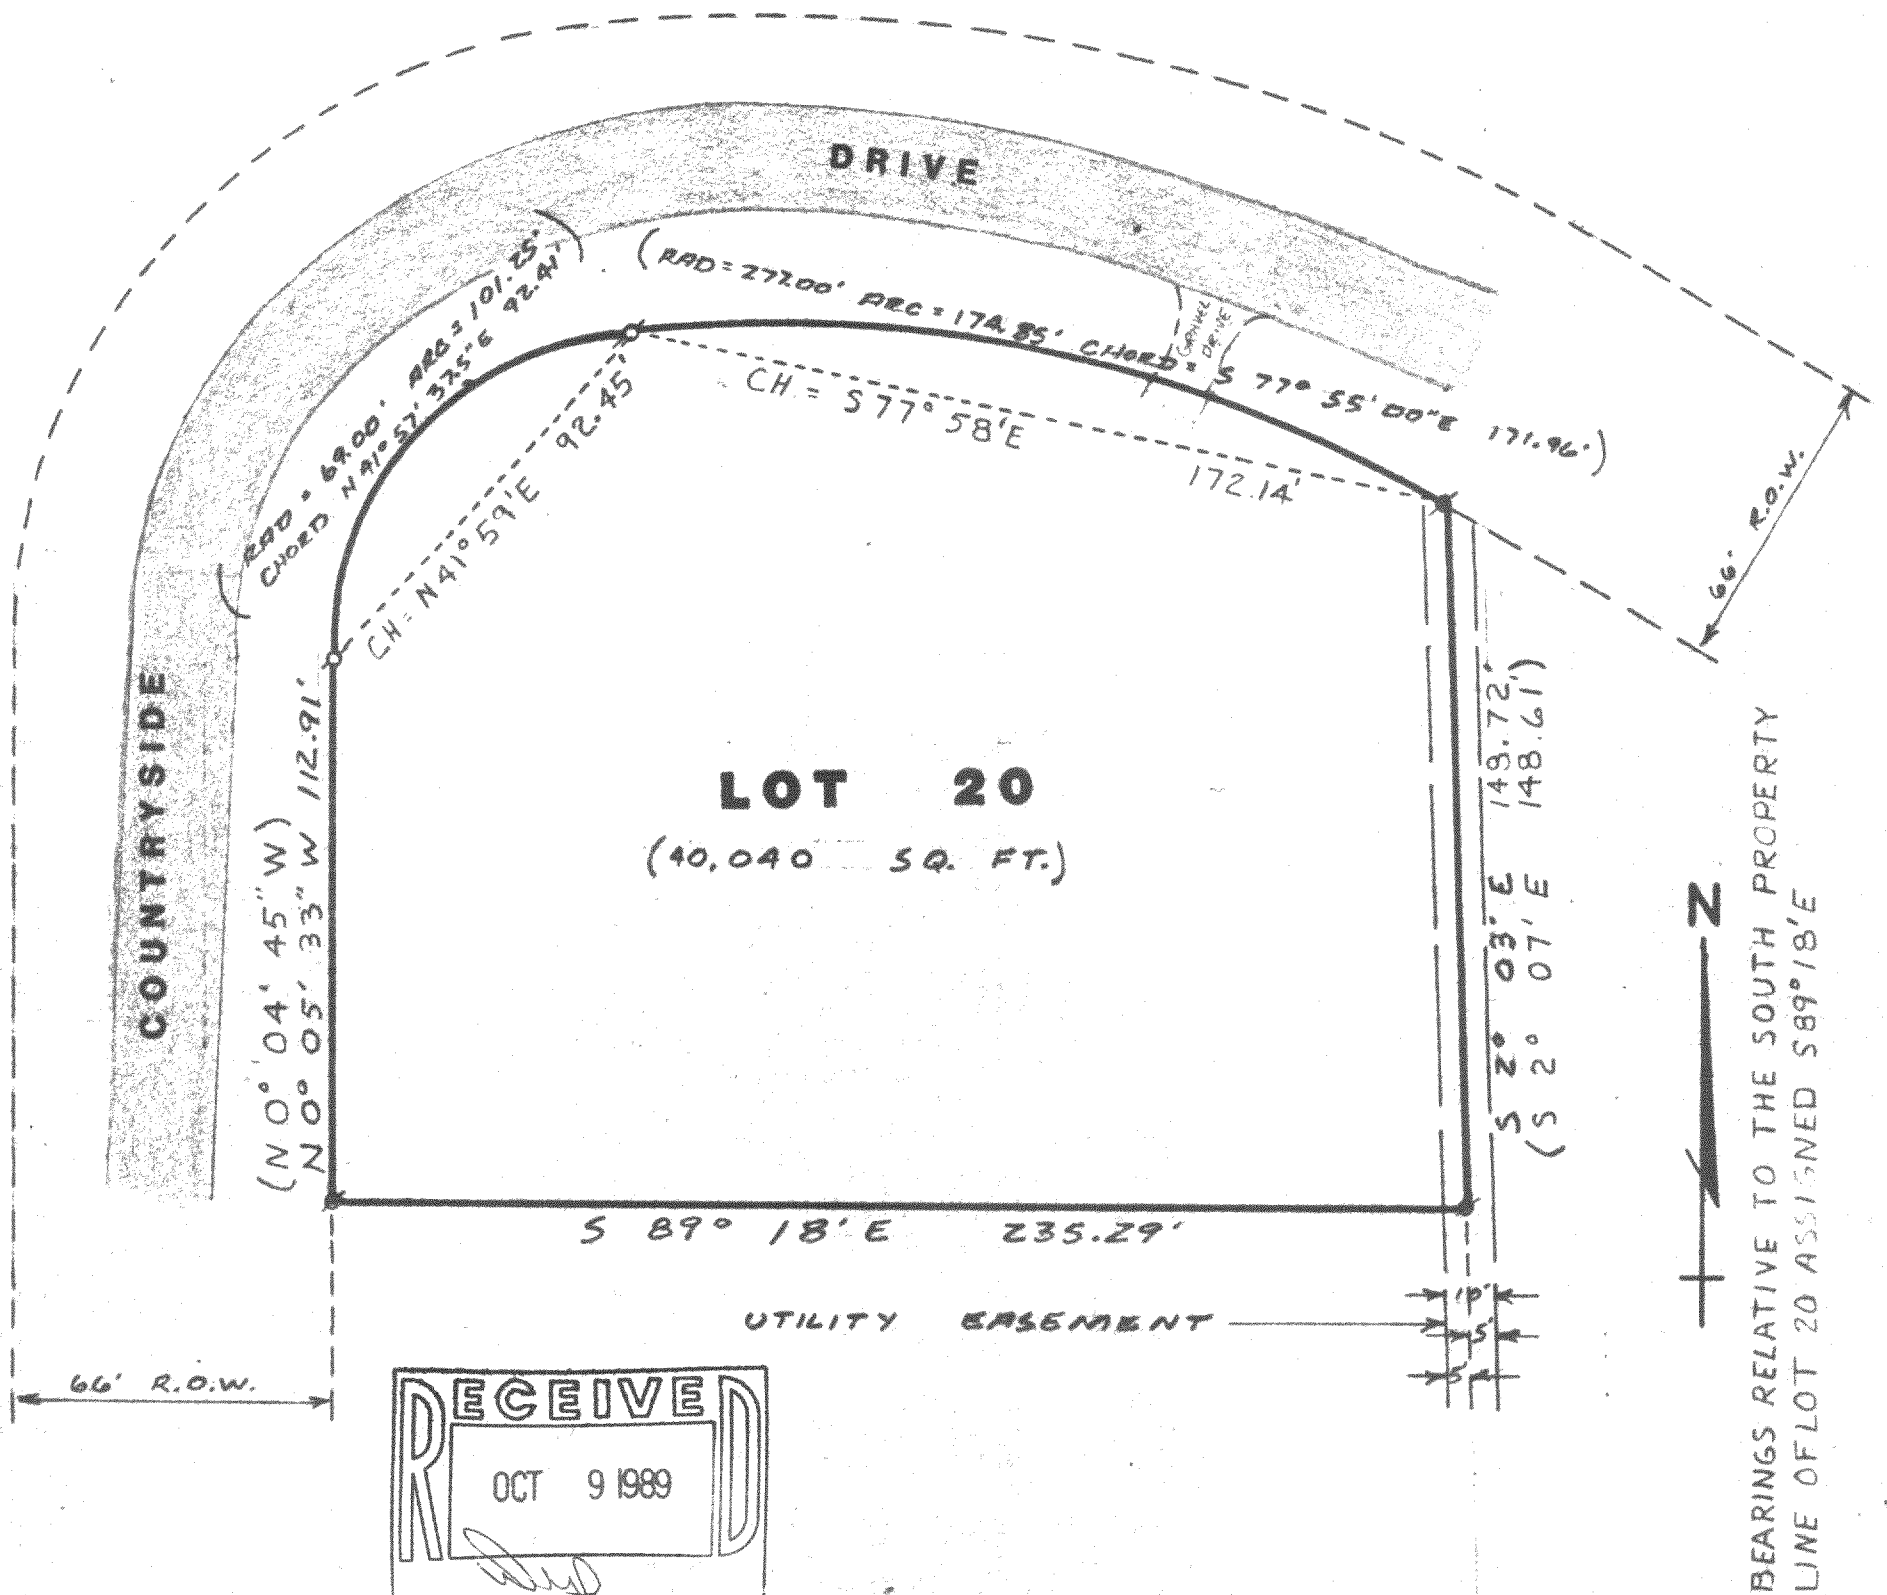


NOTE: COPIES OF THIS MAP TO WHICH THE FOLLOWING CERTIFICATE WILL APPLY ARE BLUE LINE PRINTS SHOWING SURVEYOR'S SEAL AND SIGNATURE IN BLACK INK. COPIES BY ANY OTHER MEANS MAY HAVE ALTERATIONS WHICH DO NOT REPRESENT THE SURVEYOR'S WORK PRODUCT.

I hereby certify that the above described property has been surveyed under my direction and that the above map is a true representation thereof and shows the size and location of the property, its exterior boundaries, the location of all visible structures and dimensions of all principal buildings thereon, boundary fences, apparent easements, roadways and visible encroachments, if any. This survey is made for the use of the present owners of the property, and also those who purchase, mortgage, or guarantee the title thereto within one year from the date hereof.

DATED: 7/24/89

Robert A. Farris

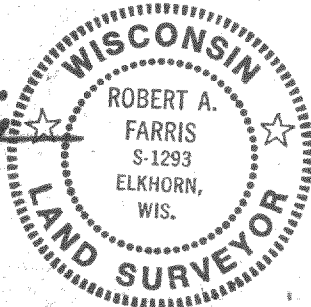

PROJ. NO. 1686.20

FGEW-20