


ABELL
SURVEYING & MAPPING
 DELAVAN, WISCONSIN 53115
 414-728-6787

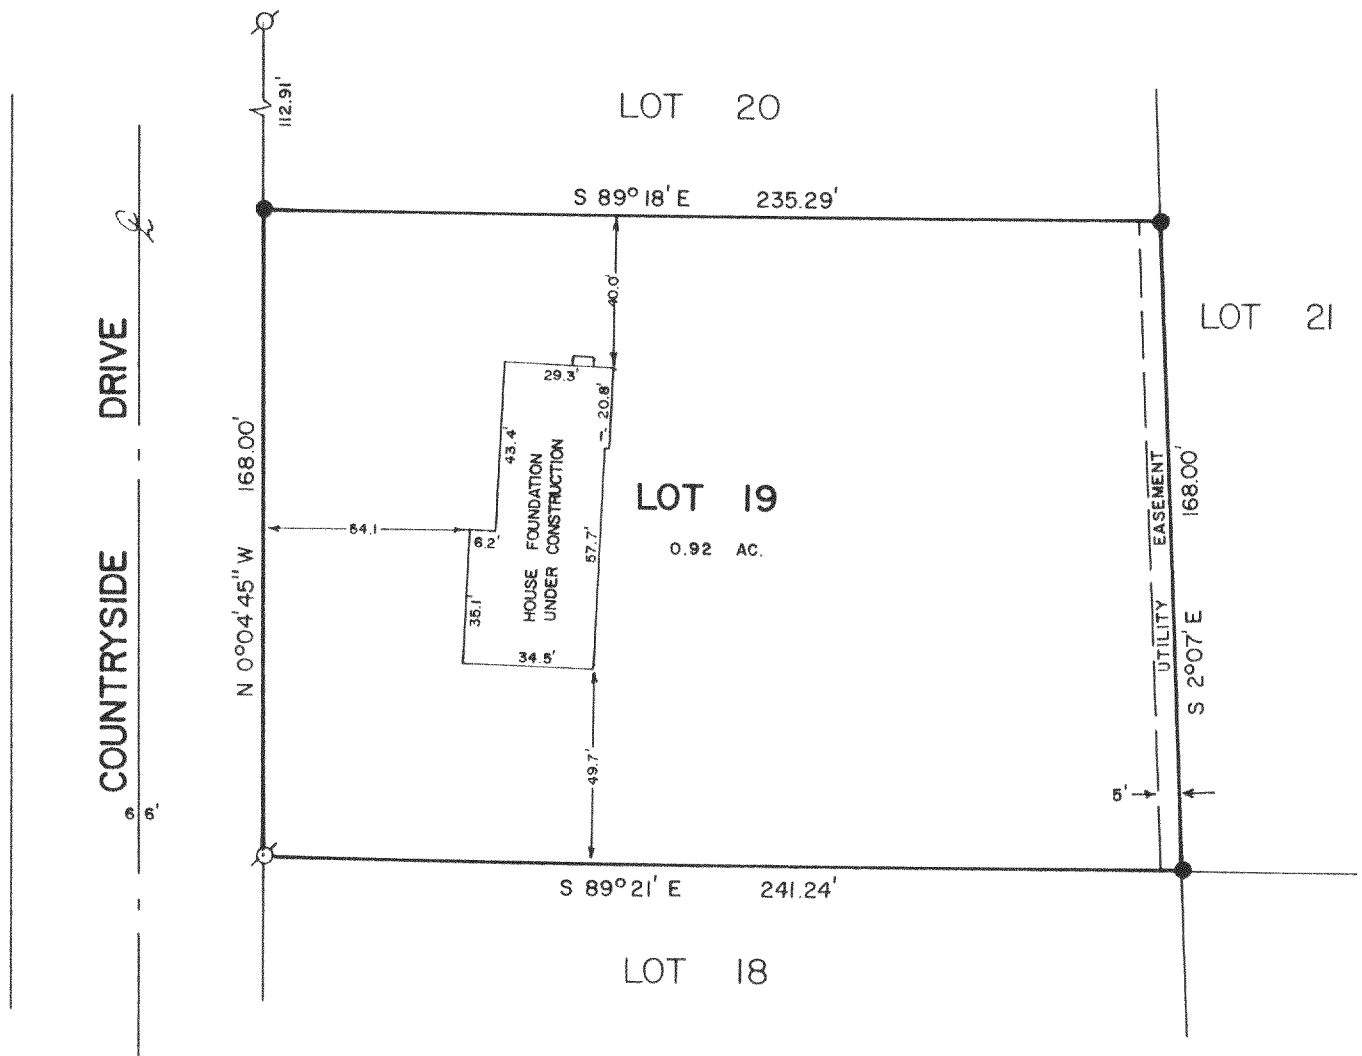

PLAT OF SURVEY OF

LOT 19 OF GENEVA WEST ESTATES, A SUBDIVISION LOCATED
 IN THE SOUTHEAST 1/4 OF SECTION 25, T2N, R16E,
 WALWORTH COUNTY, WISCONSIN.

ORDERED BY: SUPERB REALTY
 ROUTE 2, BOX 249B
 ELKHORN, WI. 53121

NOTE: THE BEARINGS ARE AS SHOWN ON THE SUBDIVISION
 PLAT OF GENEVA WEST ESTATES.


REVISED: DECEMBER 13, 1989 TO SHOW LOCATION OF
 HOUSE FOUNDATION.



SCALE - 1"=50'

LEGEND

- - IRON PIPE FOUND
- - IRON ROD FOUND

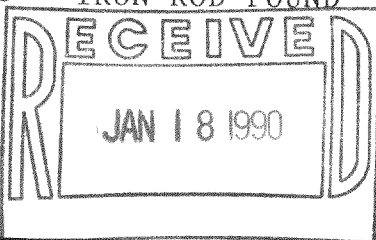

I HEREBY CERTIFY THAT I HAVE SURVEYED THE ABOVE DESCRIBED PROPERTY AND THAT THE
 ABOVE MAP IS A TRUE REPRESENTATION THEREOF AND SHOWS THE SIZE AND LOCATION OF
 THE PROPERTY, ITS EXTERIOR BOUNDARIES, THE LOCATION OF ALL VISIBLE STRUCTURES
 AND DIMENSIONS OF ALL PRINCIPAL BUILDINGS THEREON, BOUNDARY FENCES, APPARENT
 EASEMENTS, ROADWAYS AND VISIBLE ENCROACHMENTS, IF ANY, TO THE BEST OF MY
 KNOWLEDGE AND BELIEF.

THIS SURVEY IS MADE FOR THE USE OF THE PRESENT OWNERS OF THE PROPERTY, AND ALSO
 THOSE WHO PURCHASE, MORTGAGE, OR GUARANTEE THE TITLE THERETO WITHIN ONE (1) YEAR
 FROM DATE HEREOF.

David F. Abell
 DAVID F. ABELL
 WISCONSIN REGISTERED LAND SURVEYOR, S-1596

DATE *August 30, 1989* JOB NUMBER - 89185
 NOTE: THIS IS NOT A CERTIFIED COPY UNLESS SEALED.

FGEW-19