

Farris, Hansen & Associates, Inc.

7 RIDGEWAY COURT, P.O. BOX 437, ELKHORN, WISCONSIN


TEL. 414-723-2098

LOCATION: BLOCK A, JACKSON'S SUB.
SEC. 21-2-16 WALWORTH CO., WI.

WORK ORDERED BY: RICHARD FIELD

MAP LEGEND

- O = IRON PIPE STAKE FOUND IN 1982
- Ø = IRON PIPE STAKE SET IN 1982
- = IRON ROD STAKE FOUND
- = IRON ROD STAKE SET
- = CONCRETE MONUMENT FOUND
- (XXXXX) = RECORD DIMENSION

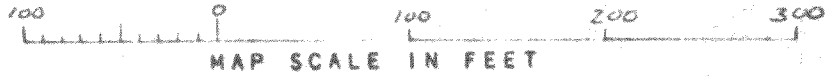

167564

WARRANTY DEED
VOL 438 PAGE 957

REC'D IN VOL 438
957

This Deed, made between Terry R. Bennett and
Jean L. Bennett

Grantor,
and Richard V.D. Field and Barbara P. Field,
his wife, as survivorship marital property

SEP 2 AM 11 10

WISCONSIN
WALWORTH CO.

Witnesseth, That the said Grantor, for a valuable consideration.....

conveys to Grantee the following described real estate in Walworth
County, State of Wisconsin:

SECURITY TITLE COMPANY 4.00
RETURN TO: 25 NORTH WISCONSIN ST.
ELKHORN WISCONSIN 53121
38626

Tax Parcel No: FJS 00002 and
FJS 00009


PARCEL 1: Lot No. 4 and the East 1/2 of Lot No. 5 and the West 9 feet of Lot No. 3 all in Block A of Jackson's Subdivision of Lots 5 and 6 of Mabiewood, and being a part of Section 21, Town 2 North, Range 16 East, Walworth County, Wisconsin, together with right of way of Block D of Jackson's Subdivision.

PARCEL 2: An undivided 1/2 interest in and to the East 2/3rds of Lot 19 of Block "A" of Jackson's Subdivision of Lots 5 and 6 of Mabiewood, according to the recorded plat thereof in Volume 5 of Plats on page 226 in the office of the Register of Deeds of Walworth County, Wisconsin.

Legal Description of
Land Surveyed



N

DATA BELOW FROM NOTES OF SURVEY IN 1982
IN BLOCK A

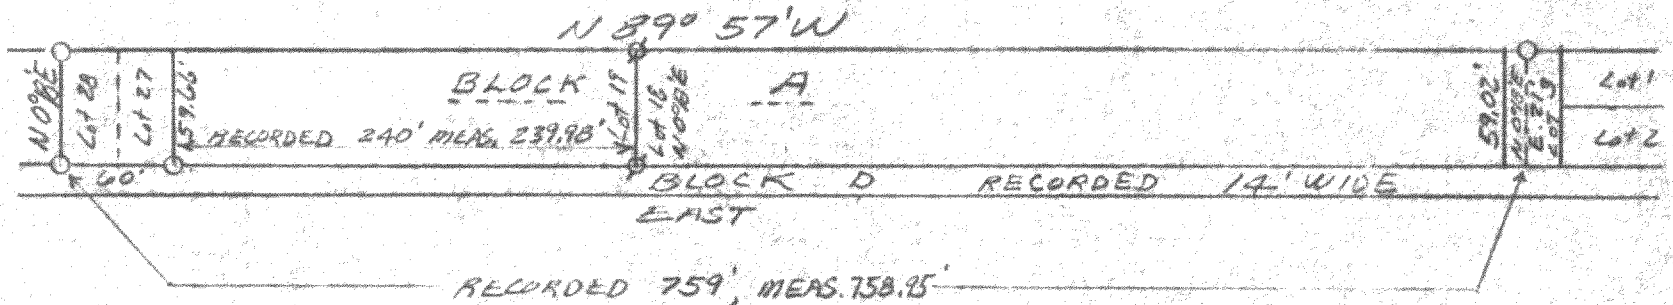

I hereby certify that at the direction of Richard Field, the land described above has been surveyed under my direction and that this PLAT OF SURVEY is a true representation thereof and shows the size and location of the property, its exterior boundaries, fences and all principal buildings thereon.

Note: Copies of this map to which the certificate will apply are blue line prints showing the surveyor's original seal and signature in black ink. Copies by any other means may have alterations which do not represent the surveyor's work product.

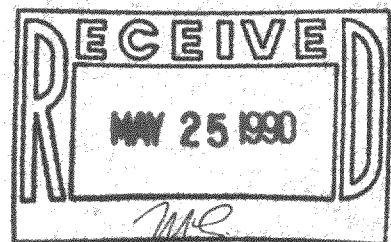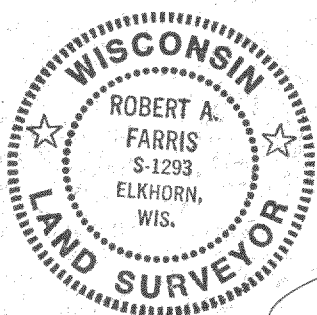

DATED: 7/19/89


PROJ. NO. 3268

FJS-2
FJS-9
FJS-10

SHEET 1 OF 2 SHEETS

216-1248

Detail of East $\frac{2}{3}$ Lot 19 Block A, Jackson's Sub.
 Loc. in SE $\frac{1}{4}$ Sec. 21, T. 2 N., R. 16 E., Walworth Co., Wi.
 N 89° 57' W

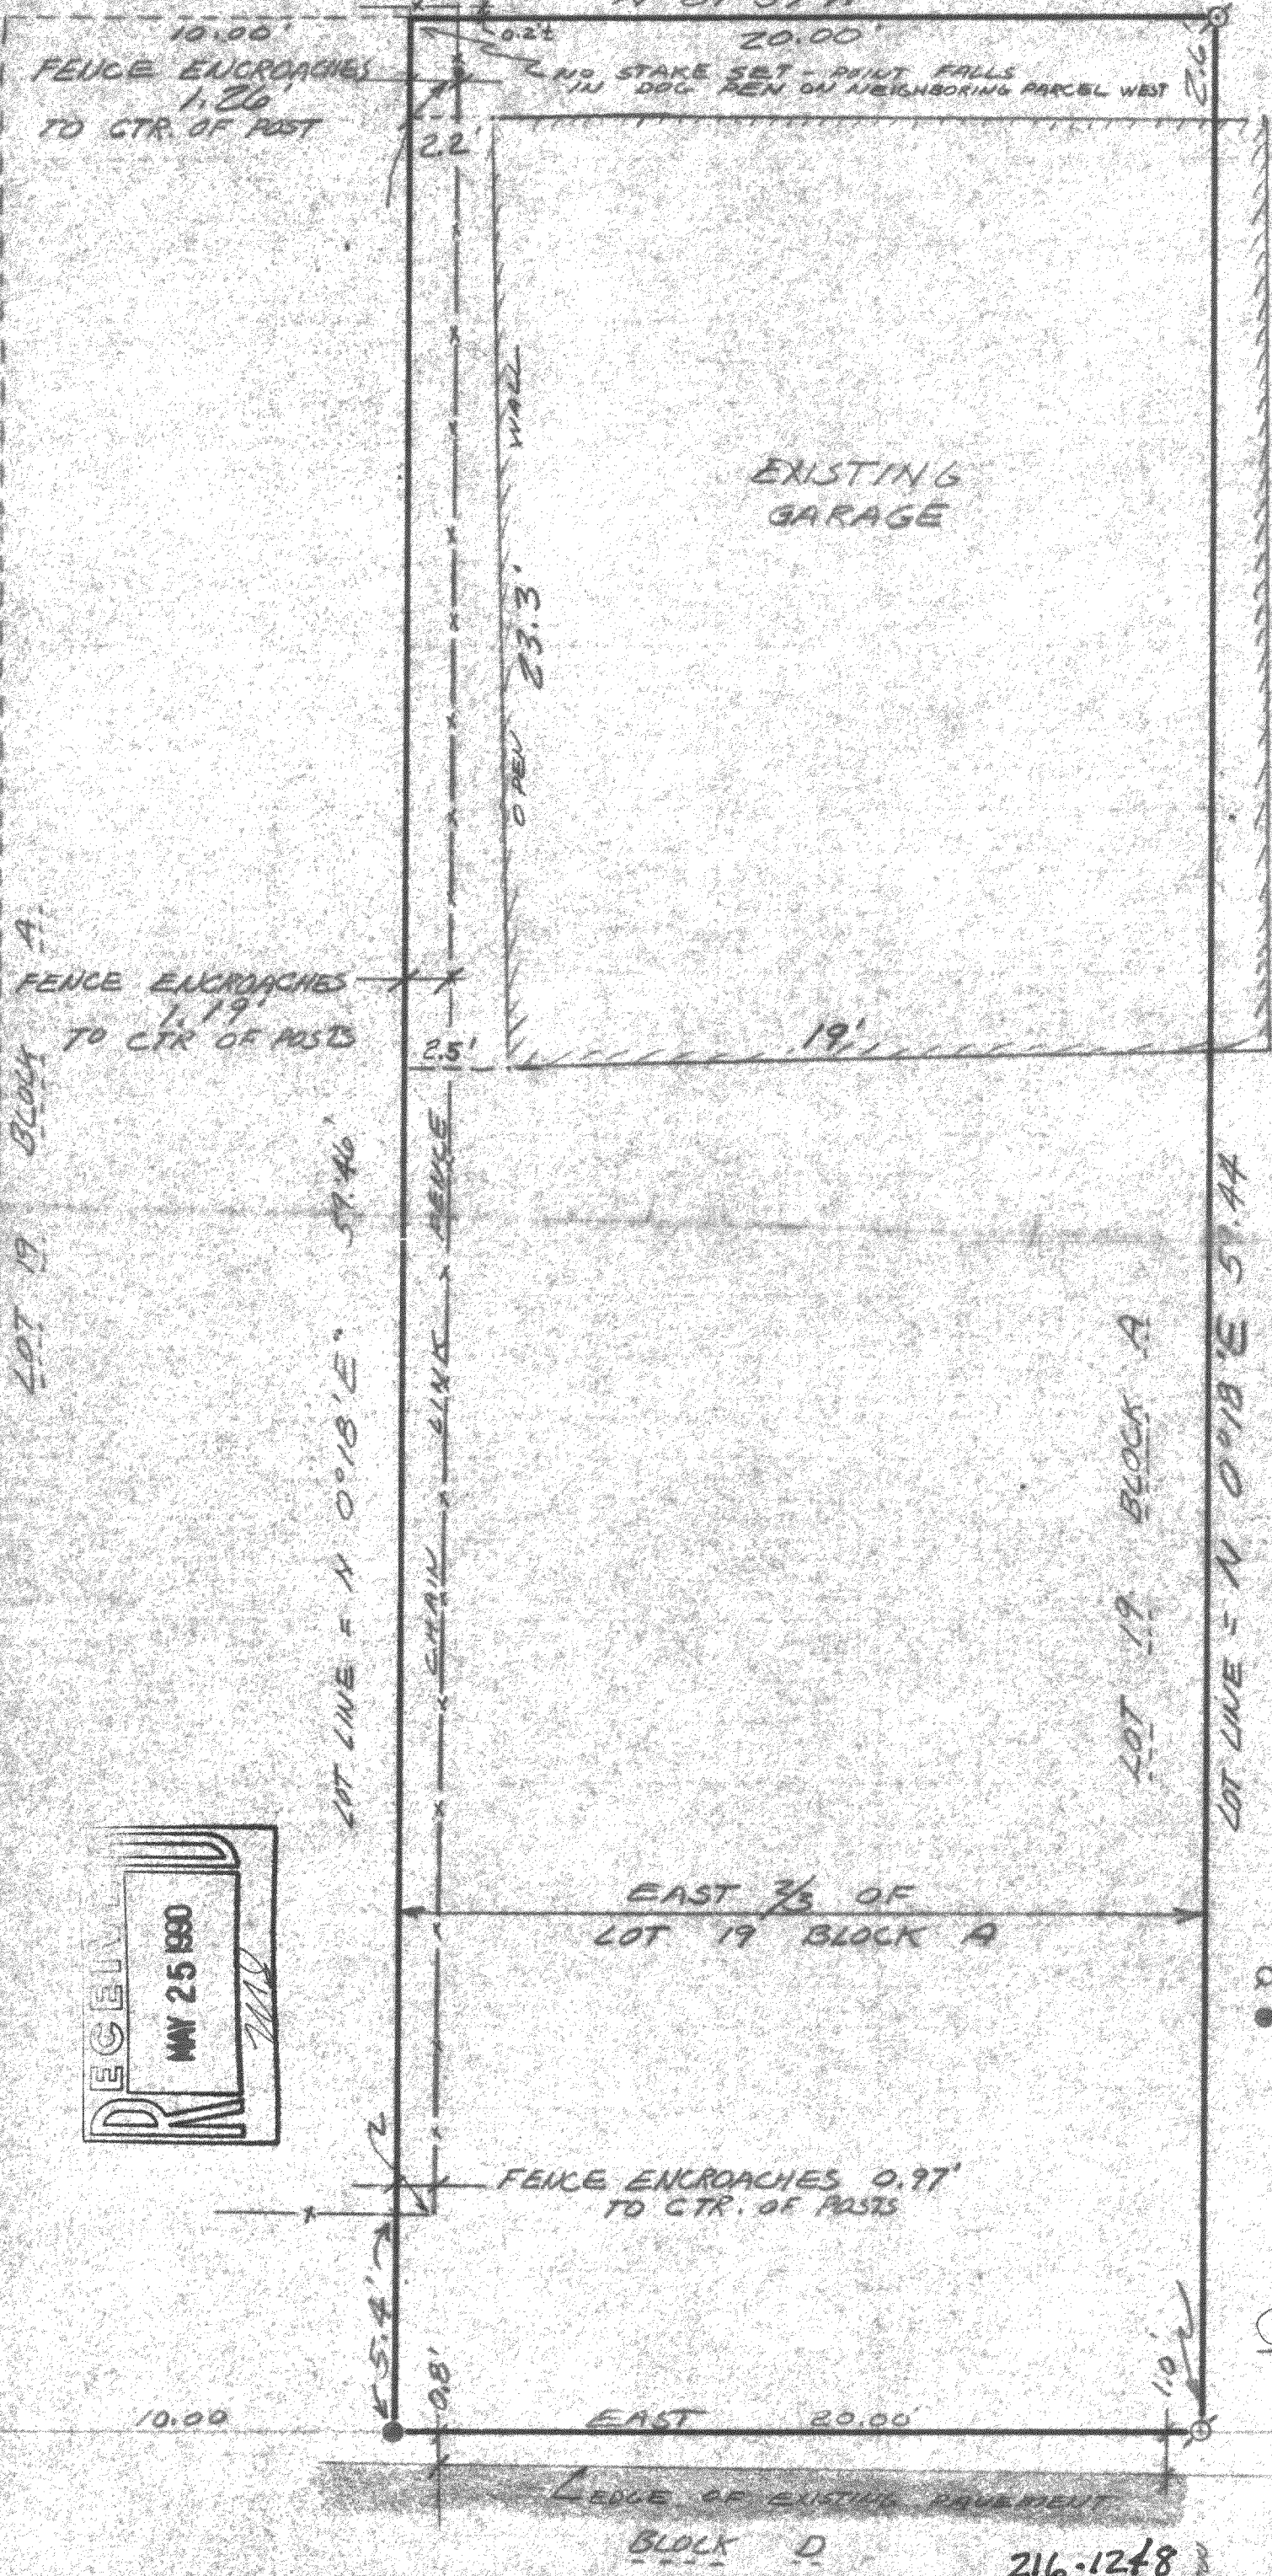

NOTES: COPIES OF THIS MAP TO WHICH THE CERTIFICATE SHALL APPLY ARE BLUE LINE PRINTS WITH THE SURVEYORS ORIGINAL SEAL AND SIGNATURE APPEARING IN BLACK INK. COPIES BY ANY OTHER MEANS MAY CONTAIN ALTERATIONS WHICH DO NOT REPRESENT THE SURVEYOR'S WORK PRODUCT.

FARRIS, HANSEN & ASSOCIATES, INC.
 Engineers Architects Surveyors
 7 Ridgeway Court P.O. Box 437
 ELKHORN, WISCONSIN 53121
 Office: (414) 723-2088

North Arrow
 Bearings Relative to the North Line of Block D - East as found to be magnified

○ = 1" IRON PIPE FOUND 1989
 ● = $\frac{3}{4}$ " x 24" IRON REBAR SET 1989

WISCONSIN
 ROBERT A. FARRIS
 S-1293
 ELKHORN, WIS.
 LAND SURVEYOR

Robert A. Farris
 DATED 7/19/89

PROJECT 3268
 FOR
 RICHARD FIELD
 SHEET 2 OF 2

RECEIVED
 MAY 25 1990
 MLC

216-1248