



**ABELL
SURVEYING & MAPPING
DELAVER, WISCONSIN 53115
414-728-6737**

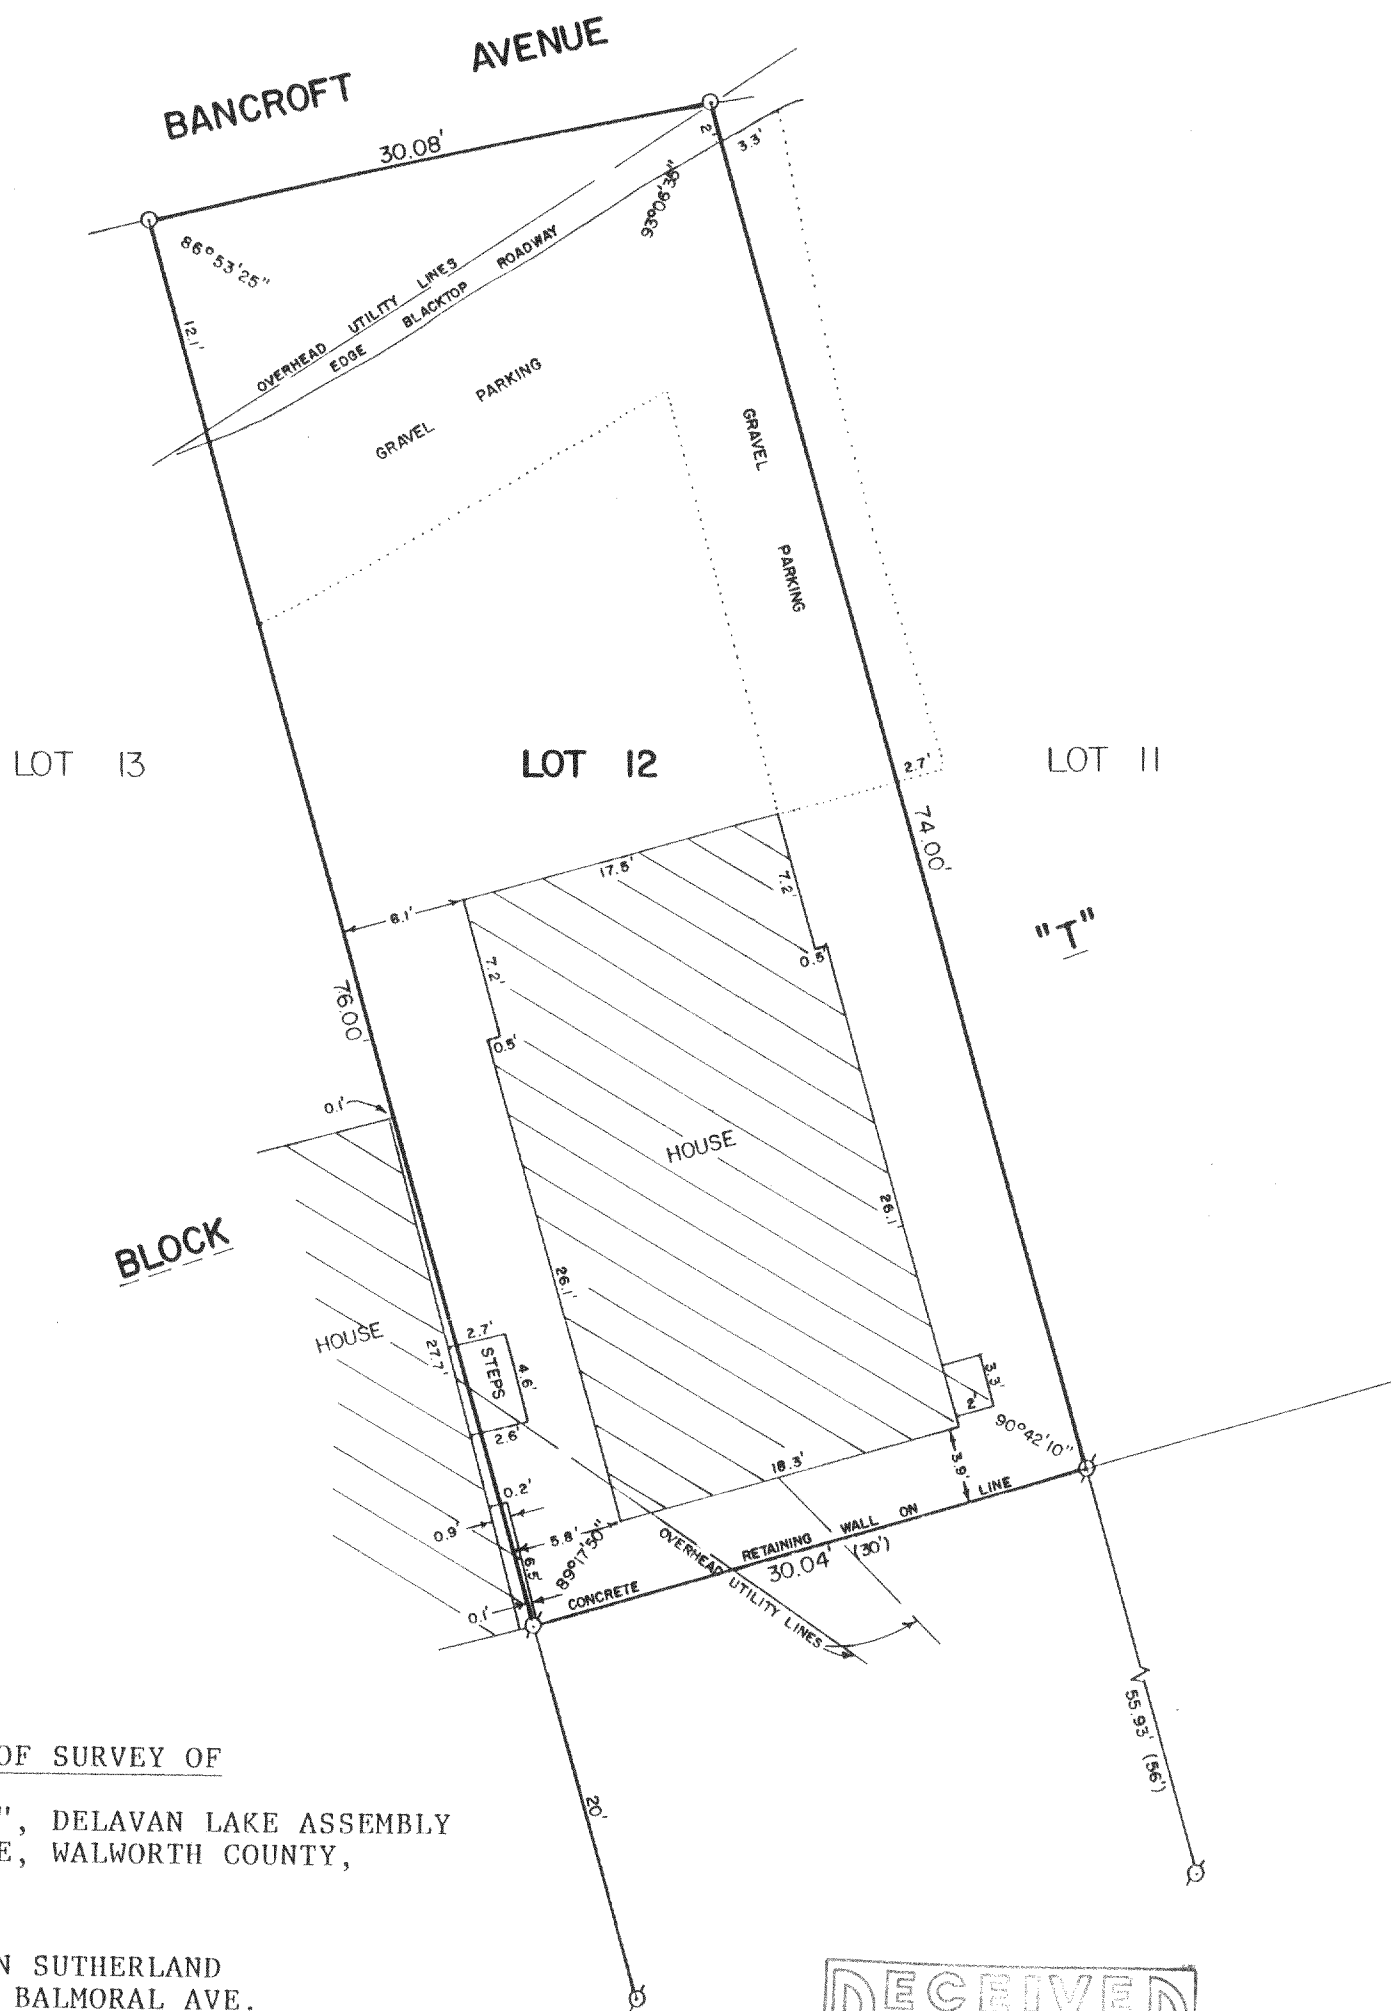

PLAT OF SURVEY OF

LOT 12, BLOCK "T", DELAVAN LAKE ASSEMBLY
GROUNDS, T2N, R16E, WALWORTH COUNTY,
WISCONSIN.

ORDERED BY: JOHN SUTHERLAND
709 BALMORAL AVE.
WEST CHESTER, IL. 60154

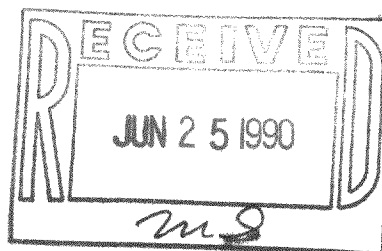

SCALE - 1"=10'

LEGEND

- ⊗ - IRON PIPE FOUND
- - IRON ROD SET IN BLACKTOP ROAD
- () - RECORDED AS

I, DAVID F. ABELL, DO HEREBY CERTIFY
THAT I HAVE SURVEYED THE PROPERTY
HEREON DESCRIBED ACCORDING TO THE
OFFICIAL RECORDS AND THAT THE PLAT
HEREON IS A CORRECT REPRESENTATION
OF THE PROPERTY LINES TO THE BEST OF
MY KNOWLEDGE AND BELIEF.

David F. Abell

DAVID F. ABELL
WISCONSIN REGISTERED LAND SURVEYOR, S-1596

May 23, 1990

DATE - May 23, 1990 JOB NUMBER - 90092
NOTE: THIS IS NOT A CERTIFIED COPY UNLESS SEALED.