


ABELL
SURVEYING & MAPPING
 DELAVAN, WISCONSIN 53115
 414-728-8787

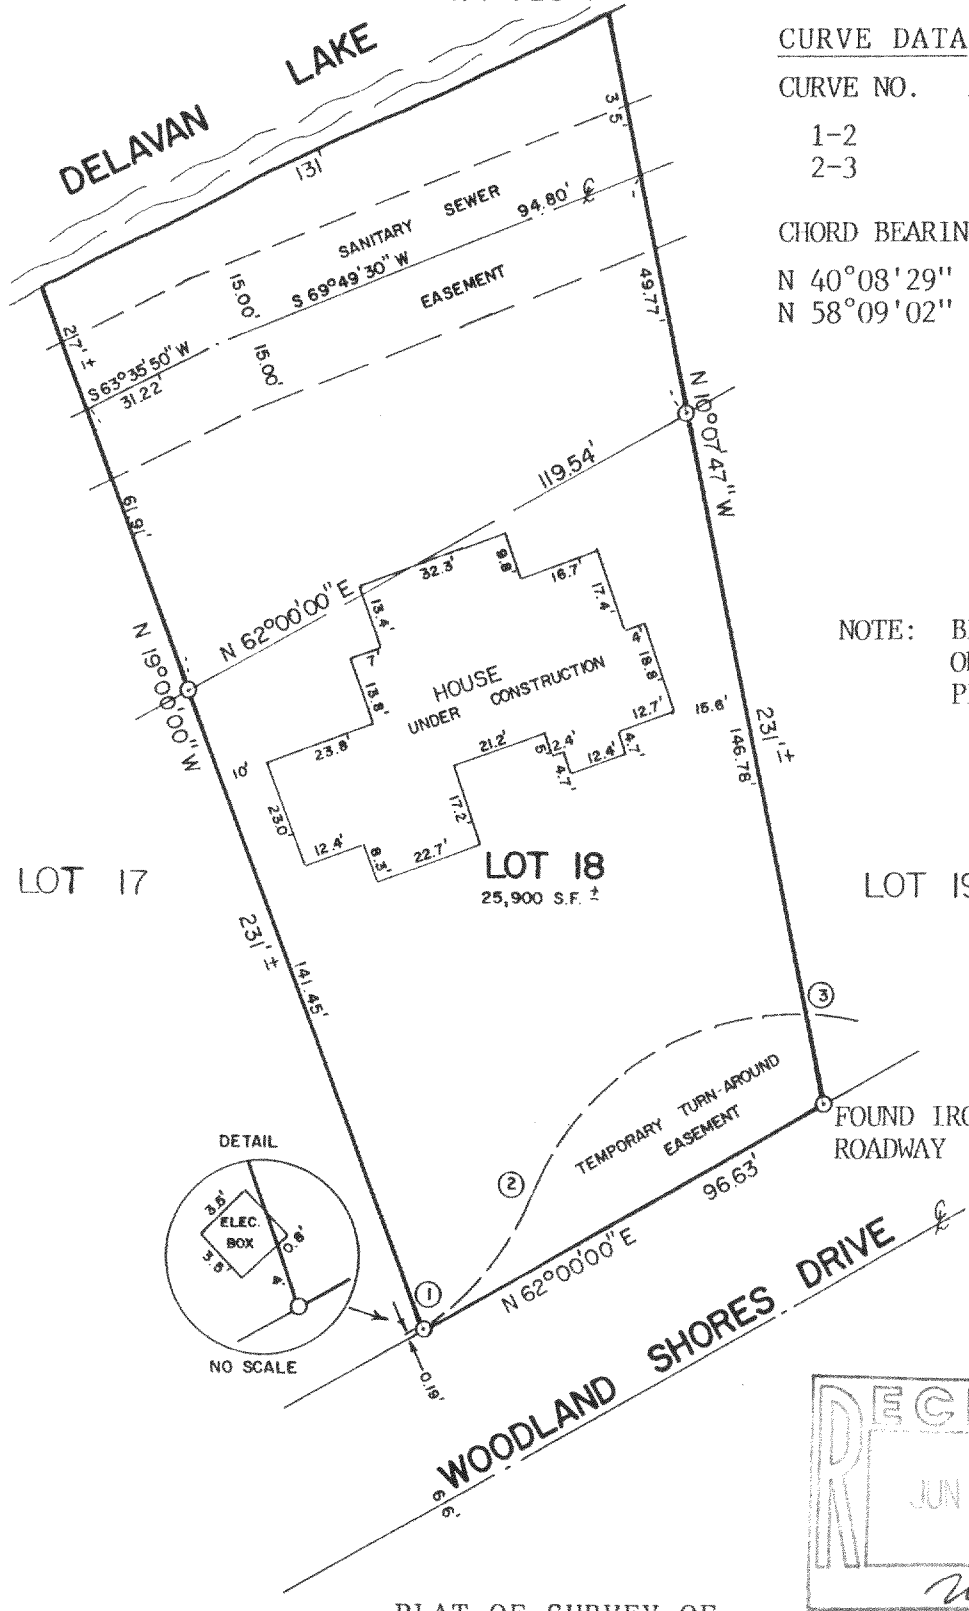

CURVE DATA

CURVE NO.	ARC LENGTH	RADIUS
1-2	36.31'	60.00'
2-3	74.03'	60.00'

CHORD BEARING	CHORD LENGTH
N 40°08'29" E	35.76'
N 58°09'02" E	69.42'

NOTE: BEARINGS ARE AS SHOWN ON THE SUBDIVISION PLAT.

PLAT OF SURVEY OF

LOT 18 OF WOODLAND SHORES SUBDIVISION, LOCATED IN T2N,R16E, WALWORTH COUNTY, WISCONSIN.

ORDERED BY: ANCHOR SAVINGS & LOAN
 P.O. BOX 997
 LAKE GENEVA, WI. 53147



SCALE - 1"=40'

LEGEND
 ○ - IRON PIPE FOUND

I HEREBY CERTIFY THAT I HAVE SURVEYED THE ABOVE DESCRIBED PROPERTY AND THAT THE ABOVE MAP IS A TRUE REPRESENTATION THEREOF AND SHOWS THE SIZE AND LOCATION OF THE PROPERTY, ITS EXTERIOR BOUNDARIES, THE LOCATION OF ALL VISIBLE STRUCTURES AND DIMENSIONS OF ALL PRINCIPAL BUILDINGS THEREON, BOUNDARY FENCES, APPARENT EASEMENTS, ROADWAYS AND VISIBLE ENCROACHMENTS, IF ANY, TO THE BEST OF MY KNOWLEDGE AND BELIEF.

THIS SURVEY IS MADE FOR THE USE OF THE PRESENT OWNERS OF THE PROPERTY, AND ALSO THOSE WHO PURCHASE, MORTGAGE, OR GUARANTEE THE TITLE THERETO WITHIN ONE (1) YEAR FROM DATE HEREOF.

David F. Abell
 DAVID F. ABELL
 WISCONSIN REGISTERED LAND SURVEYOR, S-1596

DATE *February 26, 1990* JOB NUMBER - 90022
 NOTE: THIS IS NOT A CERTIFIED COPY UNLESS SEALED.

Tax# FWLS-18

216-1268