

ABERNATHY and ASSOCIATES**Kenneth B. Abernathy Jr.****Wisconsin Registered Land Surveyor S-1594**

Rt. 3, Box 273

Elkhorn, Wisconsin 53121

Phone: (414) 723-4260 (office)


(414) 723-4813 (residence)

PLAT OF SURVEY

Part of Lots 9 and 10 of SUNNY DELL SUBDIVISION, located in fractional Section 32, Town 2 North, Range 16 East, Walworth County, Wisconsin.




Ordered By: TLC Realty
Rt. 5 Box 5
Elkhorn, Wi. 53121

Note: See lot line adjustment survey and legal description by others for this area.

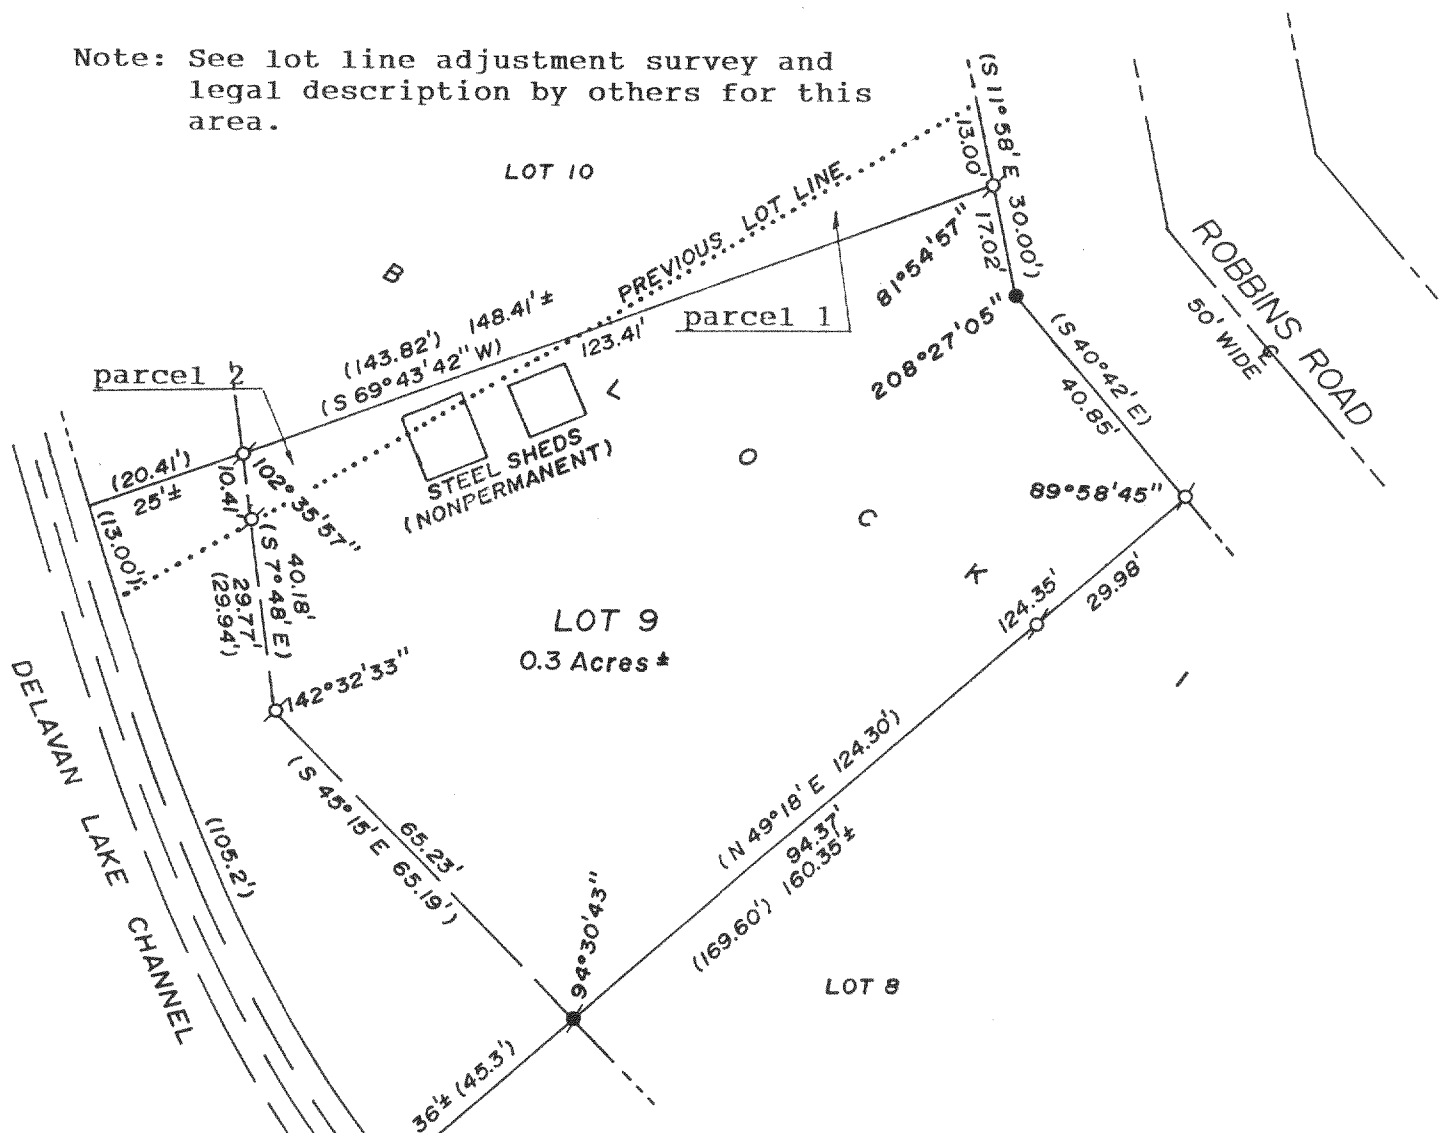**Legend**

- FOUND IRON PIPE
- FOUND IRON ROD
- FOUND BRASS CAPPED MONUMENT
- ⊗ FOUND CONCRETE MONUMENT
- + CHISEL CUT IN CONCRETE
- SET IRON ROD, 24" LONG, WEIGHING 1.5 LBS./LINEAL FT., 3/4" DIA.
- SET IRON ROD, 30" LONG, WEIGHING 4.5 LBS./LINEAL FT., 1-11/16"
- (xx) RECORDED AS DIMENSION
- x-x- EXISTING FENCE

Tax# { FSU-9
FSU-10

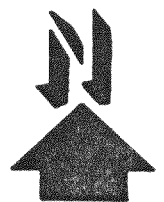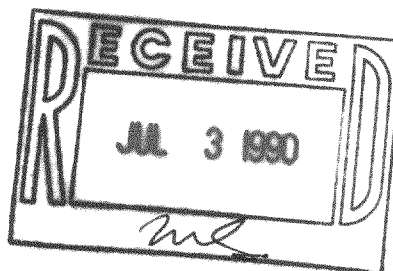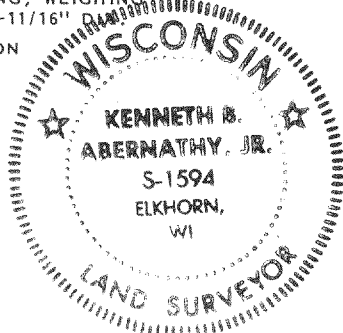

SCALE: 1" = 30 FEET

"I hereby certify that I have surveyed the above described property and that the above map is a true representation thereof and shows the size and location of the property, its exterior boundaries, the location of all visible structures and dimensions of all principal buildings thereon, boundary fences, apparent easements, roadways and visible encroachments, if any."

"This survey is made for the use of the present owners of the property, and also those who purchase, mortgage, or guarantee the title thereto within one year from date hereof."

KENNETH B. ABERNATHY, JR.
WISCONSIN REGISTERED LAND SURVEYOR,
S-1594

Date: JUNE 22, 1990 Job No. 90.615

216-1280