


DUNHAM SURVEYING, S.C.
SURVEYING & SUBDIVIDING
DELAVER, WISCONSIN 53115

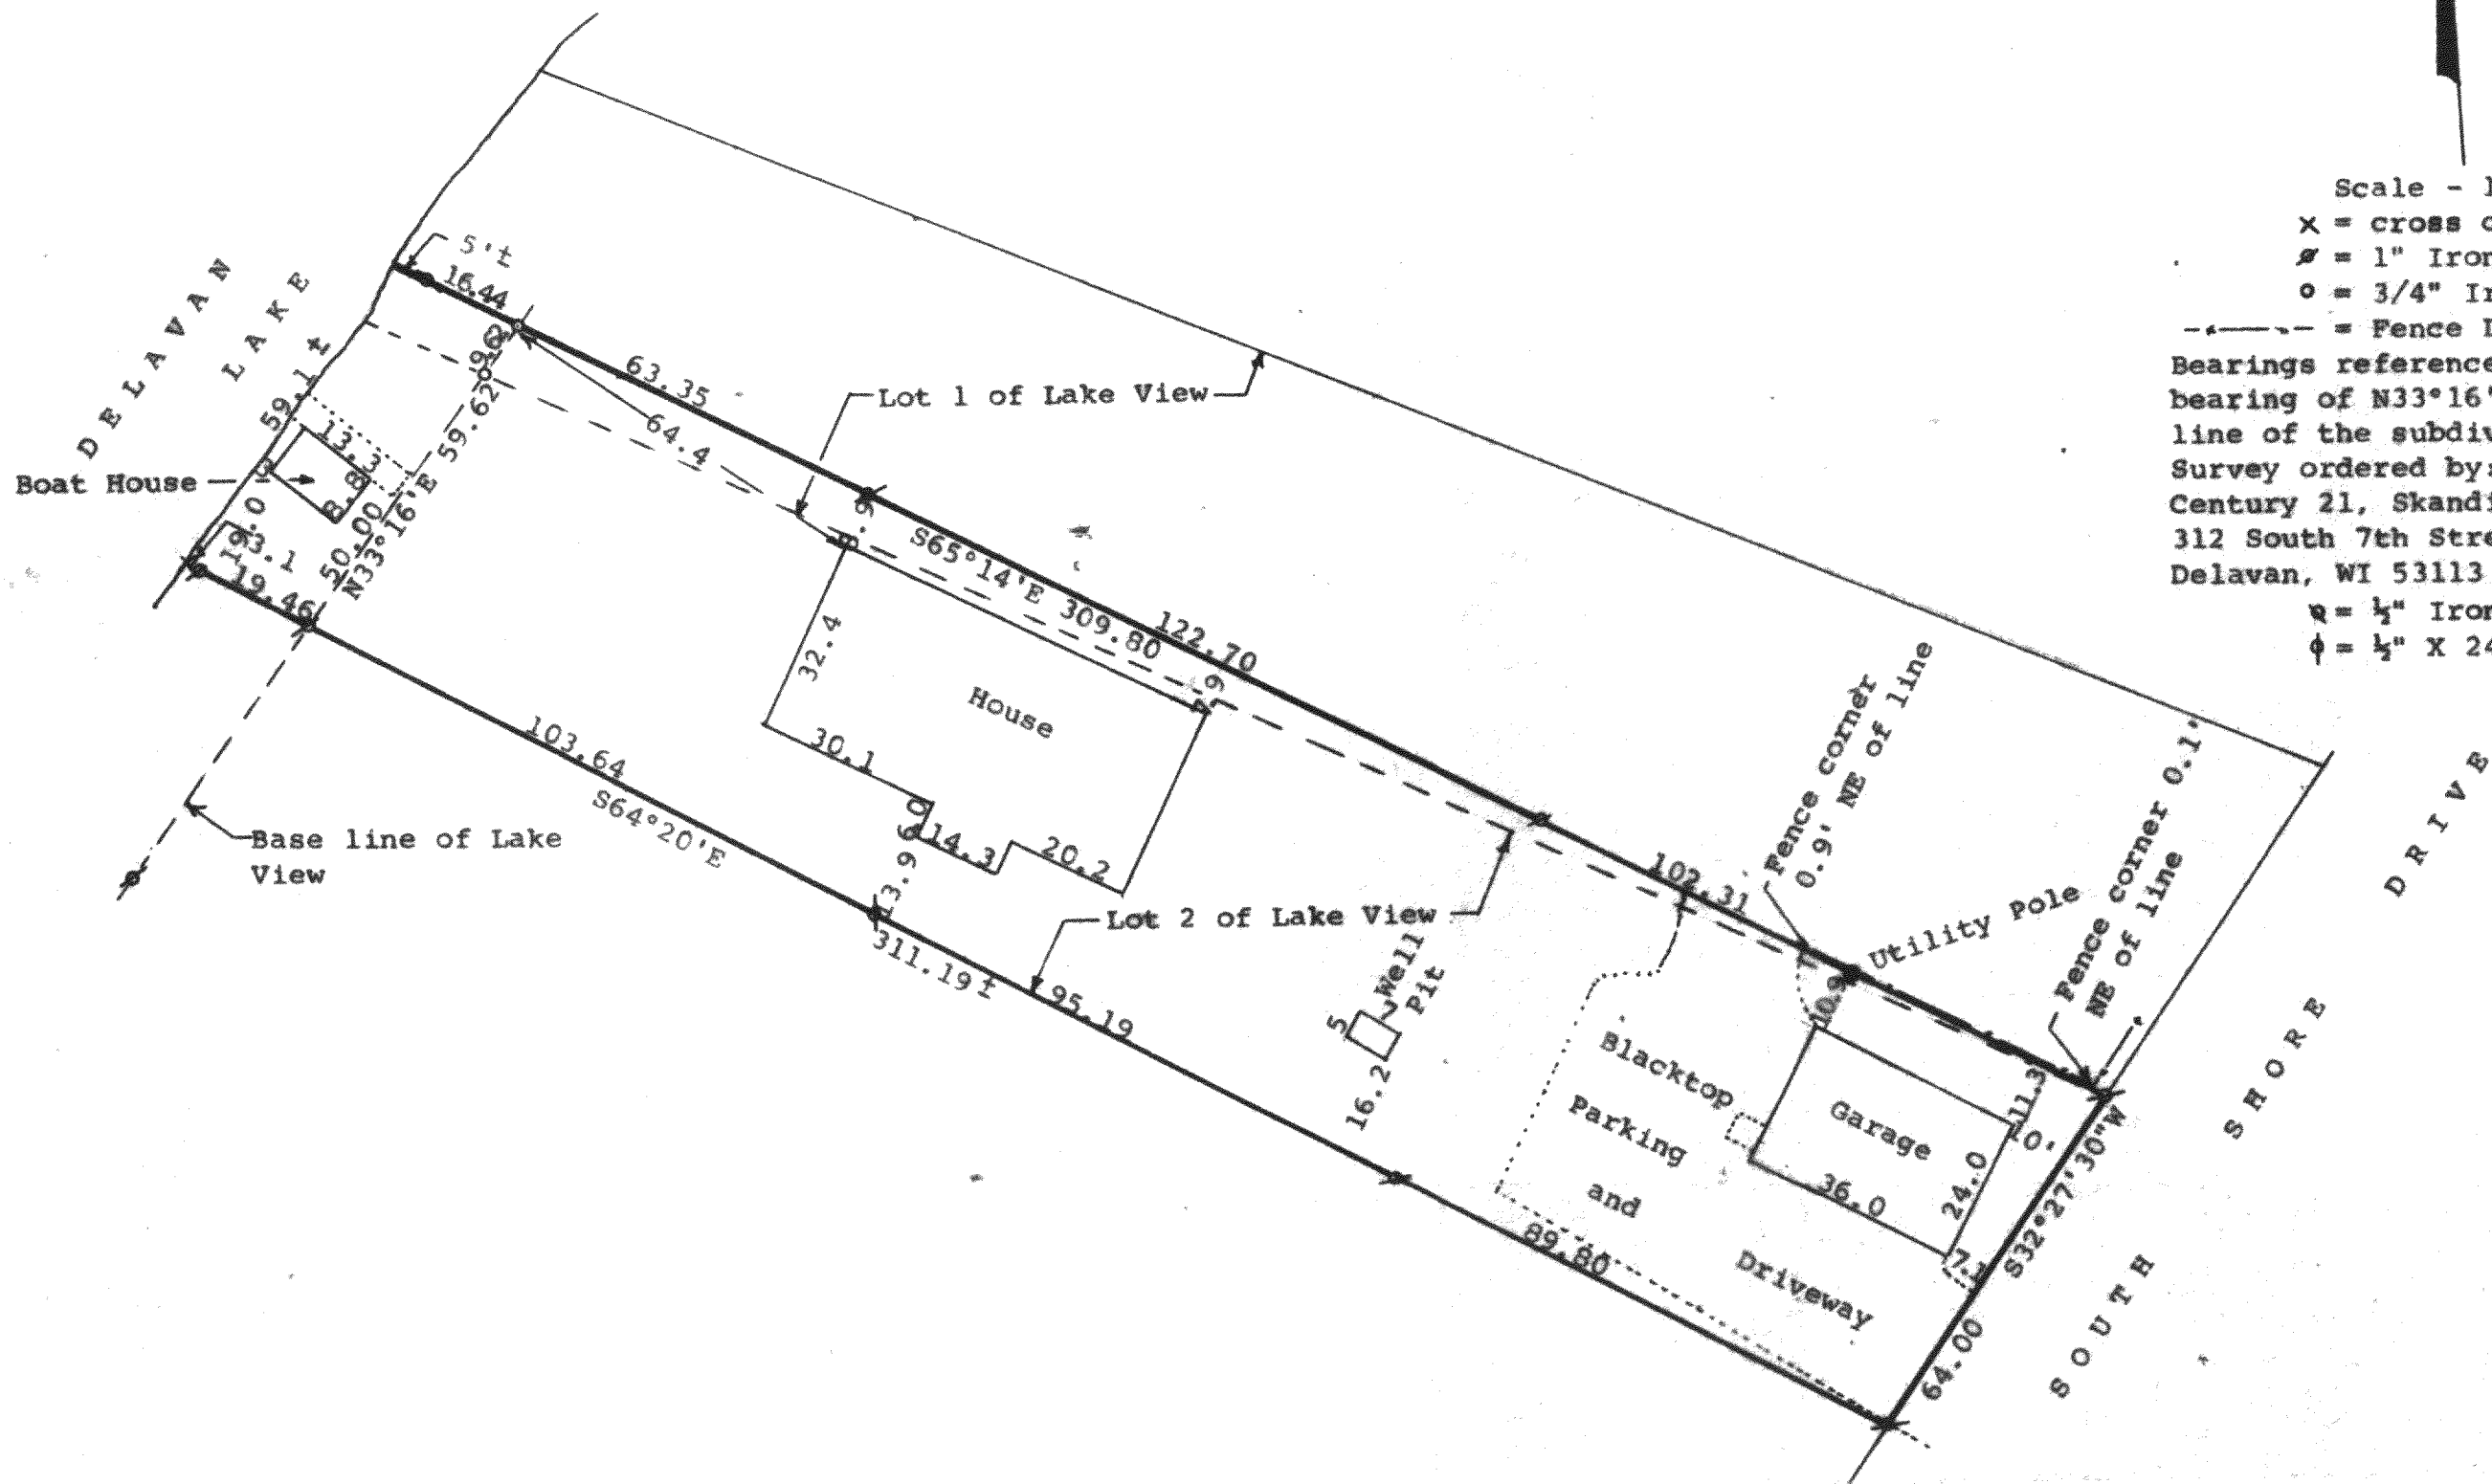

Scale - 1" = 30'
x = cross cut on concrete
= 1" Iron Pipe Found
o = 3/4" Iron Pipe Found
--- = Fence Line
Bearings referenced to the recorded
bearing of N33°16'E along the base
line of the subdivision
Survey ordered by:
Century 21, Skandia Realty
312 South 7th Street
Delavan, WI 53113
= 1/2" Iron Pipe Found
= 1/2" X 24" Iron Pipe Set



STATE OF WISCONSIN) SS
COUNTY OF WALWORTH)

I, George T. Dunham, Surveyor, certify that I have surveyed the
property described as follows:

A parcel of land located in Lots 1 and 2 of Lake View, a sub-
division located in Section 27, T 2 N, R 16 E, Walworth County,
Wisconsin, described as follows: Beginning at the most southerly
corner of said Lot 2; thence northeasterly along the easterly line
of said Lot 2, 64.00 feet to the most easterly corner of said Lot
2; thence northwesterly 288.36 feet to an iron pipe on the base
line of said Lot 1, located 9.62 feet as measured along the the
base line from the iron pipe on the southerly line of said Lot 1;
thence continue northwesterly along the same line 21.44 feet more
or less to the shore of Delavan Lake; thence southwesterly along
the shore of Delavan Lake 59.1 feet more or less to the most west-
erly corner of said Lot 2; thence southeasterly along the southerly
line of said Lot 2, 311.19 feet (previously described as 310.21 feet)
more or less to the place of beginning subject to easements of record.

and that the plat shown hereon is a correct representation thereof and shows
the size and location of the property, its exterior boundaries, the location
of all visible structures and dimensions of all principal buildings thereon,
boundary fences, apparent easements, roadways and visible encroachments, if
any, and that I have surveyed the property hereon described, according to the
official records, to the best of my knowledge and belief.
July 21, 1989

George T. Dunham
George T. Dunham, Surveyor

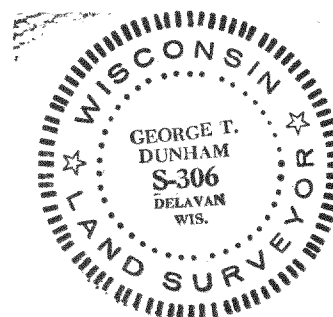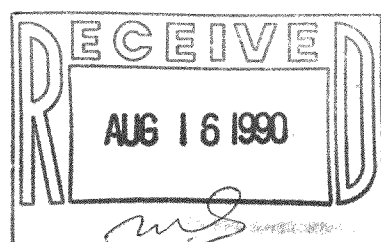

Survey # 216-1297

TAX KEY # FLAP 00001
FLAP 00002