


DUNHAM SURVEYING, S.C.  
SURVEYING & SUBDIVIDING  
DELAVAL, WISCONSIN 53115

DELAVAL

DRIVE

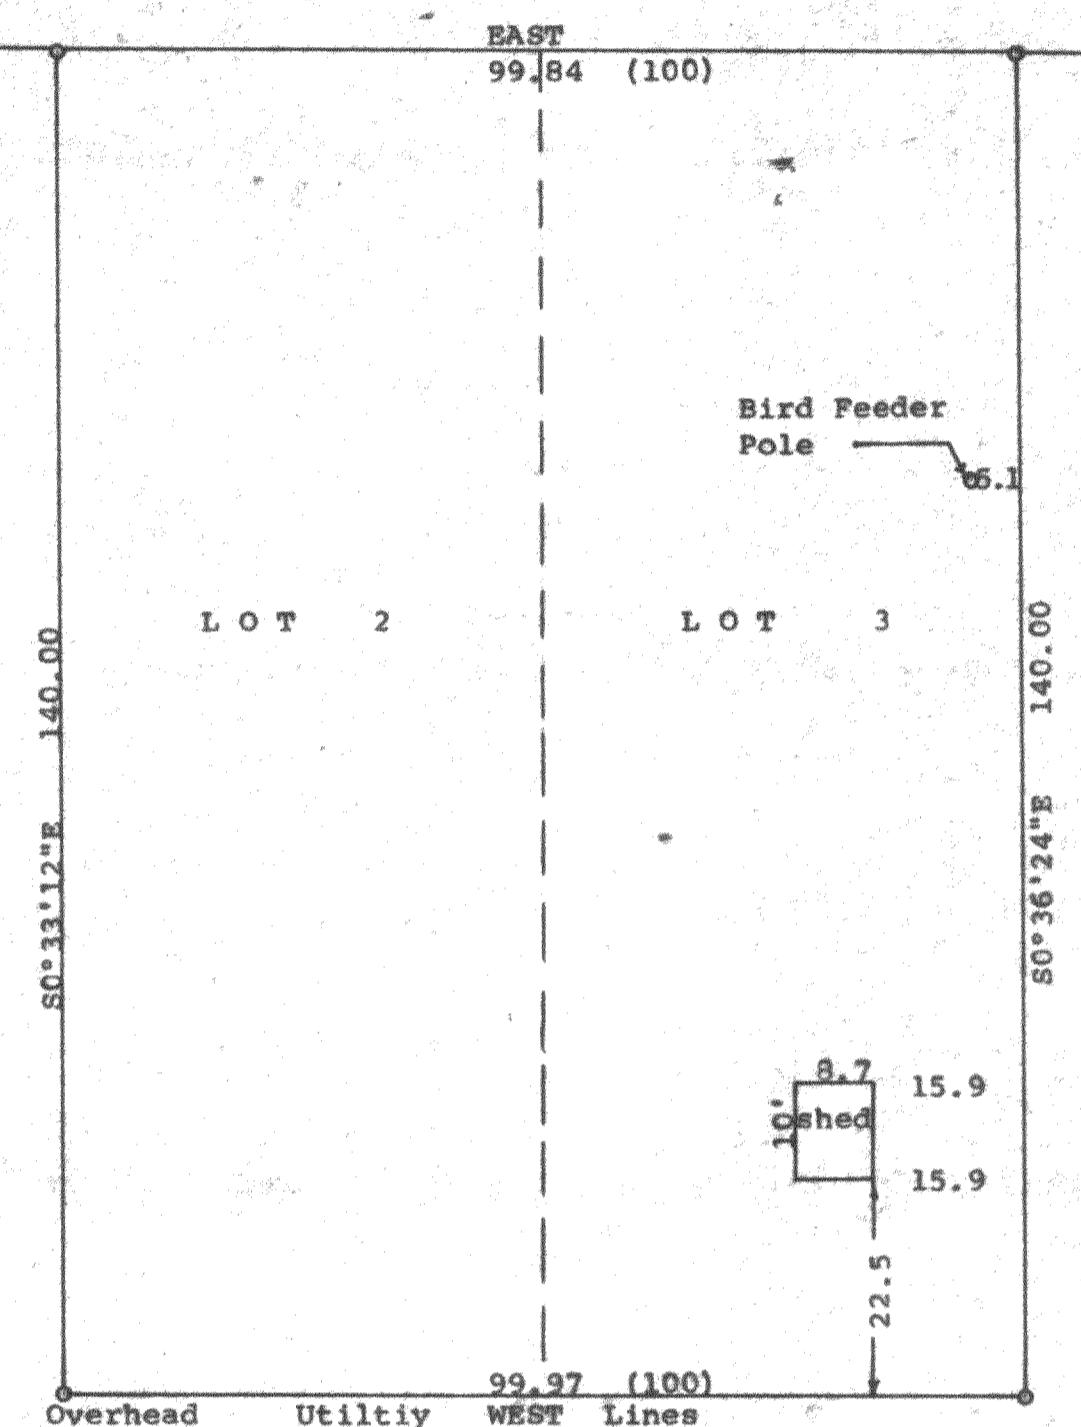

STATE OF WISCONSIN  
COUNTY OF WALWORTH)

I, George T. Dunham, Surveyor, certify that I have surveyed  
the property described as follows:

Lots 2 and 3 in Block 3 of Inlet Oaks Subdivision No. 4, located  
in Section 15, T 2 N, R 16 E, Walworth County, Wisconsin,  
and that the plat shown hereon is a correct representation thereof and shows  
the size and location of the property, its exterior boundaries, the location  
of all visible structures and dimensions of all principal buildings thereon,  
boundary fences, apparent easements, roadways and visible encroachments, if  
any, and that I have surveyed the property hereon described, according to the  
official records, to the best of my knowledge and belief.

July 6, 1989

*George T. Dunham*  
George T. Dunham, Surveyor

