
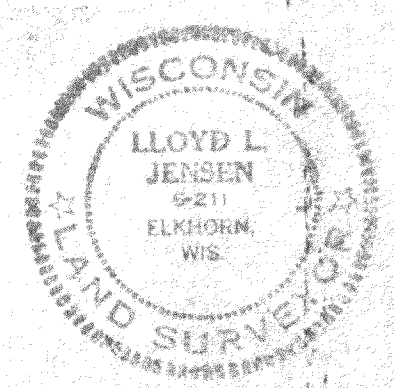
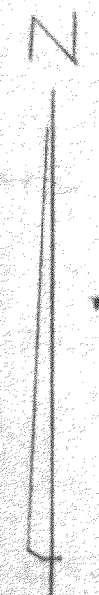


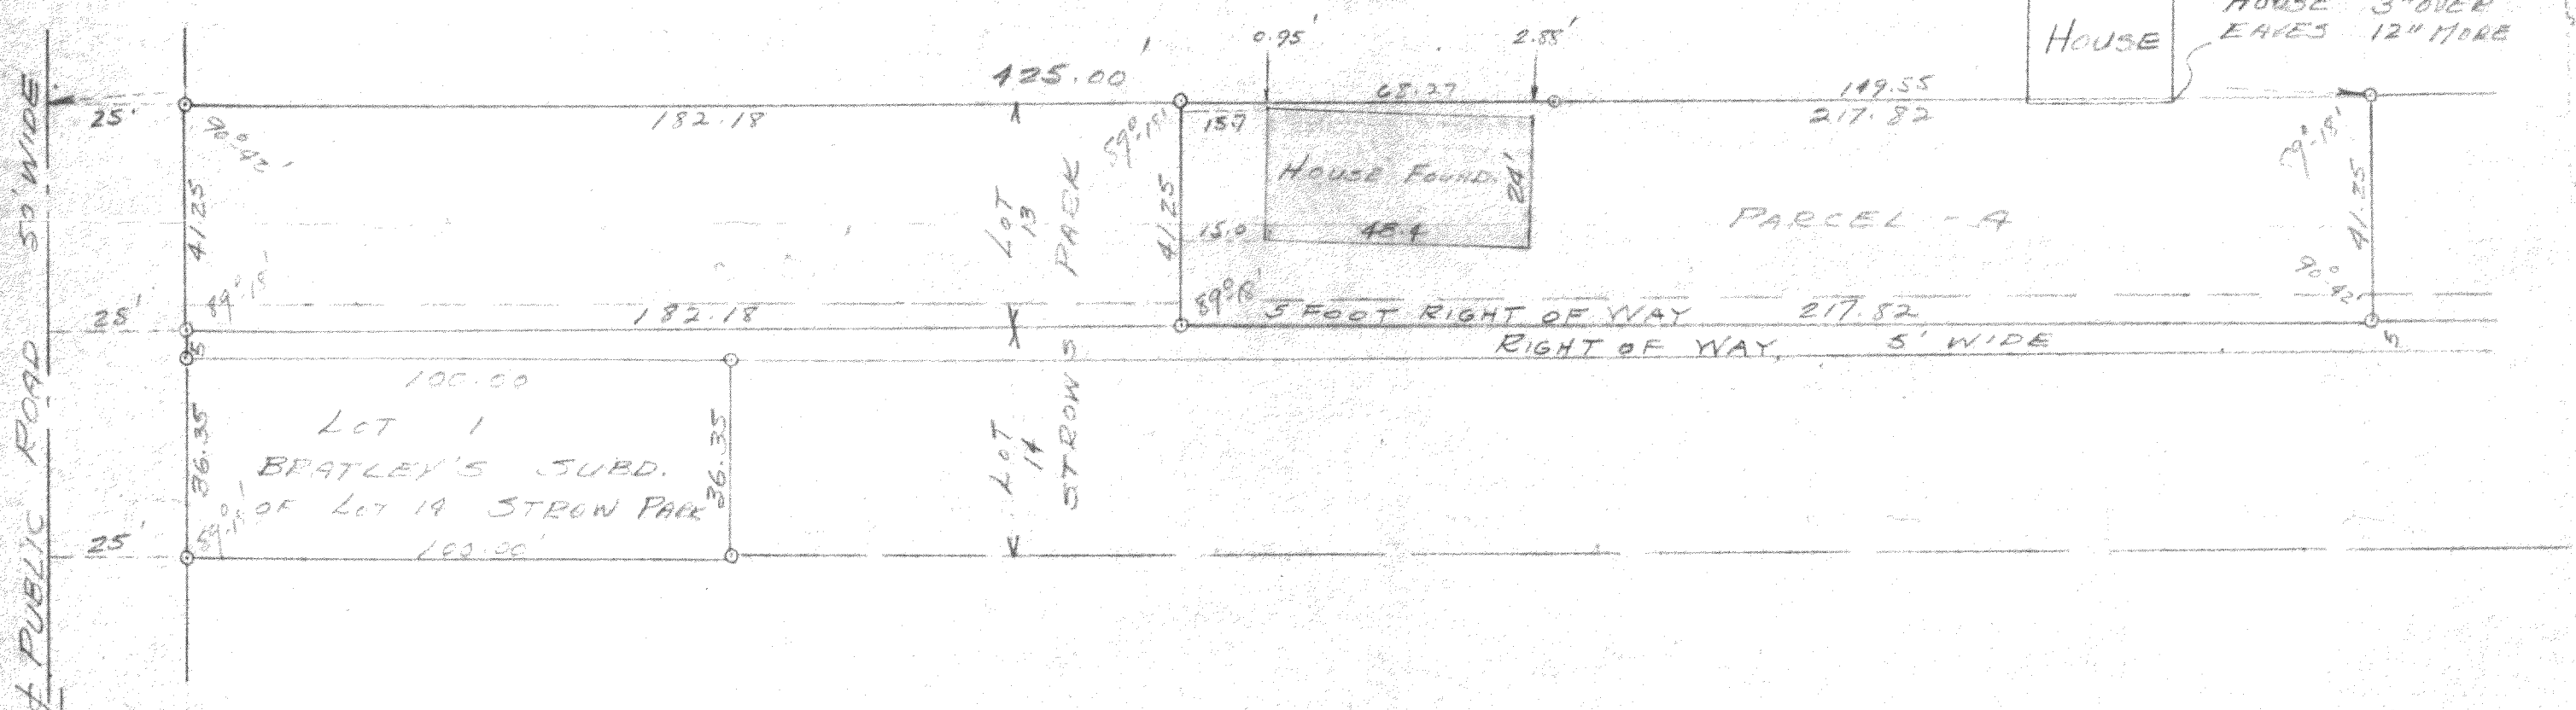

PLAT OF SURVEY
OF
PART OF LOTS 13 AND 14
OF STROWS PARK, SECTION 28,
T2N-R16E, WALWORTH COUNTY,
WISCONSIN.

Lloyd L. Jensen
SURVEYOR

SCALE 1" = 30'

DATE JUNE 1966

FST-3
" - 3B

FBS-1

0-IRON STAKE
216-13- ●-CONC. MON.