


DUNHAM SURVEYING, S.C.
SURVEYING & SUBDIVIDING
DELAVER, WISCONSIN 53115

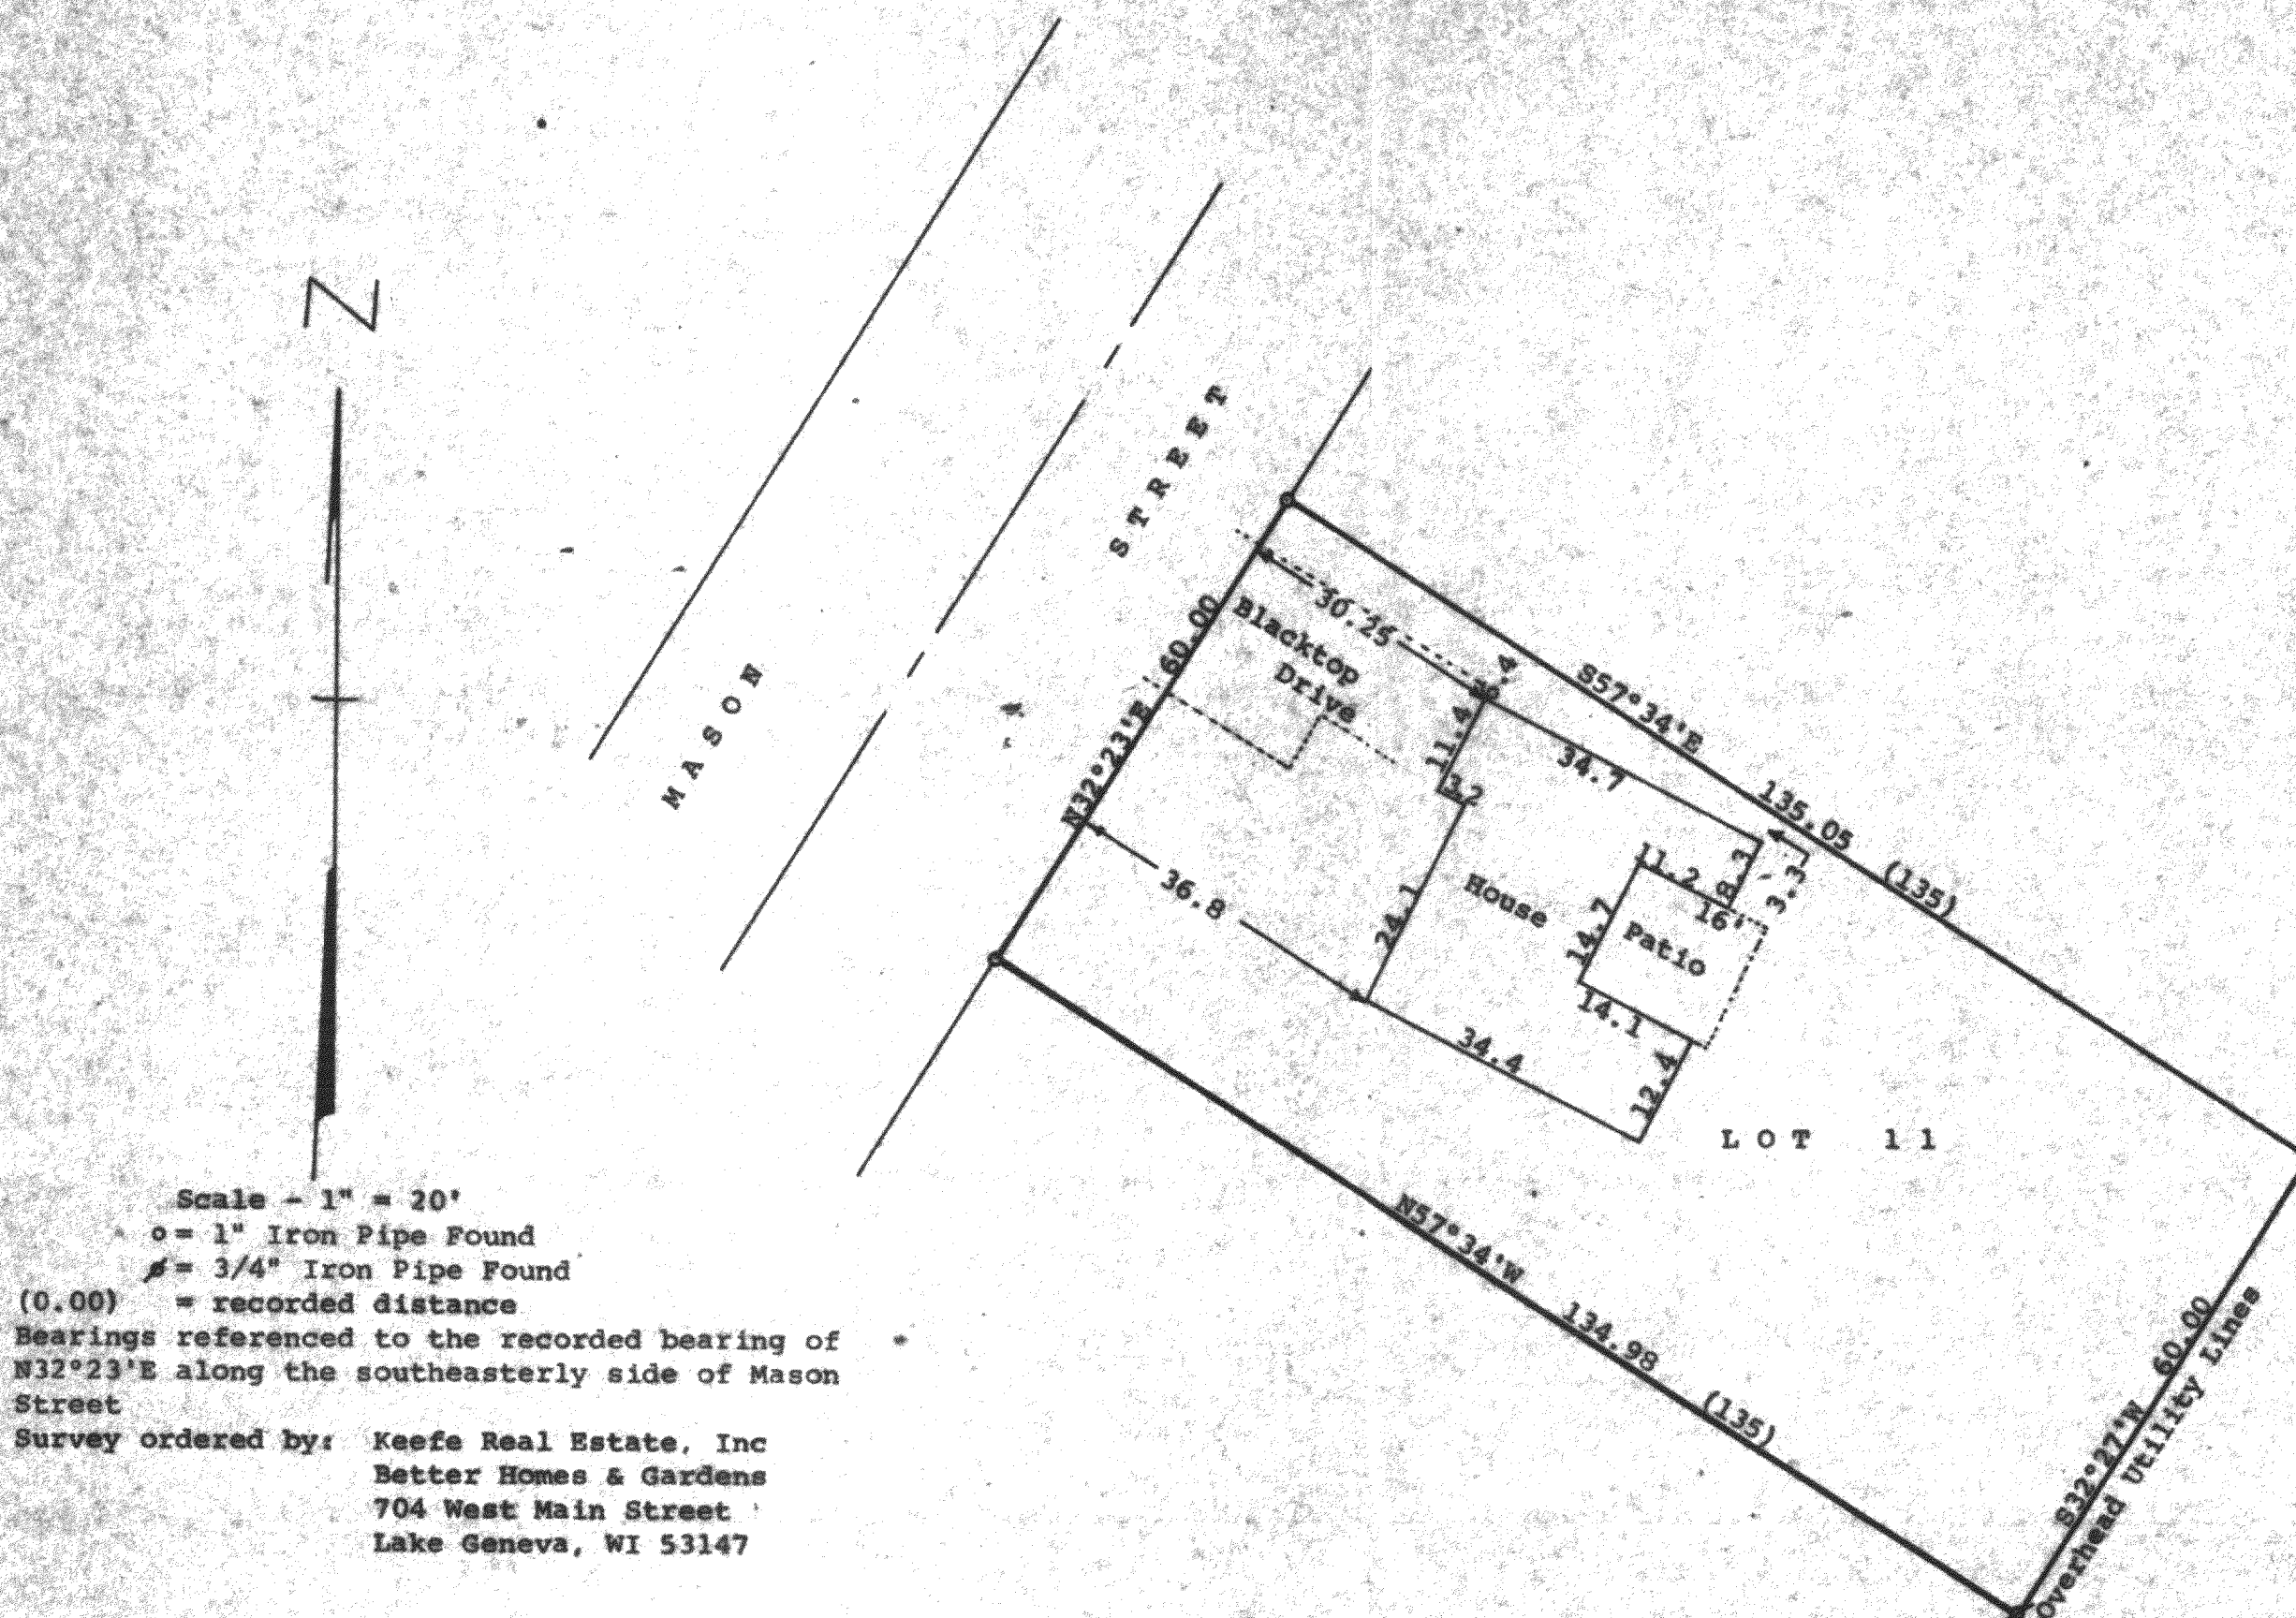

Scale - 1" = 20'
o = 1" Iron Pipe Found
p = 3/4" Iron Pipe Found
(0.00) = recorded distance
Bearings referenced to the recorded bearing of
N32°23'E along the southeasterly side of Mason
Street
Survey ordered by: Keefe Real Estate, Inc
Better Homes & Gardens
704 West Main Street
Lake Geneva, WI 53147

STATE OF WISCONSIN)
COUNTY OF WALWORTH) SS

I, George T. Dunham, Surveyor, certify that I have surveyed the
property described as follows:

Lot 11 in Block 2 of Delmar, a subdivision located in Section
27, T 2 N, R 16 E, Walworth County, Wisconsin.

and that the plat shown hereon is a correct representation thereof and shows
the size and location of the property, its exterior boundaries, the location
of all visible structures and dimensions of all principal buildings thereon,
boundary fences, apparent easements, roadways and visible encroachments, if
any, and that I have surveyed the property hereon described, according to the
official records, to the best of my knowledge and belief.
August 29, 1989

George T. Dunham
George T. Dunham, Surveyor

