


DUNHAM SURVEYING, S.C.
SURVEYING & SUBDIVIDING
DELAVER, WISCONSIN 53115

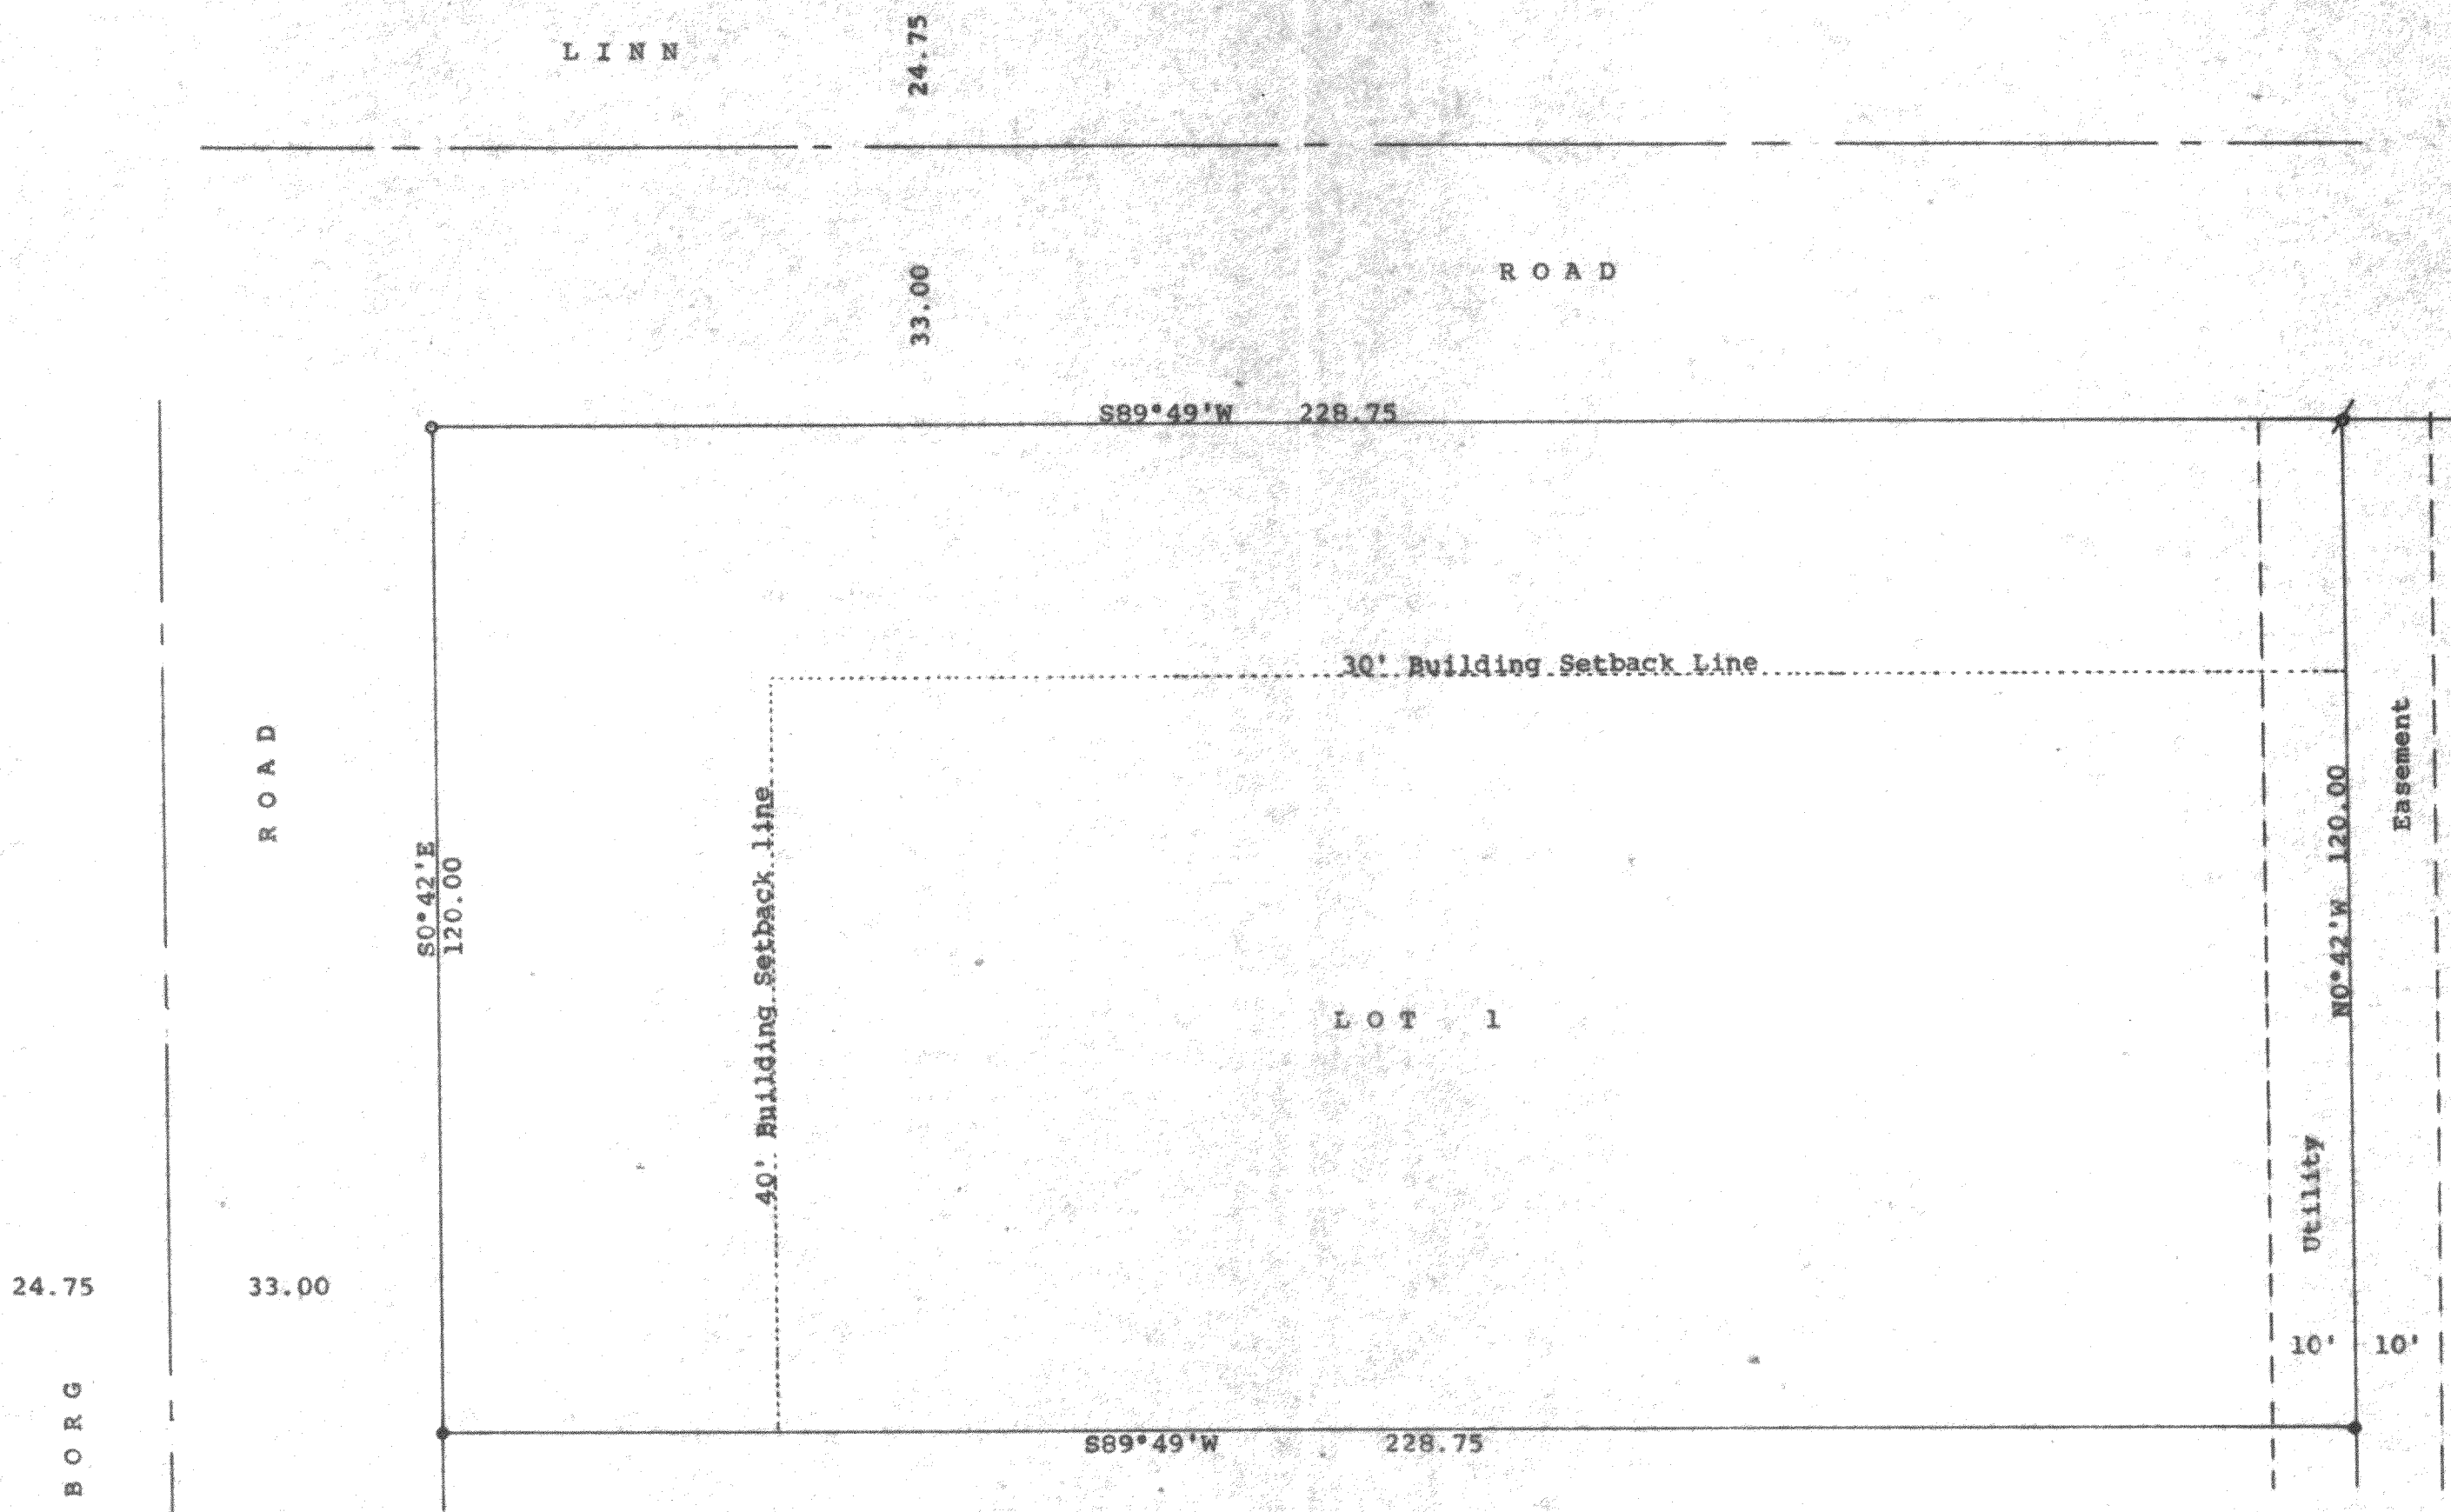

STATE OF WISCONSIN)
COUNTY OF WALWORTH) SS

I, George T. Dunham, Surveyor, certify that I have surveyed the property described as follows:



Lot 1 in Oak Meadow Subdivision, located in the Northeast 1/4 of Section 29, T 2 N, R 16 E, Walworth County, Wisconsin, and that the plat shown hereon is a correct representation thereof and shows the size and location of the property, its exterior boundaries, the location of all visible structures and dimensions of all principal buildings thereon, boundary fences, apparent easements, roadways and visible encroachments, if any, and that I have surveyed the property hereon described, according to the official records, to the best of my knowledge and belief.
December 4, 1989

George T. Dunham
George T. Dunham, Surveyor

Scale - 1" = 20'

• = 3/4" Iron Pipe Found
• = 11/16" Iron Rod Found
o = 1" X 24" Iron Pipe Set

Bearings are those of record on the recorded plat of Oak Meadow Subdivision.
Survey ordered by: Century 21, Skandia Realty
312 South 7th Street
Delavan, WI 53115

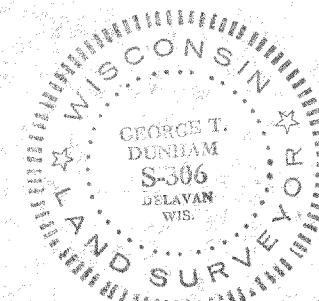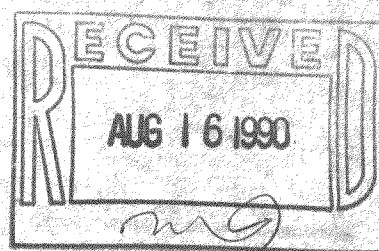

Survey # 216-1317

TAX KEY # Fams 08801