

DUNHAM SURVEYING, S.C.
SURVEYING & SUBDIVIDING
DELAVAN, WISCONSIN 53115

Overhead Utility Lines
East 107.25

N

145.56

423.90

143.36

NO 10° W

134.98

East 107.25

HICKORY

(Private Road)

COURT

197.98

423.90

NO 10° W

124.42

101.50

Found leaning NE and reset

STATE OF WISCONSIN) SS
COUNTY OF WALWORTH)



I, George T. Dunham, Surveyor, certify that I have surveyed the property described as follows:

Lot 13 in Elkwood, a subdivision located in the Northeast 1/4 of Section 13, T 2 N, R 16 E, Walworth County, Wisconsin.

and that the plat shown hereon is a correct representation thereof and shows the size and location of the property, its exterior boundaries, the location of all visible structures and dimensions of all principal buildings thereon, boundary fences, apparent easements, roadways and visible encroachments, if any, and that I have surveyed the property hereon described, according to the official records, to the best of my knowledge and belief.

February 28, 1990

George T. Dunham
George T. Dunham, Surveyor

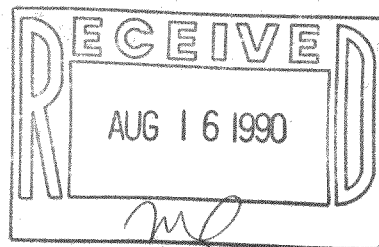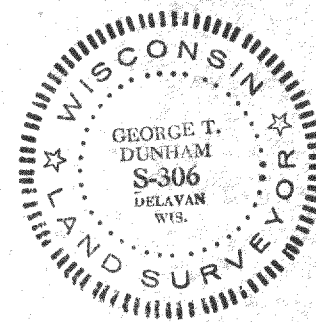

Scale - 1" = 30'

1" = 1" Iron Pipe Found

3/4" X 24" Iron Pipe Set

1/2" X 24" Iron Pipe Set

Wood Posts set as fence line.

No wire between posts.

Bearings shown are those on the recorded plat of Elkwood

Survey ordered by:

Realty World, Carmin Realtors

811 East Geneva Street

Delavan, WI 53115.

Survey # 216-1325

TAX KEY # FEW 00013