


**DEHAVAN LAKE**

LOT 9 IN LAKEWOOD ESTATES SUBDIVISION, ACCORDING  
TO THE RECORDED PLAT THEREOF IN VOLUME 15 OF  
PLATS ON PAGES 11 AND 12 OF THE WALWORTH COUNTY  
REGISTRY.

ORDERED BY: COLDWELL BANKER  
GENEVA LAKES AREA REALTORS  
838 MAIN STREET  
LAKE GENEVA, WISCONSIN  
53147

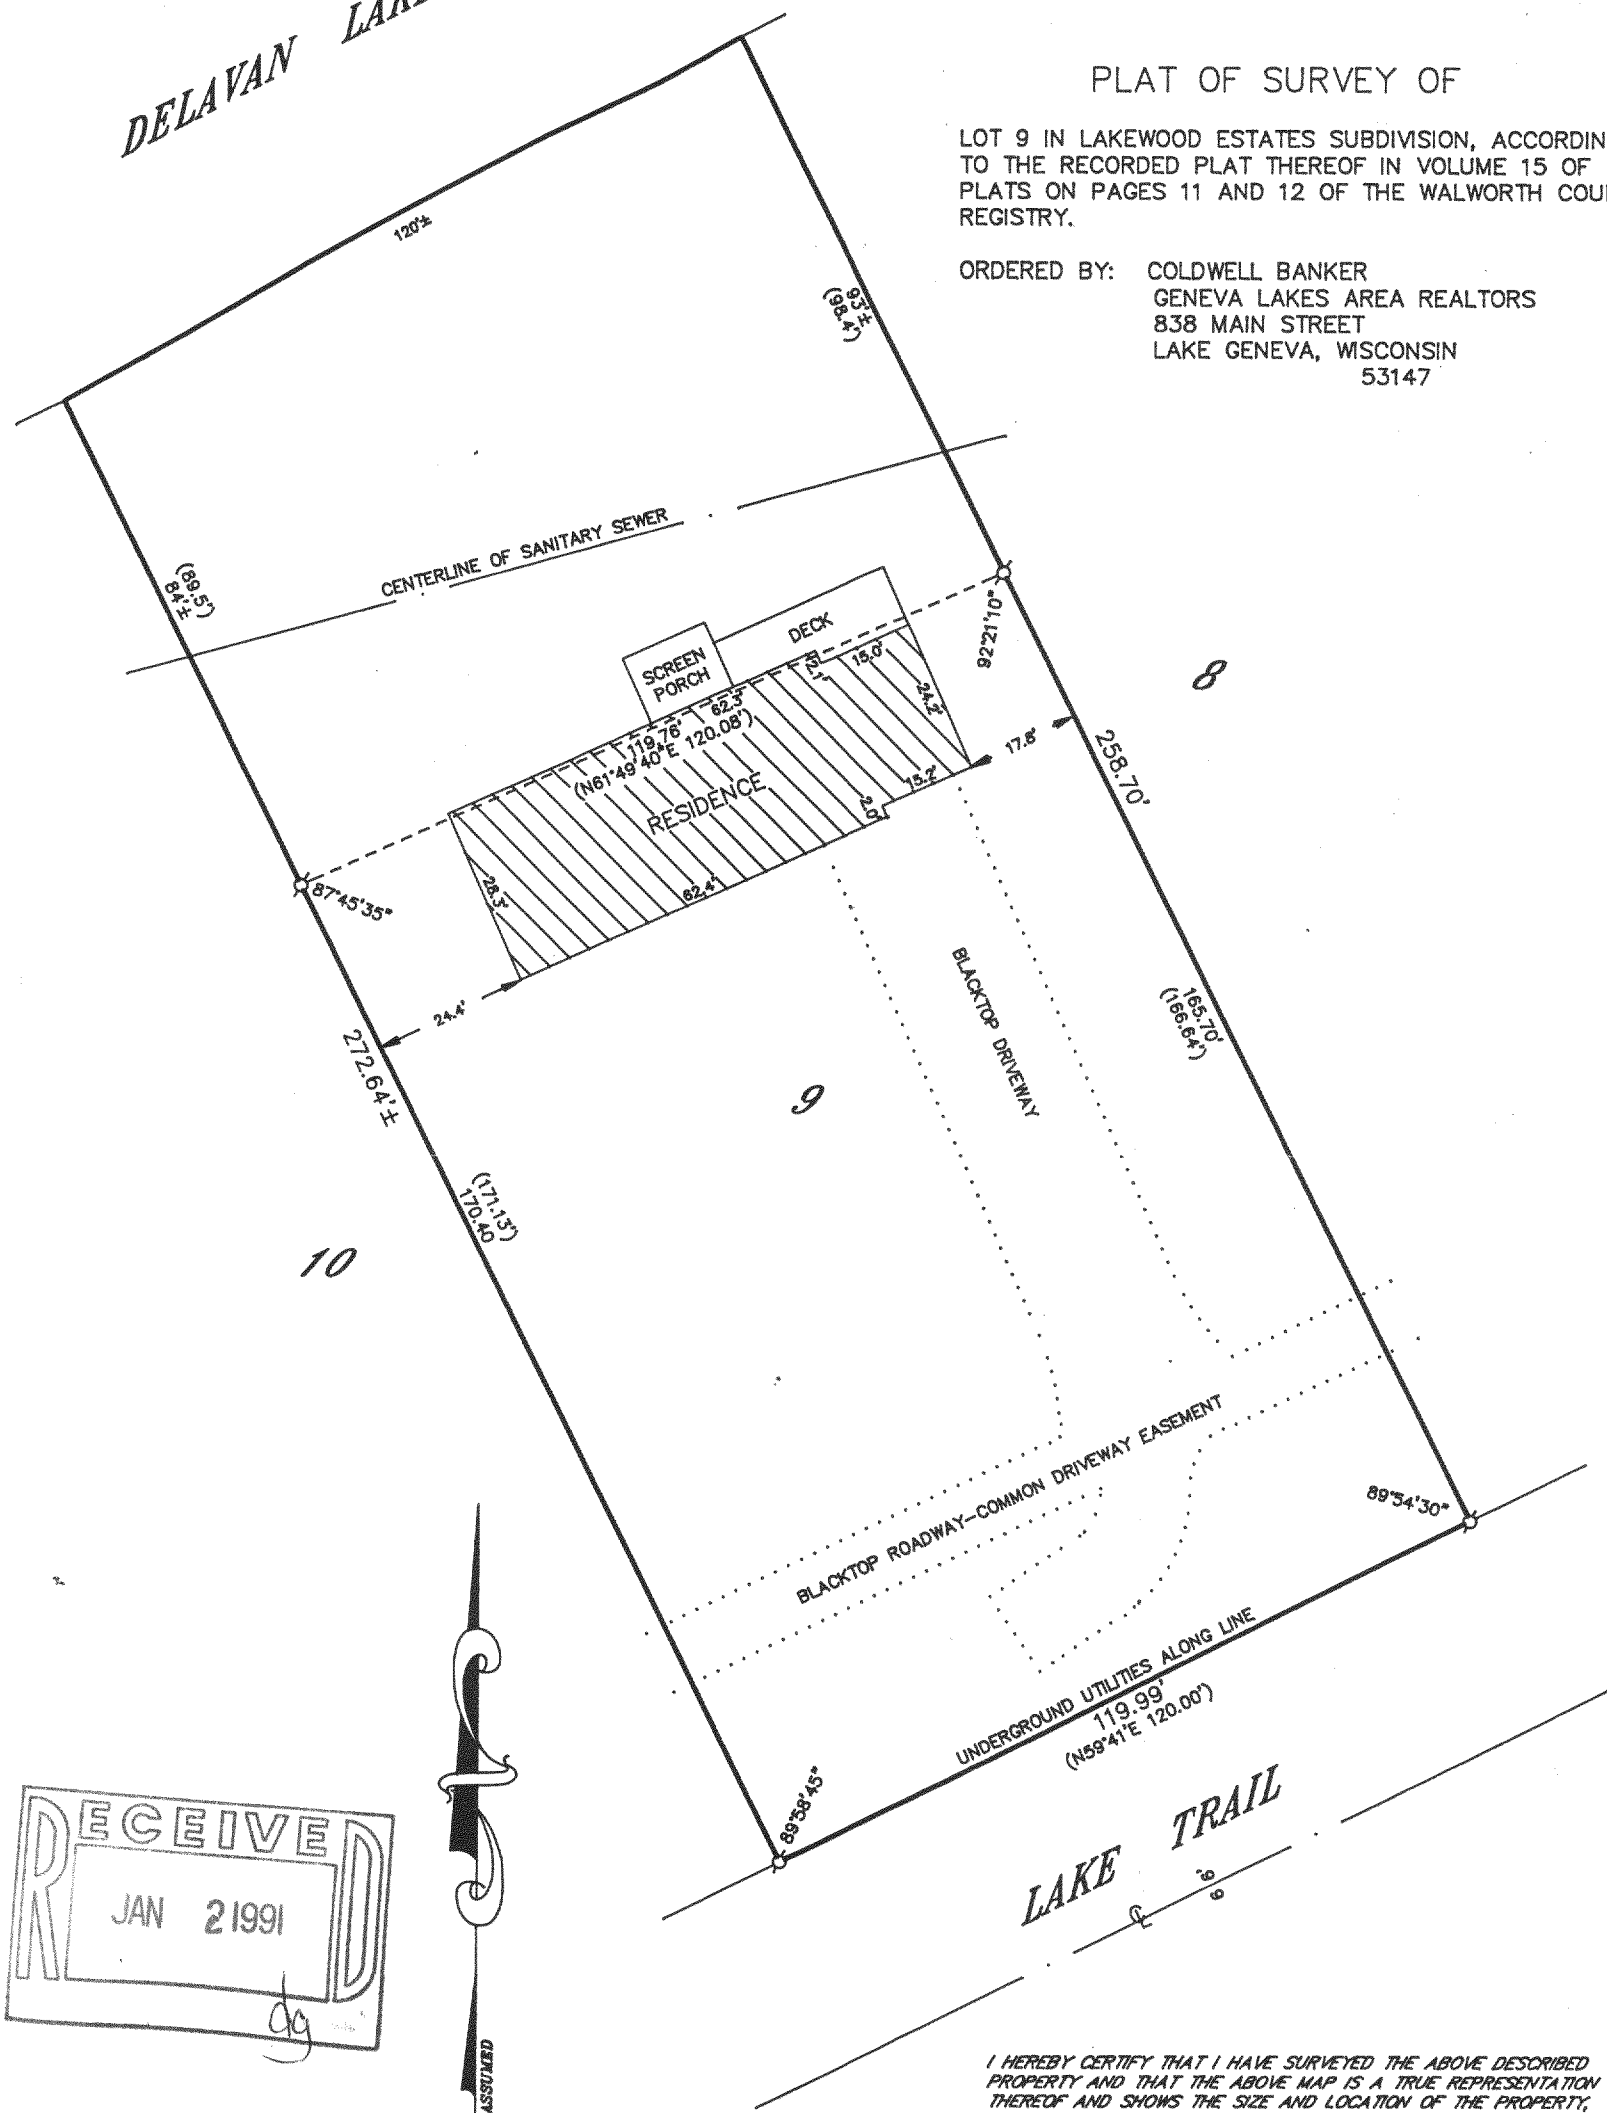

I HEREBY CERTIFY THAT I HAVE SURVEYED THE ABOVE DESCRIBED PROPERTY AND THAT THE ABOVE MAP IS A TRUE REPRESENTATION THEREOF AND SHOWS THE SIZE AND LOCATION OF THE PROPERTY, ITS EXTERIOR BOUNDARIES, THE LOCATION OF ALL VISIBLE STRUCTURES AND DIMENSIONS OF ALL PRINCIPAL BUILDINGS THEREON, BOUNDARY FENCES, APPARENT EASEMENTS, ROADWAYS AND VISIBLE ENCRAGEMENTS, IF ANY, TO THE BEST OF MY KNOWLEDGE AND BELIEF.

THIS SURVEY IS MADE FOR THE USE OF THE PRESENT OWNERS OF THE PROPERTY AND ALSO THOSE WHO PURCHASE, MORTGAGE OR GUARANTEE THE TITLE THERETO WITHIN ONE (1) YEAR FROM DATE HEREOF.

Robert M. Baerenwald  
ROBERT M. BAERENWALD  
WISCONSIN REGISTERED LAND SURVEYOR, S-1508

DATE July 3, 1980 JOB NO. 2562

NOTE: THIS IS NOT A CERTIFIED COPY UNLESS SEALED.

## GRAPHIC SCALE



( IN FEET )

1 inch = 30 ft.

σ-IRON PIPE FOUND  
○-IRON PIPE PLACED  
( )-RECORDED AS

216-1356

FILE 00009