



(IN FEET)
1 inch = 40 ft.

σ - IRON PIPE FOUND
○ - IRON PIPE PLACED
() - RECORDED AS

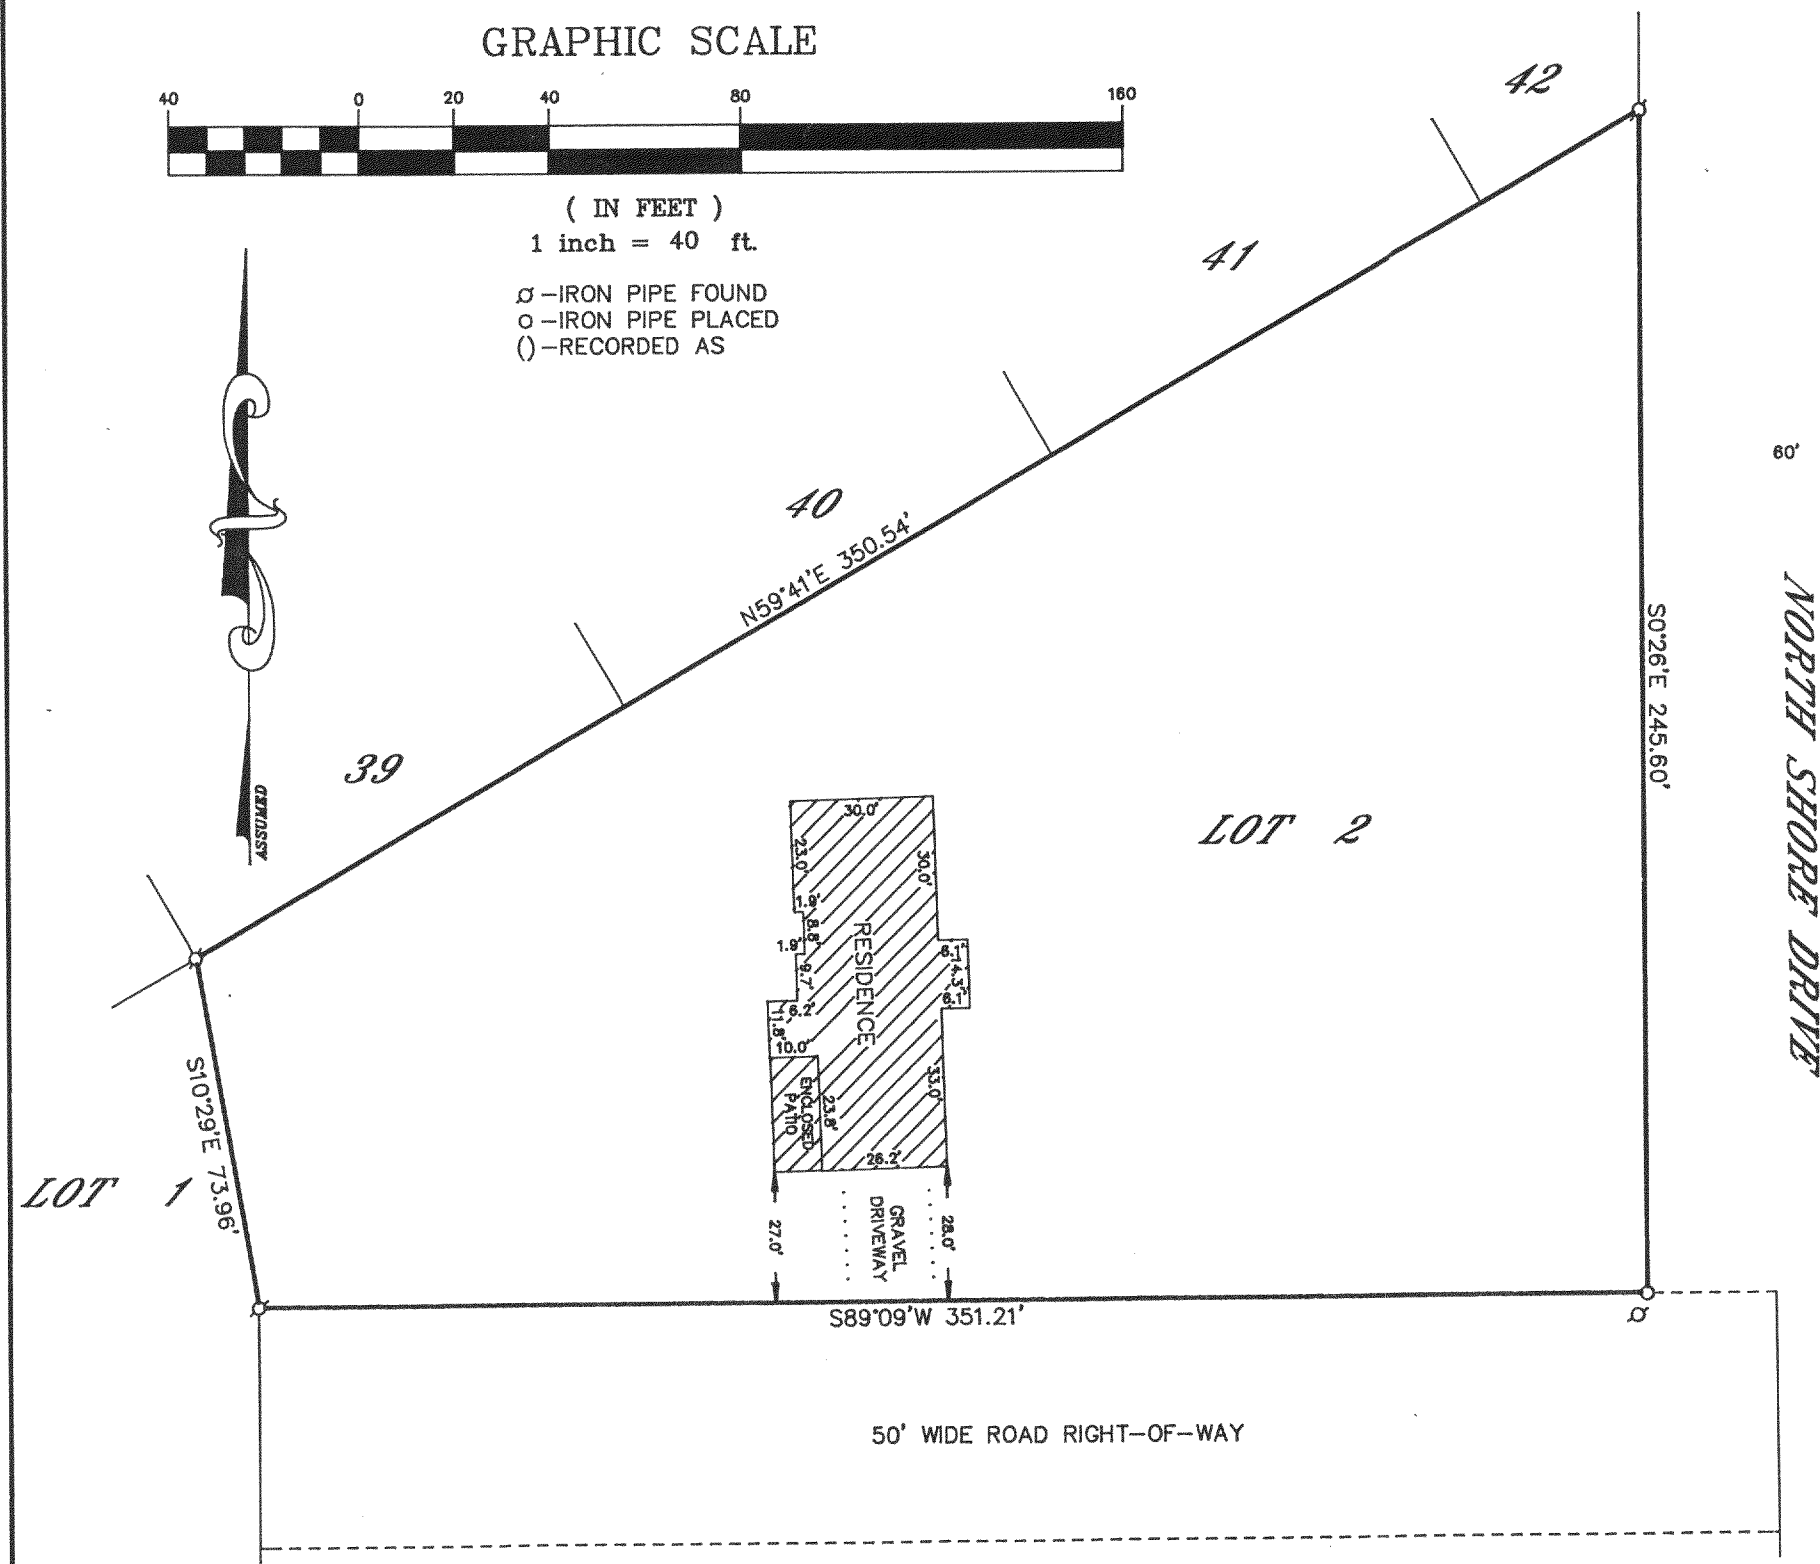

WALWORTH COUNTY
SURVEYING & MAPPING
727 HENRY STREET
LAKE GENEVA, WISCONSIN
414-248-0505

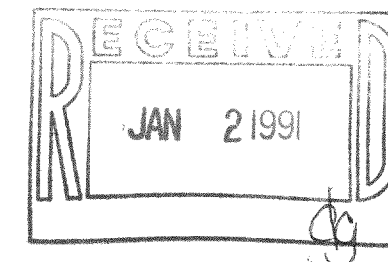

PLAT OF SURVEY OF

LOT 2 OF CERTIFIED SURVEY MAP NO. 701, SAID SURVEY BEING LOCATED IN THE SOUTHWEST 1/4 OF SECTION 21, T 2 N, R 16 E, TOWN OF DELAVAN, WALWORTH COUNTY, WISCONSIN, AND RECORDED IN VOLUME 3 OF CERTIFIED SURVEYS AT PAGE 204 AS DOCUMENT NO. 21592, WALWORTH COUNTY RECORDS, SAID SURVEY BEING A DIVISION OF CERTIFIED SURVEY MAP NO. 531.

ORDERED BY: COLDWELL BANKER
GENEVA LAKES AREA REALTORS
838 MAIN STREET
LAKE GENEVA, WISCONSIN
53147

I HEREBY CERTIFY THAT I HAVE SURVEYED THE ABOVE DESCRIBED PROPERTY AND THAT THE ABOVE MAP IS A TRUE REPRESENTATION THEREOF AND SHOWS THE SIZE AND LOCATION OF THE PROPERTY, ITS EXTERIOR BOUNDARIES, THE LOCATION OF ALL VISIBLE STRUCTURES AND DIMENSIONS OF ALL PRINCIPAL BUILDINGS THEREON, BOUNDARY FENCES, APPARENT EASEMENTS, ROADWAYS AND VISIBLE ENCROACHMENTS, IF ANY, TO THE BEST OF MY KNOWLEDGE AND BELIEF.

THIS SURVEY IS MADE FOR THE USE OF THE PRESENT OWNERS OF THE PROPERTY AND ALSO THOSE WHO PURCHASE, MORTGAGE OR GUARANTEE THE TITLE THERETO WITHIN ONE (1) YEAR FROM DATE HEREOF.

Robert M. Baerenwald
ROBERT M. BAERENWALD
WISCONSIN REGISTERED LAND SURVEYOR, S-1508

May 22, 1990
DATE JOB NO. 2482

NOTE: THIS IS NOT A CERTIFIED COPY UNLESS SEALED.

216-1360

FA 70100002