


**ABELL**  
**SURVEYING & MAPPING**  
 DELAVAN, WISCONSIN 53115  
 414-728-6737

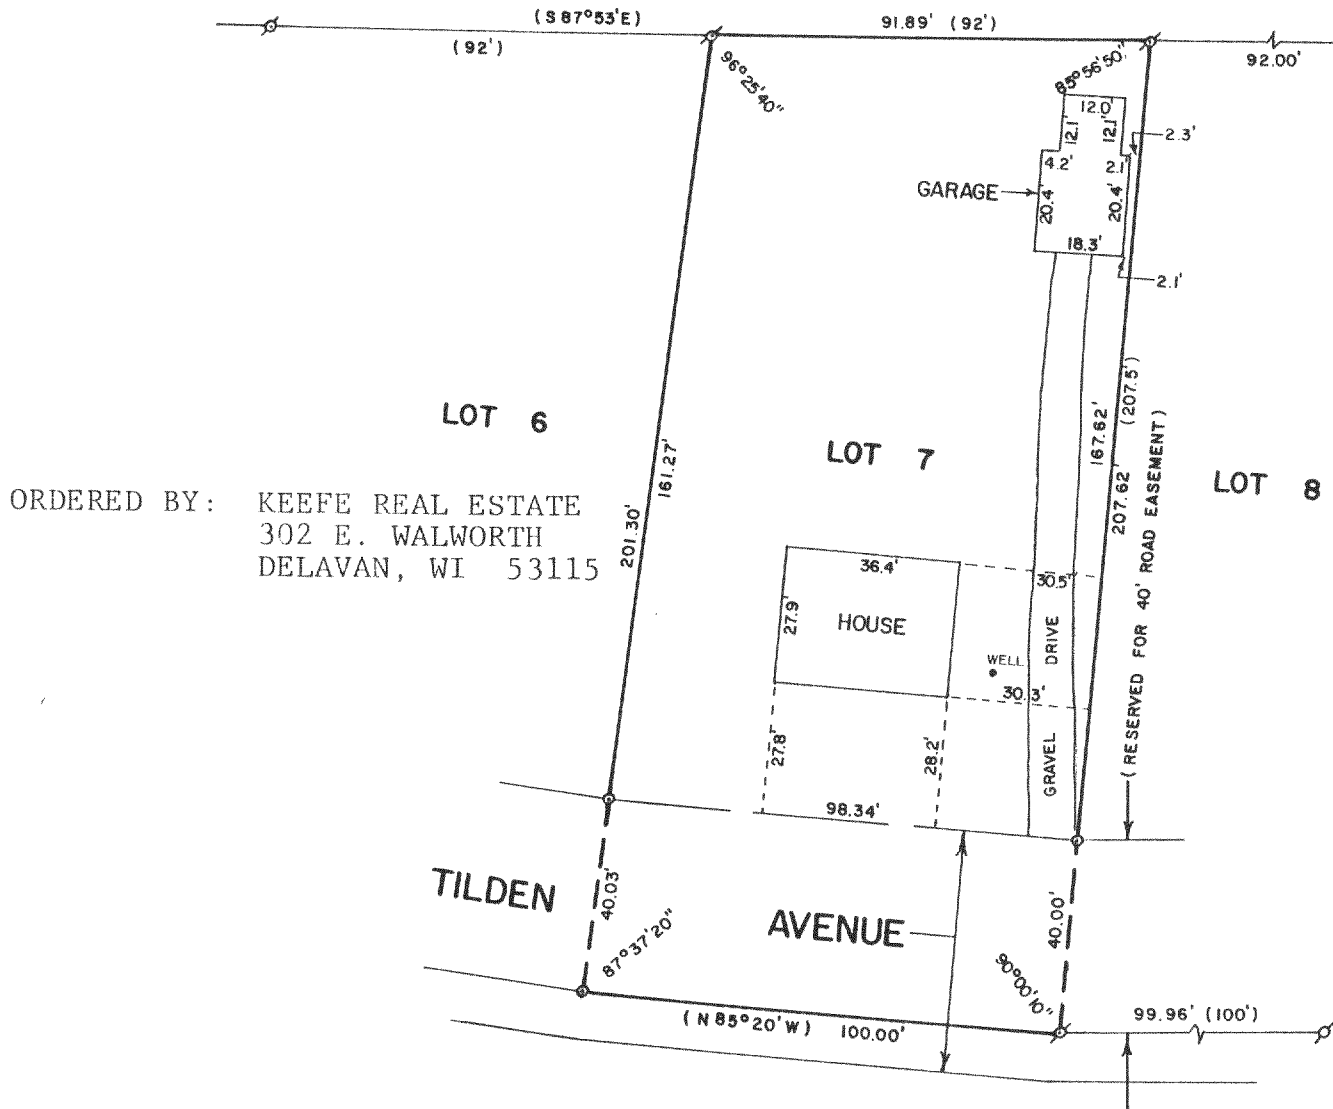

ORDERED BY: KEEFE REAL ESTATE  
 302 E. WALWORTH  
 DELAVAN, WI 53115

PLAT OF SURVEY OF


LOT 7, DELAVAN COUNTRY CLUB SUBDIVISION,  
 TOWN 2 NORTH, RANGE 16 EAST, WALWORTH  
 COUNTY, WISCONSIN.

REVISED: JULY 26, 1990  
 ORDERED BY: GEORGE VIERLING  
 RT. 3, BOX 199A  
 DELAVAN, WI. 53115



SCALE - 1"=40'

- LEGEND**
- ⊗ - IRON PIPE FOUND
  - - IRON ROD SET, FOUND 7-26-90
  - ( ) - RECORDED AS

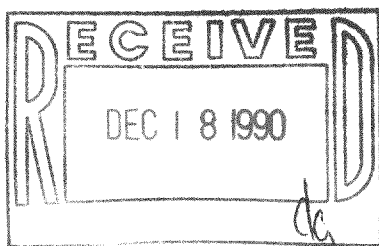

I, DAVID F. ABELL, DO HEREBY CERTIFY  
 THAT I HAVE SURVEYED THE PROPERTY  
 HEREON DESCRIBED ACCORDING TO THE  
 OFFICIAL RECORDS AND THAT THE PLAT  
 HEREON IS A CORRECT REPRESENTATION  
 OF THE PROPERTY LINES TO THE BEST OF  
 MY KNOWLEDGE AND BELIEF.

*David F. Abell*  
 DAVID F. ABELL  
 WISCONSIN REGISTERED LAND SURVEYOR, S-1596

*October 8, 1986*  
 DATE JOB NUMBER - 86059