


ABELL  
SURVEYING & MAPPING  
DELAVAL, WISCONSIN 53115  
414-728-6787

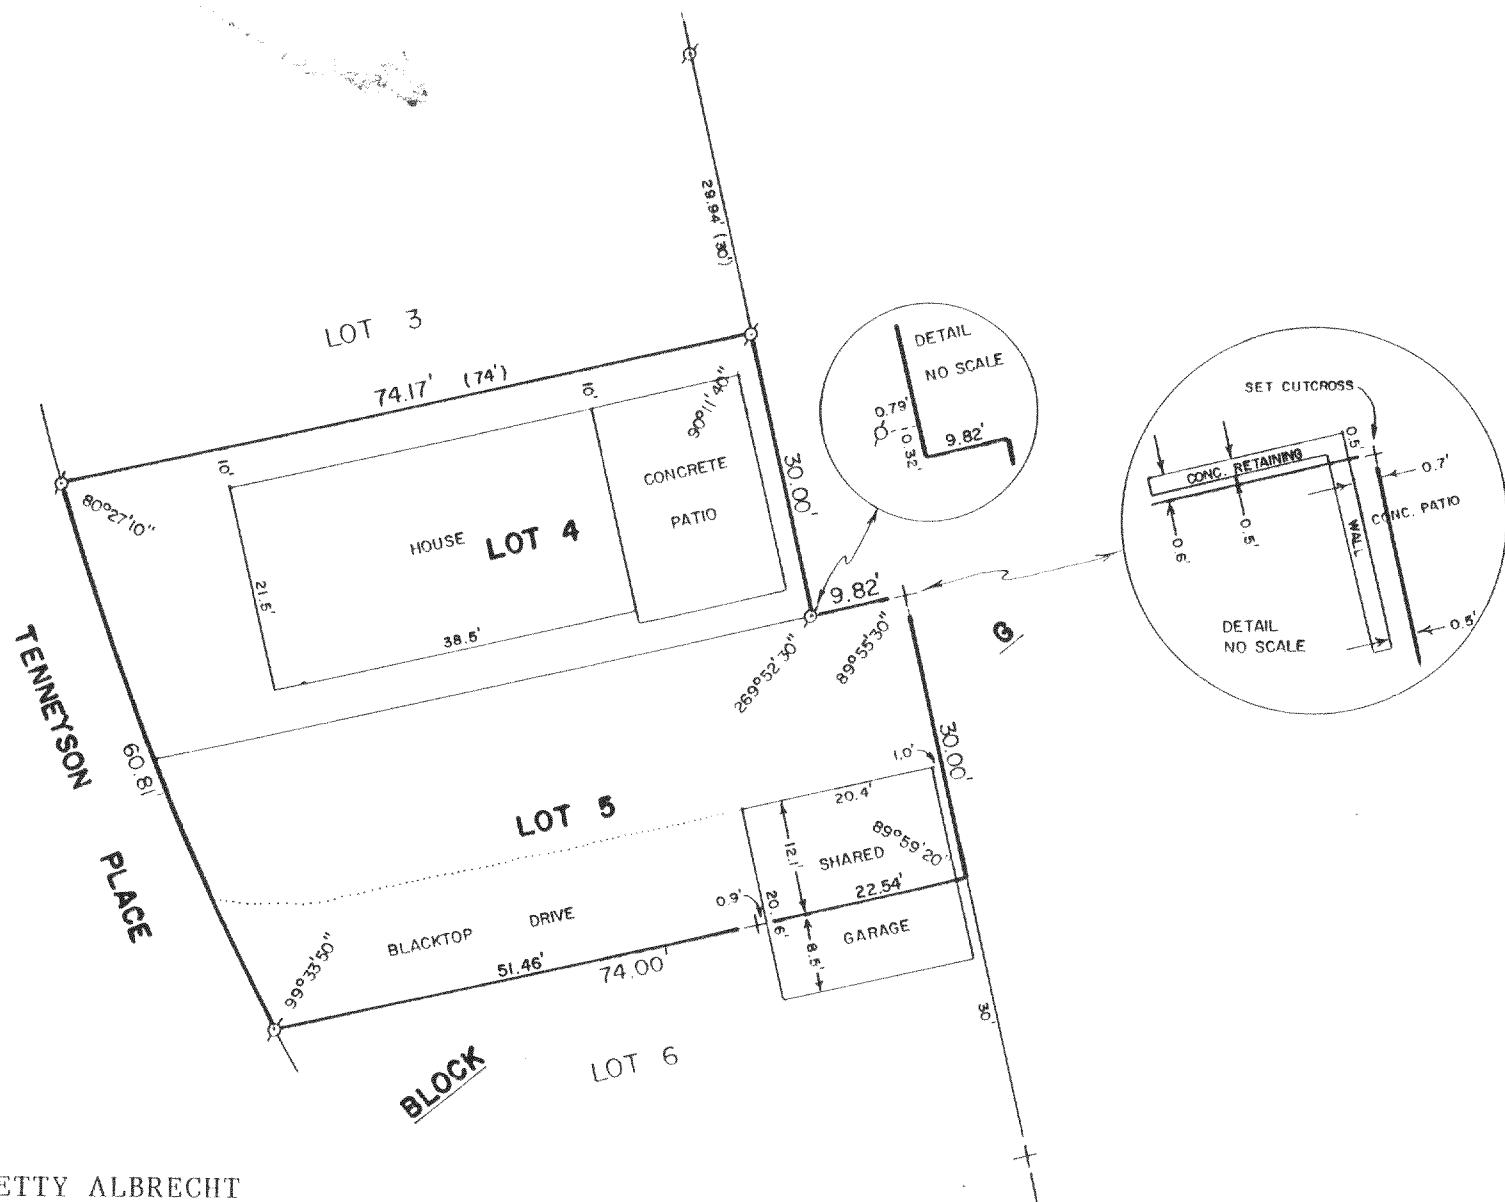

ORDERED BY: BETTY ALBRECHT  
4232 N. LEAVITT  
CHICAGO, IL. 60618




SCALE - 1"=20'

LEGEND  
 ♂ - IRON PIPE FOUND  
 + - CUTCROSS IN CONCRETE FOUND  
 ( ) - RECORDED AS

PLAT OF SURVEY OF

LOTS 4 AND 5, BLOCK "G", DELAVAN LAKE ASSEMBLY GROUNDS,  
LOCATED IN T2N, R16E, WALWORTH COUNTY, WISCONSIN.

I, DAVID F. ABELL, DO HEREBY CERTIFY  
THAT I HAVE SURVEYED THE PROPERTY  
HEREON DESCRIBED ACCORDING TO THE  
OFFICIAL RECORDS AND THAT THE PLAT  
HEREON IS A CORRECT REPRESENTATION  
OF THE PROPERTY LINES TO THE BEST OF  
MY KNOWLEDGE AND BELIEF.

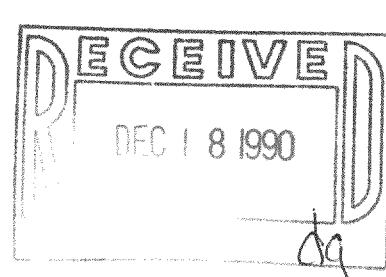

DAVID F. ABELL  
WISCONSIN REGISTERED LAND SURVEYOR, S-1596

July 12, 1990  
DATE JOB NUMBER - 90125  
NOTE: THIS IS NOT A CERTIFIED COPY UNLESS SEALED.