


ABELL
SURVEYING & MAPPING
DELAVER, WISCONSIN 53115
414-728-6737

NORTHVIEW
DRIVE

ORDERED BY: RON DESCHNER
RT. 5, BOX 330A
DELAVER, WI. 53115

OWNER: MARY MEYER

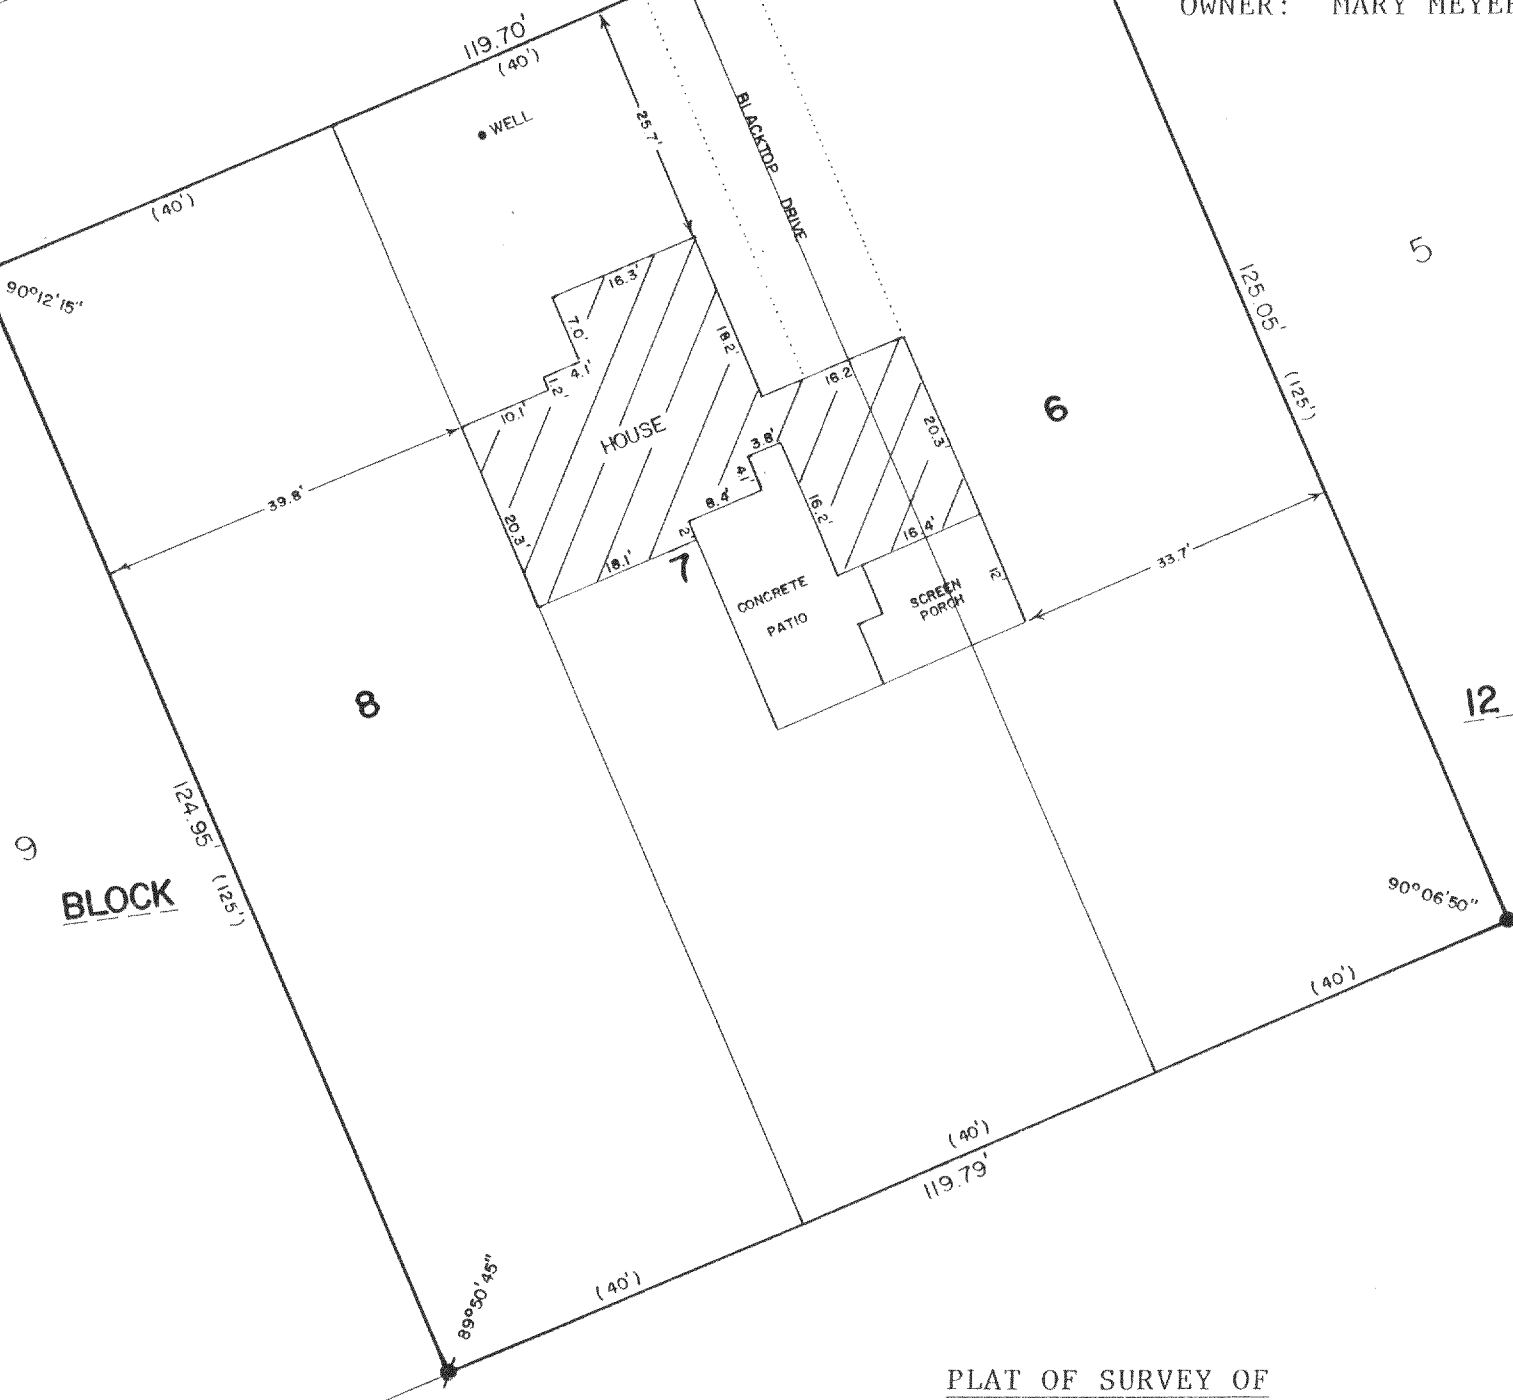

PLAT OF SURVEY OF


LOTS 6-8, BLOCK 12, DELAVAN LAKE VIEW CREST, A
SUBDIVISION LOCATED IN SECTION 31, T2N, R16E,
WALWORTH COUNTY, WISCONSIN.



SCALE - 1"=20'

LEGEND

- Ø - IRON PIPE FOUND
● - IRON PIPE IN CONCRETE FOUND
() - RECORDED AS

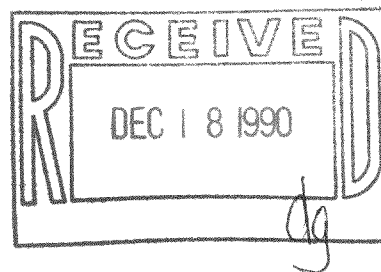

I, DAVID F. ABELL, DO HEREBY CERTIFY
THAT I HAVE SURVEYED THE PROPERTY
HEREON DESCRIBED ACCORDING TO THE
OFFICIAL RECORDS AND THAT THE PLAT
HEREON IS A CORRECT REPRESENTATION
OF THE PROPERTY LINES TO THE BEST OF
MY KNOWLEDGE AND BELIEF.

David F. Abell
DAVID F. ABELL

WISCONSIN REGISTERED LAND SURVEYOR, S-1596

July 11, 1990
DATE

JOB NUMBER - 90134

NOTE: THIS IS NOT A CERTIFIED COPY UNLESS SEALED.