


ABELL
SURVEYING & MAPPING
DELAVAN, WISCONSIN 53115
414-728-6787

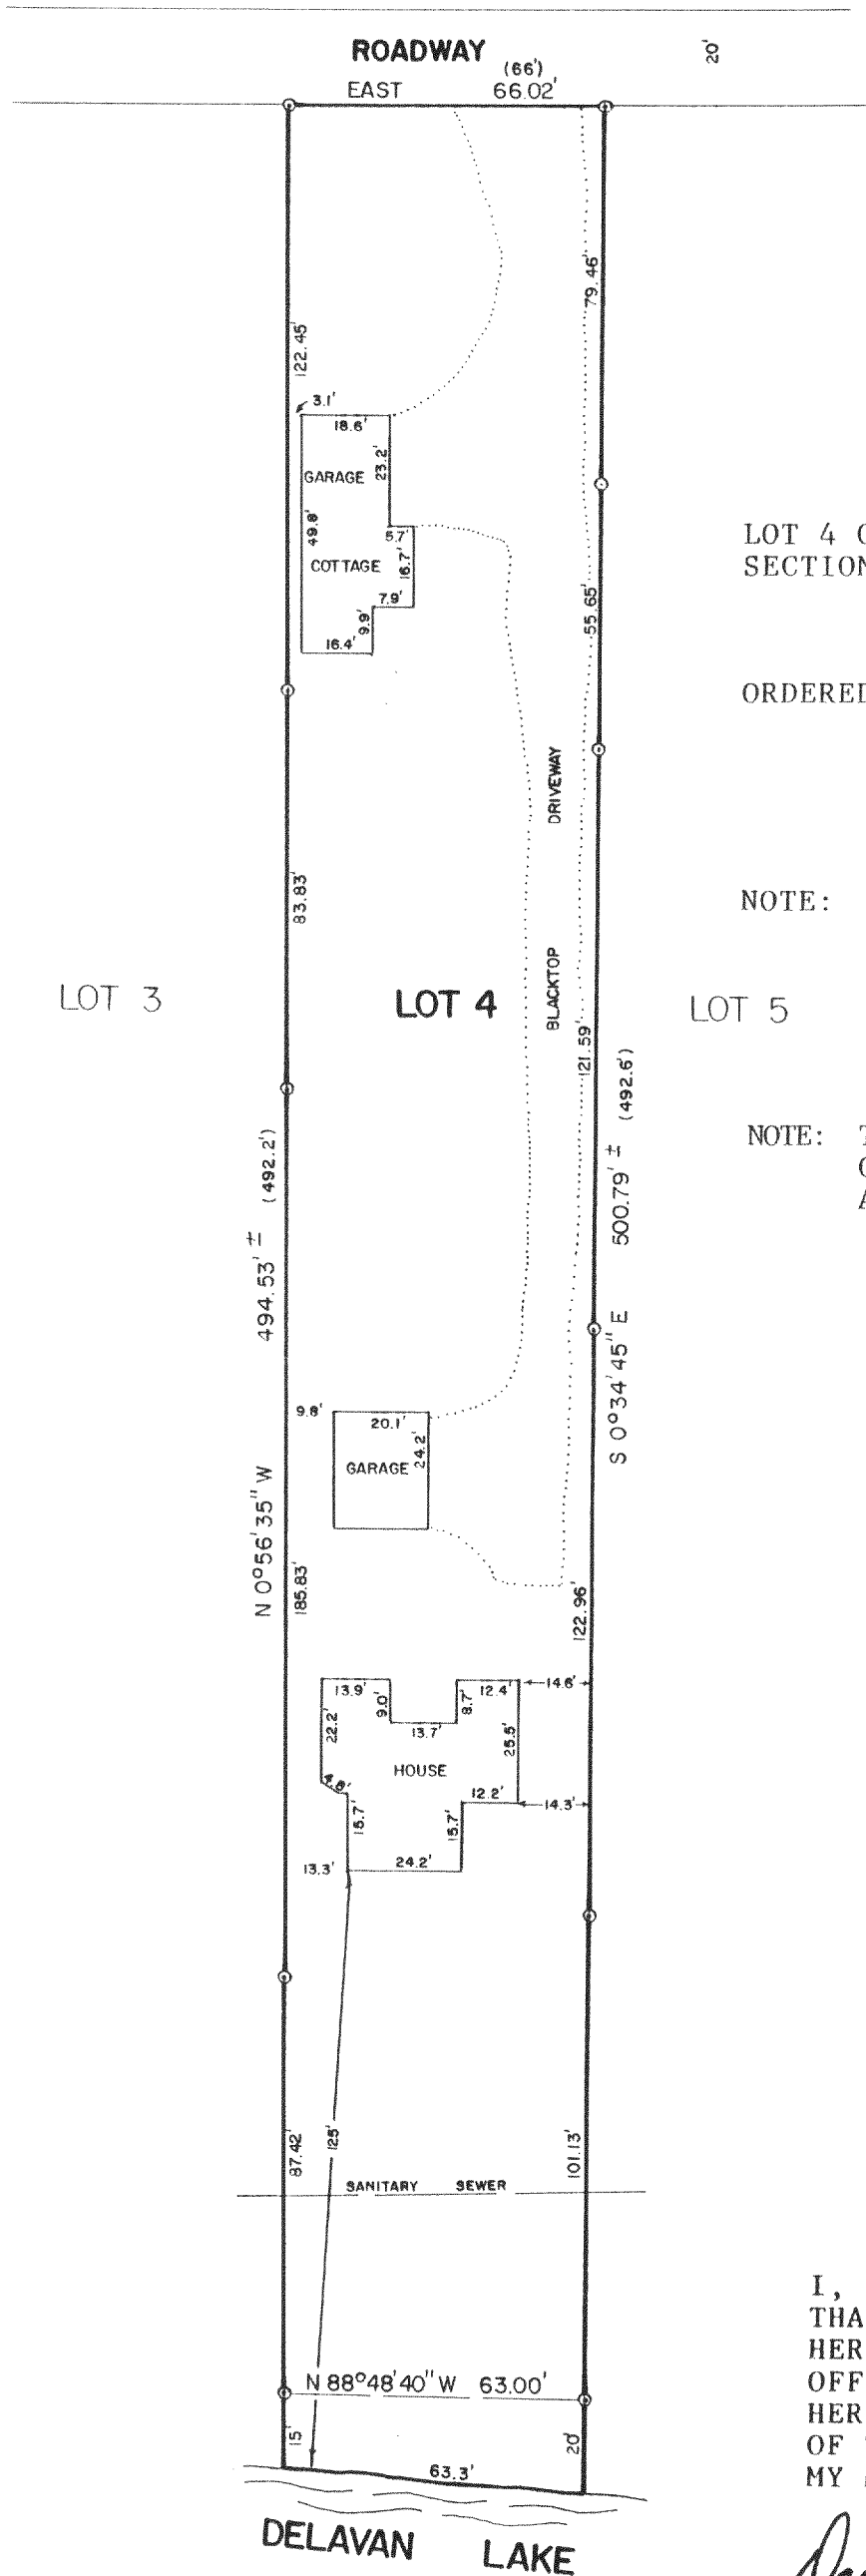

PLAT OF SURVEY OF

LOT 4 OF THE HAMLET OF BON SECOUR, LOCATED IN
SECTION 29, T2N, R16E, WALWORTH COUNTY, WISCONSIN.

ORDERED BY: JUDY CORRIGAN
P.O. BOX 553
DELAVAN, WI. 53115

NOTE: THE BEARING ON THE NORTH LINE OF LOT 4 IS
ASSUMED EAST.


NOTE: THERE IS A CHAINLINK FENCE RUNNING ALONG A PORTION
OF THE WEST LINE OF LOT 4, THIS FENCE IS ON LOT 4
AND BELONGS TO LOT 4.



SCALE - 1"=40'

LEGEND

○ - IRON PIPE FOUND
() - RECORDED AS

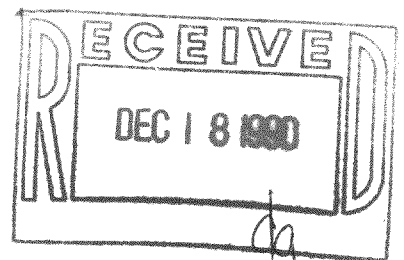

I, DAVID F. ABELL, DO HEREBY CERTIFY
THAT I HAVE SURVEYED THE PROPERTY
HEREON DESCRIBED ACCORDING TO THE
OFFICIAL RECORDS AND THAT THE PLAT
HEREON IS A CORRECT REPRESENTATION
OF THE PROPERTY LINES TO THE BEST OF
MY KNOWLEDGE AND BELIEF.

David F. Abell

DAVID F. ABELL
WISCONSIN REGISTERED LAND SURVEYOR, S-1596

June 30, 1990

DATE JOB NUMBER - 90120

NOTE: THIS IS NOT A CERTIFIED COPY UNLESS SEALED.