


ABELL
SURVEYING & MAPPING
DELAVER, WISCONSIN 53115
414-728-6737

ORDERED BY: FRANK FARRINGTON
310 McCLURE AVE.
ELGIN, IL. 60123

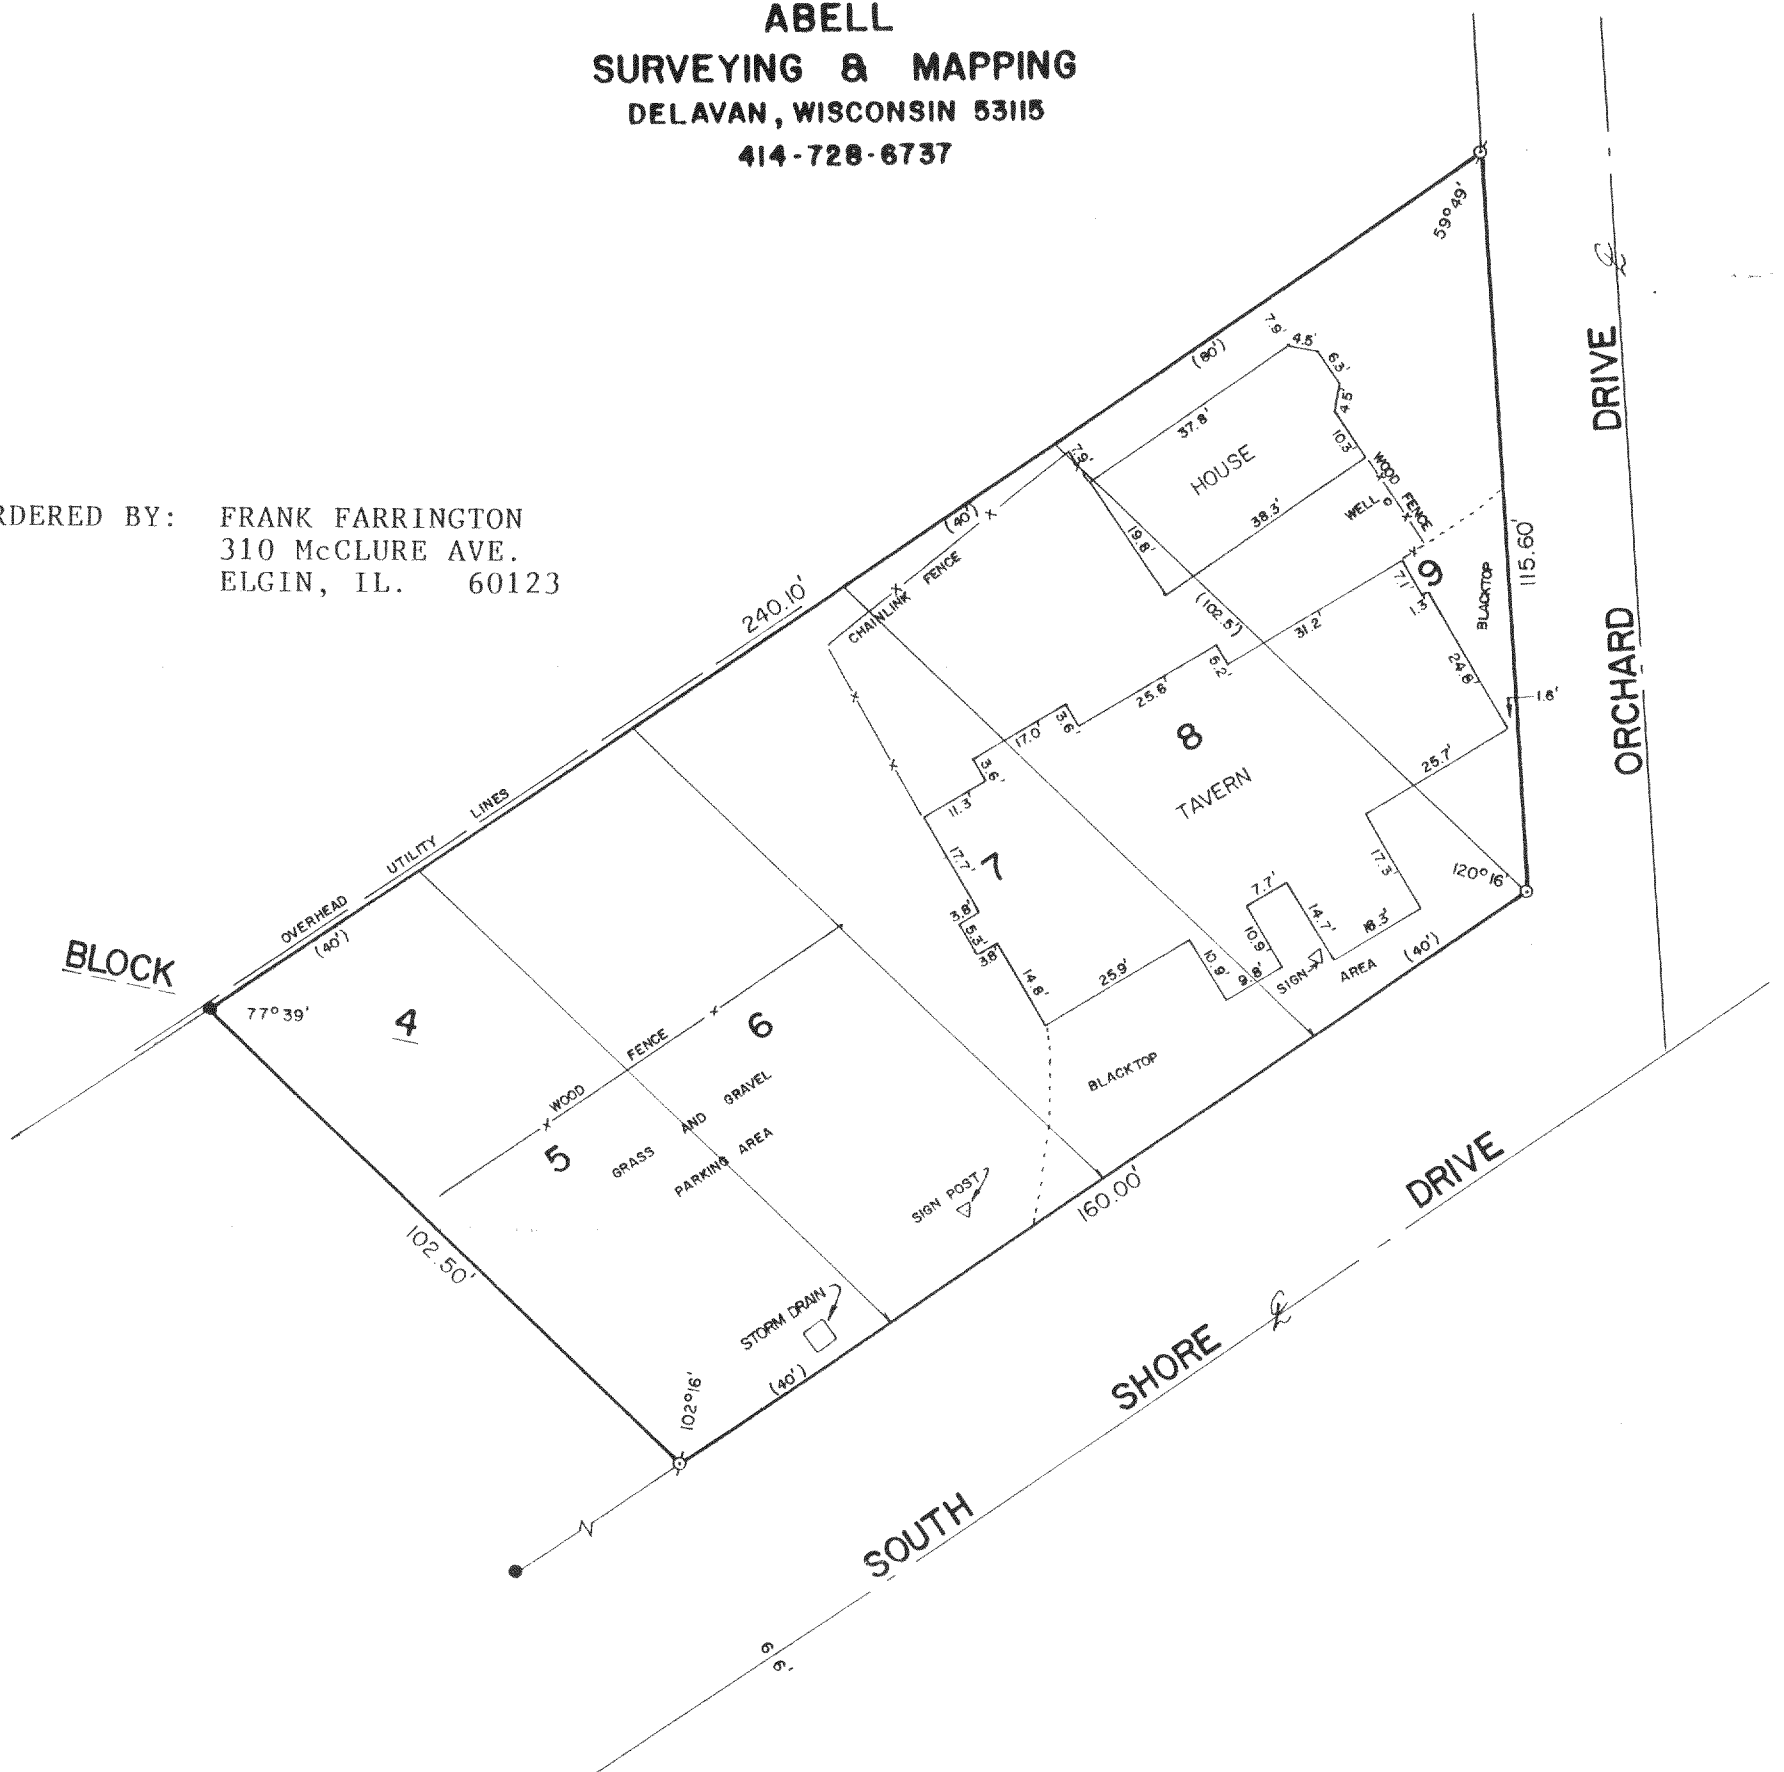

PLAT OF SURVEY OF


LOTS 5-9, BLOCK 4 OF SOUTH SHORE MANOR, A SUBDIVISION
LOCATED IN T2N,R16E, WALWORTH COUNTY, WISCONSIN.



SCALE - 1"=30'

LEGEND

- ⌘ - IRON PIPE FOUND
- - IRON ROD FOUND
- - IRON ROD SET
- () - RECORDED AS

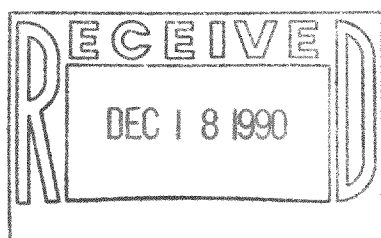

I HEREBY CERTIFY THAT I HAVE SURVEYED THE ABOVE DESCRIBED PROPERTY AND THAT THE ABOVE MAP IS A TRUE REPRESENTATION THEREOF AND SHOWS THE SIZE AND LOCATION OF THE PROPERTY, ITS EXTERIOR BOUNDARIES, THE LOCATION OF ALL VISIBLE STRUCTURES AND DIMENSIONS OF ALL PRINCIPAL BUILDINGS THEREON, BOUNDARY FENCES, APPARENT EASEMENTS, ROADWAYS AND VISIBLE ENCROACHMENTS, IF ANY, TO THE BEST OF MY KNOWLEDGE AND BELIEF.

THIS SURVEY IS MADE FOR THE USE OF THE PRESENT OWNERS OF THE PROPERTY, AND ALSO THOSE WHO PURCHASE, MORTGAGE, OR GUARANTEE THE TITLE THERETO WITHIN ONE (1) YEAR FROM DATE HEREOF.

David F. Abell

DAVID F. ABELL
WISCONSIN REGISTERED LAND SURVEYOR, S-1596

October 10, 1990

DATE JOB NUMBER - 90199

NOTE: THIS IS NOT A CERTIFIED COPY UNLESS SEALED.