



ABELL
SURVEYING & MAPPING
 DELAVAN, WISCONSIN 53115
 414-728-8787

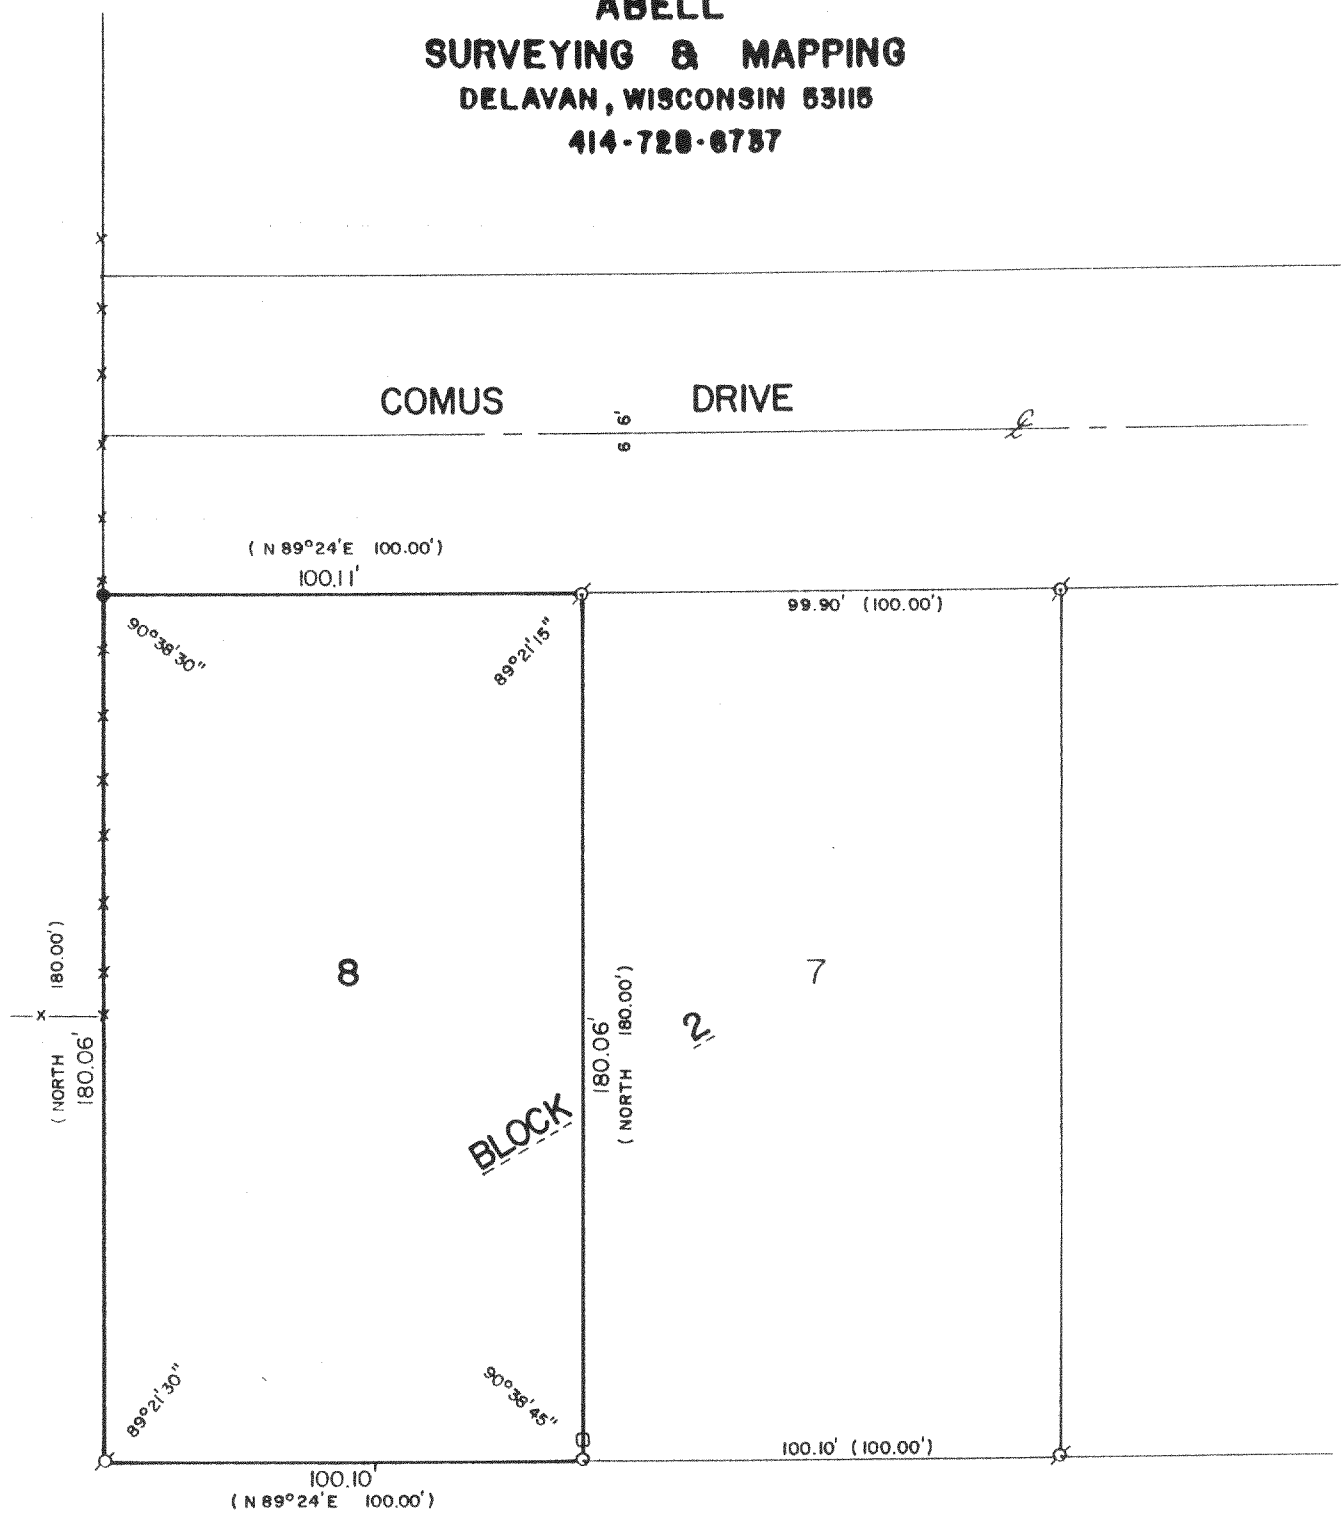

PLAT OF SURVEY OF

LOT 8 OF HANSEN'S SUBDIVISION, LOCATED IN SECTION 8,
 T2N, R16E, WALWORTH COUNTY, WISCONSIN.

ORDERED BY: RE/MAX - LAKE GENEVA
 18 W. GENEVA ST.
 WILLIAMS BAY, WI. 53191

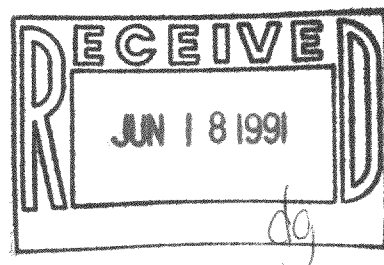

SCALE - 1"=40'

LEGEND

- o - IRON PIPE FOUND
- - CONCRETE MONUMENT FOUND
- o - IRON PIPE SET
- o - UTILITY PED.
- x - WIRE FENCE
- () - RECORDED AS

I HEREBY CERTIFY THAT I HAVE SURVEYED THE ABOVE DESCRIBED PROPERTY AND THAT THE ABOVE MAP IS A TRUE REPRESENTATION THEREOF AND SHOWS THE SIZE AND LOCATION OF THE PROPERTY, ITS EXTERIOR BOUNDARIES, THE LOCATION OF ALL VISIBLE STRUCTURES AND DIMENSIONS OF ALL PRINCIPAL BUILDINGS THEREON, BOUNDARY FENCES, APPARENT EASEMENTS, ROADWAYS AND VISIBLE ENCROACHMENTS, IF ANY, TO THE BEST OF MY KNOWLEDGE AND BELIEF.

THIS SURVEY IS MADE FOR THE USE OF THE PRESENT OWNERS OF THE PROPERTY, AND ALSO THOSE WHO PURCHASE, MORTGAGE, OR GUARANTEE THE TITLE THEREIN WITHIN ONE (1) YEAR FROM DATE HEREOF.

David F. Abell
 DAVID F. ABELL
 WISCONSIN REGISTERED LAND SURVEYOR, S-1596

December 19, 1990

DATE: December 19, 1990 JOB NUMBER: 90240
 NOTE: THIS IS NOT A CERTIFIED COPY UNLESS SEALED.

216-1419

FH 00014A