



ABELL
SURVEYING & MAPPING
 DELAVAN, WISCONSIN 53115
 414-728-6737

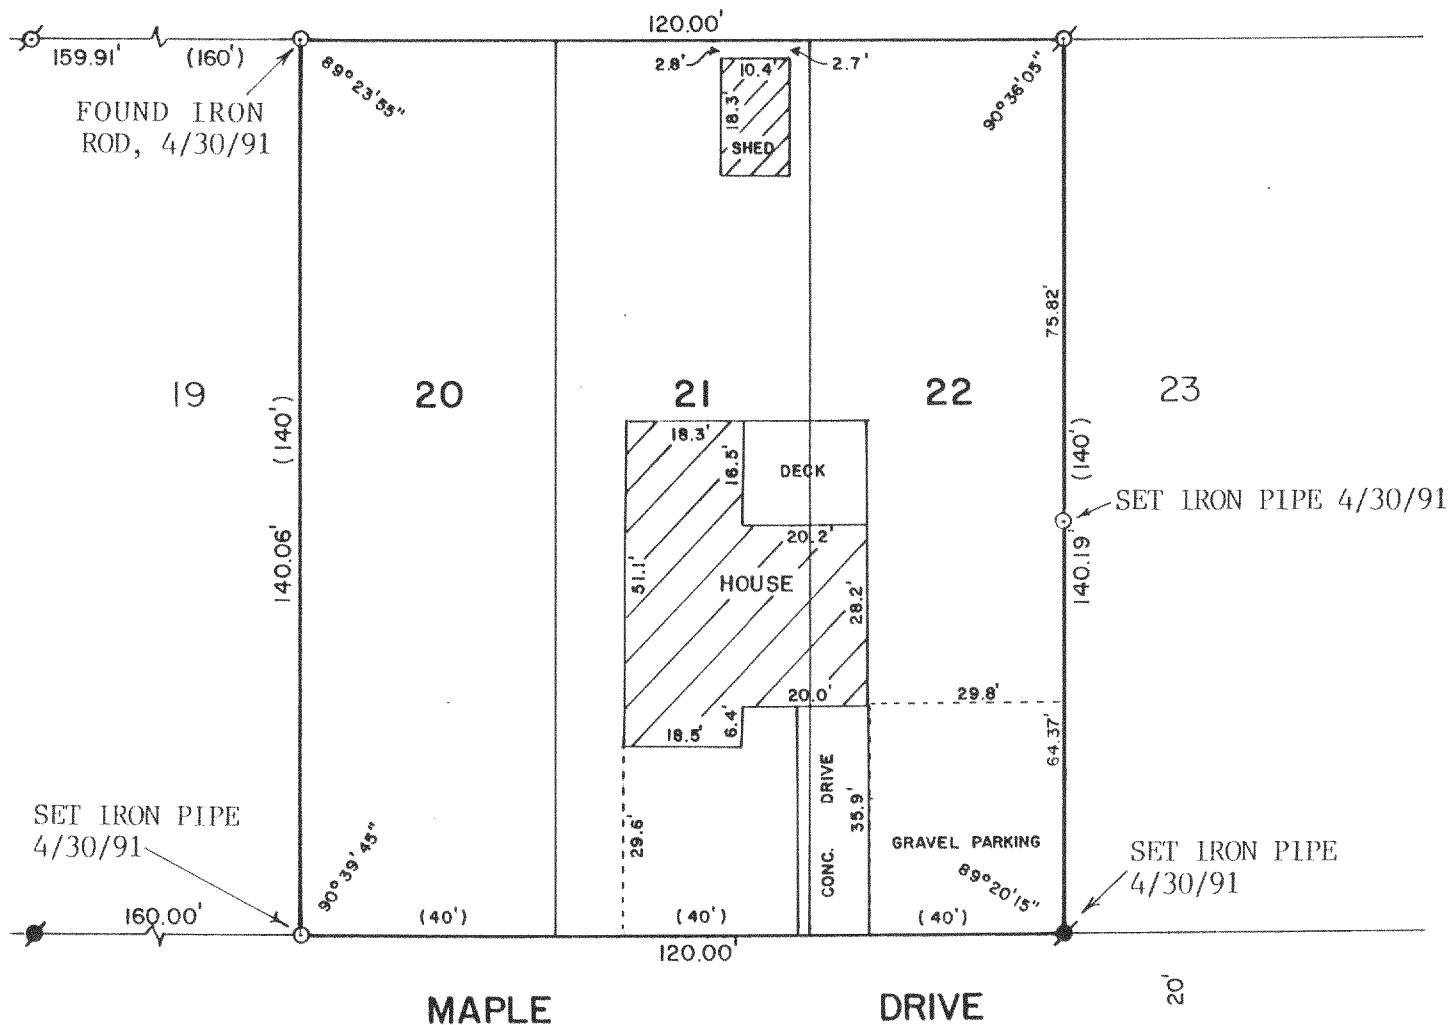

PLAT OF SURVEY OF

LOTS 20-22 OF KRUMHAAR'S ADDITION TO RAVENSWOOD,
 TOWN 2 NORTH, RANGE 16 EAST, WALWORTH COUNTY,
 WISCONSIN.

ORDERED BY: CENTURY 21 - SKANDIA REALTY
 312 S. 7th STREET
 DELAVAN, WI. 53115

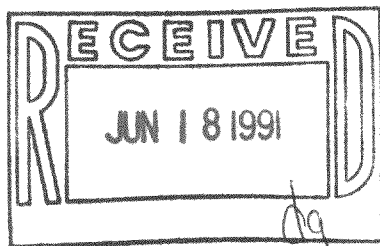

REVISED: MAY 1, 1991
 ORDERED BY: RON MUNDRO
 1774 FARWELL ST.
 DES PLAINES, IL. 60018



SCALE - 1"=30'

LEGEND

- ⊗ - IRON PIPE FOUND
- - IRON ROD FOUND
- - IRON ROD SET
- () - RECORDED AS

I, DAVID F. ABELL, DO HEREBY CERTIFY
 THAT I HAVE SURVEYED THE PROPERTY
 HEREON DESCRIBED ACCORDING TO THE
 OFFICIAL RECORDS AND THAT THE PLAT
 HEREON IS A CORRECT REPRESENTATION
 OF THE PROPERTY LINES TO THE BEST OF
 MY KNOWLEDGE AND BELIEF.

David F. Abell

DAVID F. ABELL
 WISCONSIN REGISTERED LAND SURVEYOR, S-1596

November 11, 1987
 DATE

JOB NUMBER - 87175

NOTE: THIS IS NOT A CERTIFIED COPY UNLESS SEALED.