


ABELL
SURVEYING & MAPPING
DELAVER, WISCONSIN 53115
414-728-6737

WILLOW
LANE
20' WIDE

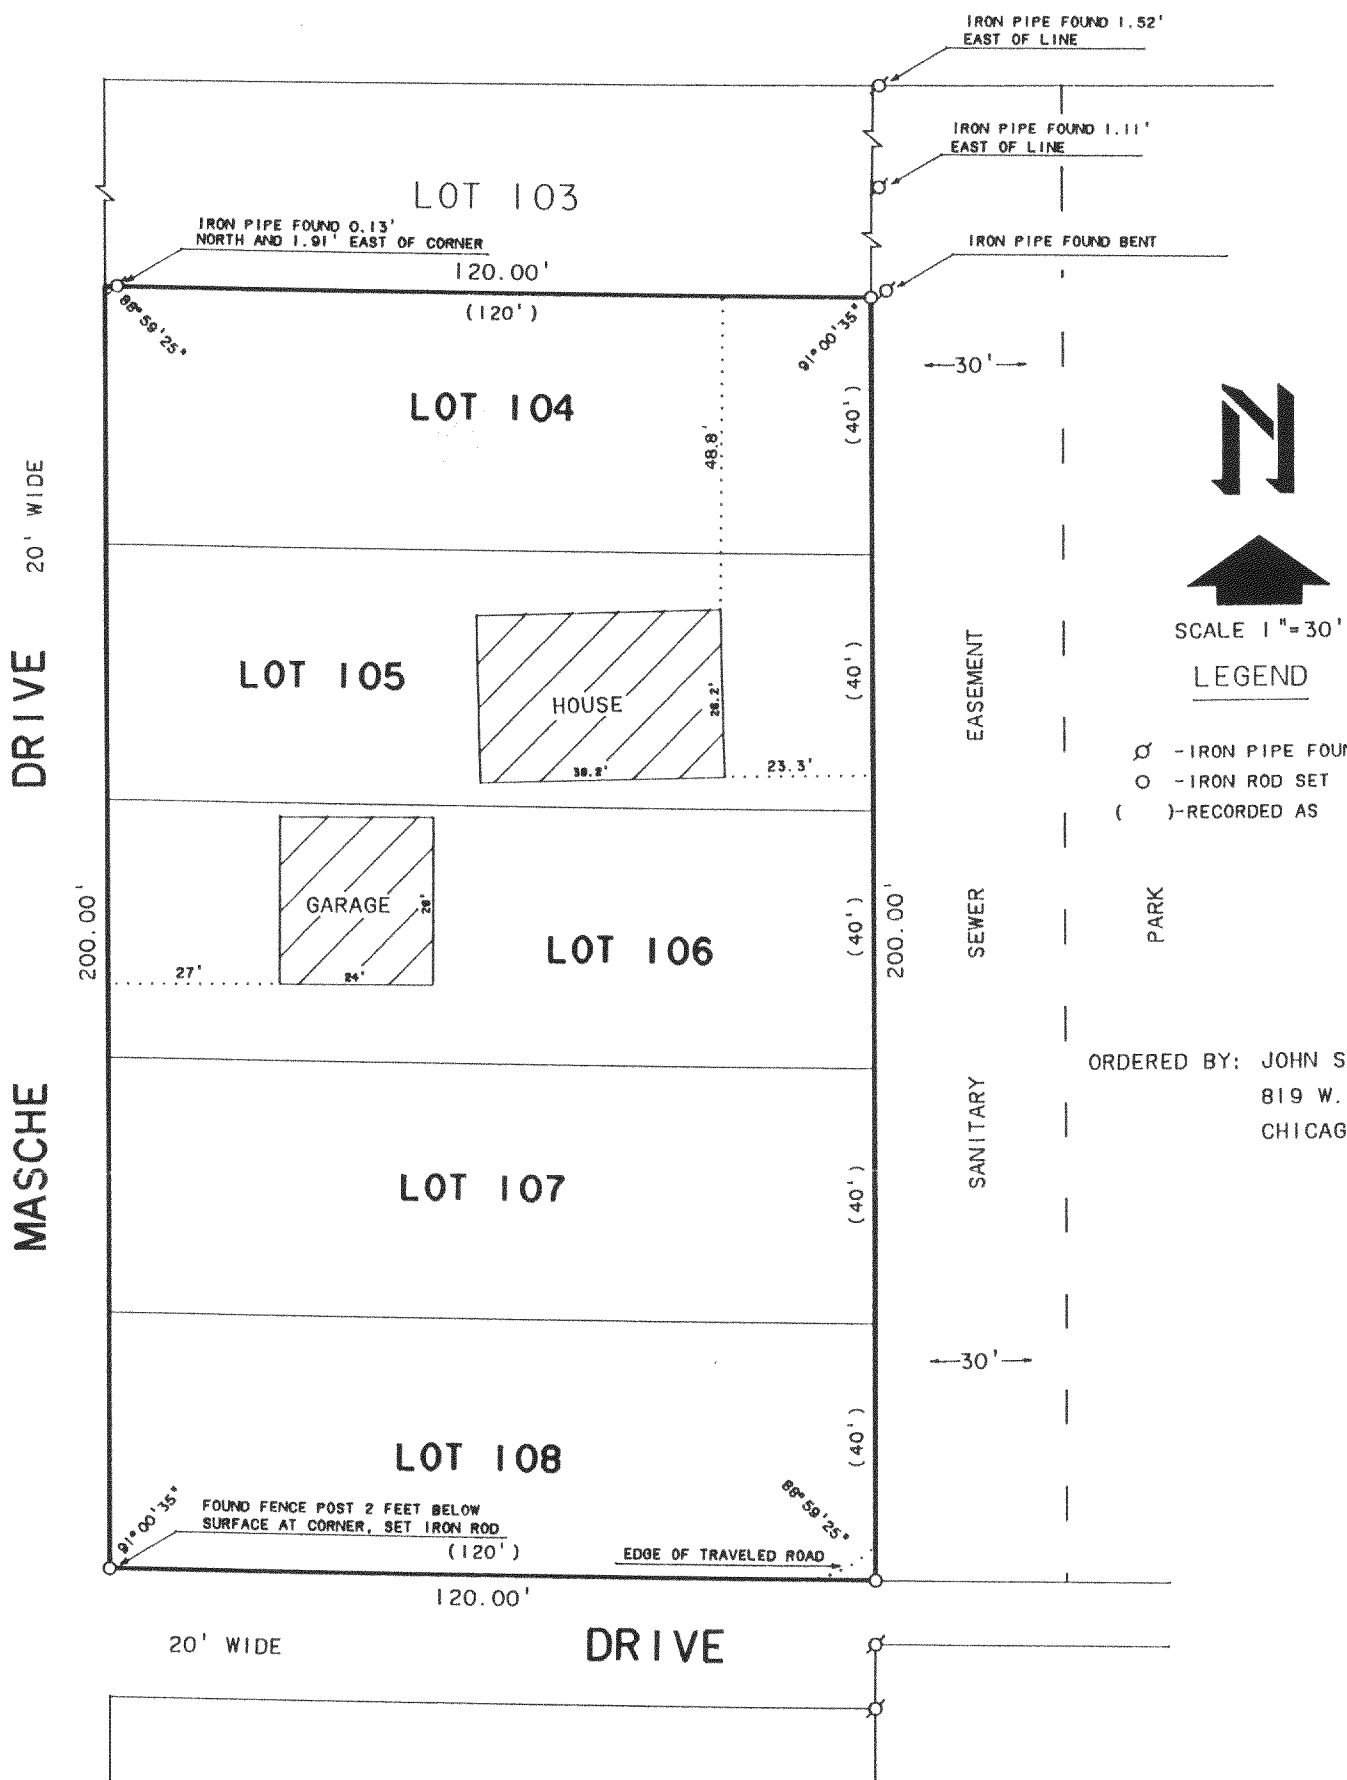


N
SCALE 1"=30'
LEGEND

⊗ - IRON PIPE FOUND
○ - IRON ROD SET
() - RECORDED AS

ORDERED BY: JOHN SHAFER
819 W. MORSE AVE.
CHICAGO, IL. 60626

PLAT OF SURVEY OF

LOTS 104-108, OF KRUMHAAR'S 2ND ADDITION TO RAVENSWOOD
SUBDIVISION, T2N.R16E, WALWORTH COUNTY, WISCONSIN.

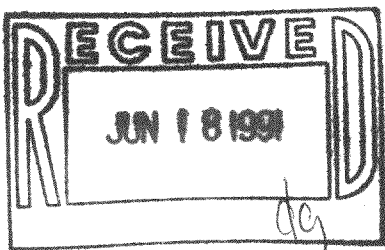

I, DAVID F. ABELL, DO HEREBY CERTIFY THAT I HAVE SURVEYED THE PROPERTY HEREON
DESCRIBED ACCORDING TO THE OFFICAL RECORDS AND THAT THE PLAT HEREON IS A
CORRECT REPRESENTATION OF THE PROPERTY LINES TO THE BEST OF MY KNOWLEDGE AND
BELIEF

David F. Abell
DAVID F. ABELL
WISCONSIN REGISTERED LAND SURVEYOR, S-1596

January 2, 1991
DATE JOB NUMBER - 90179
NOTE: THIS IS NOT A CERTIFIED COPY UNLESS SEALED.

FRA2 00004
FRA2 00005
FRA2 00006