

ABELL  
SURVEYING & MAPPING  
DELAVAL, WISCONSIN 53115

414-728-6737

LOT 10


NORTH SHORE DRIVE



SCALE 1" = 20'

LEGEND

- - IRON PIPE FOUND
- - IRON PIPE SET
- ✗ - FENCE
- ( ) - RECORDED AS

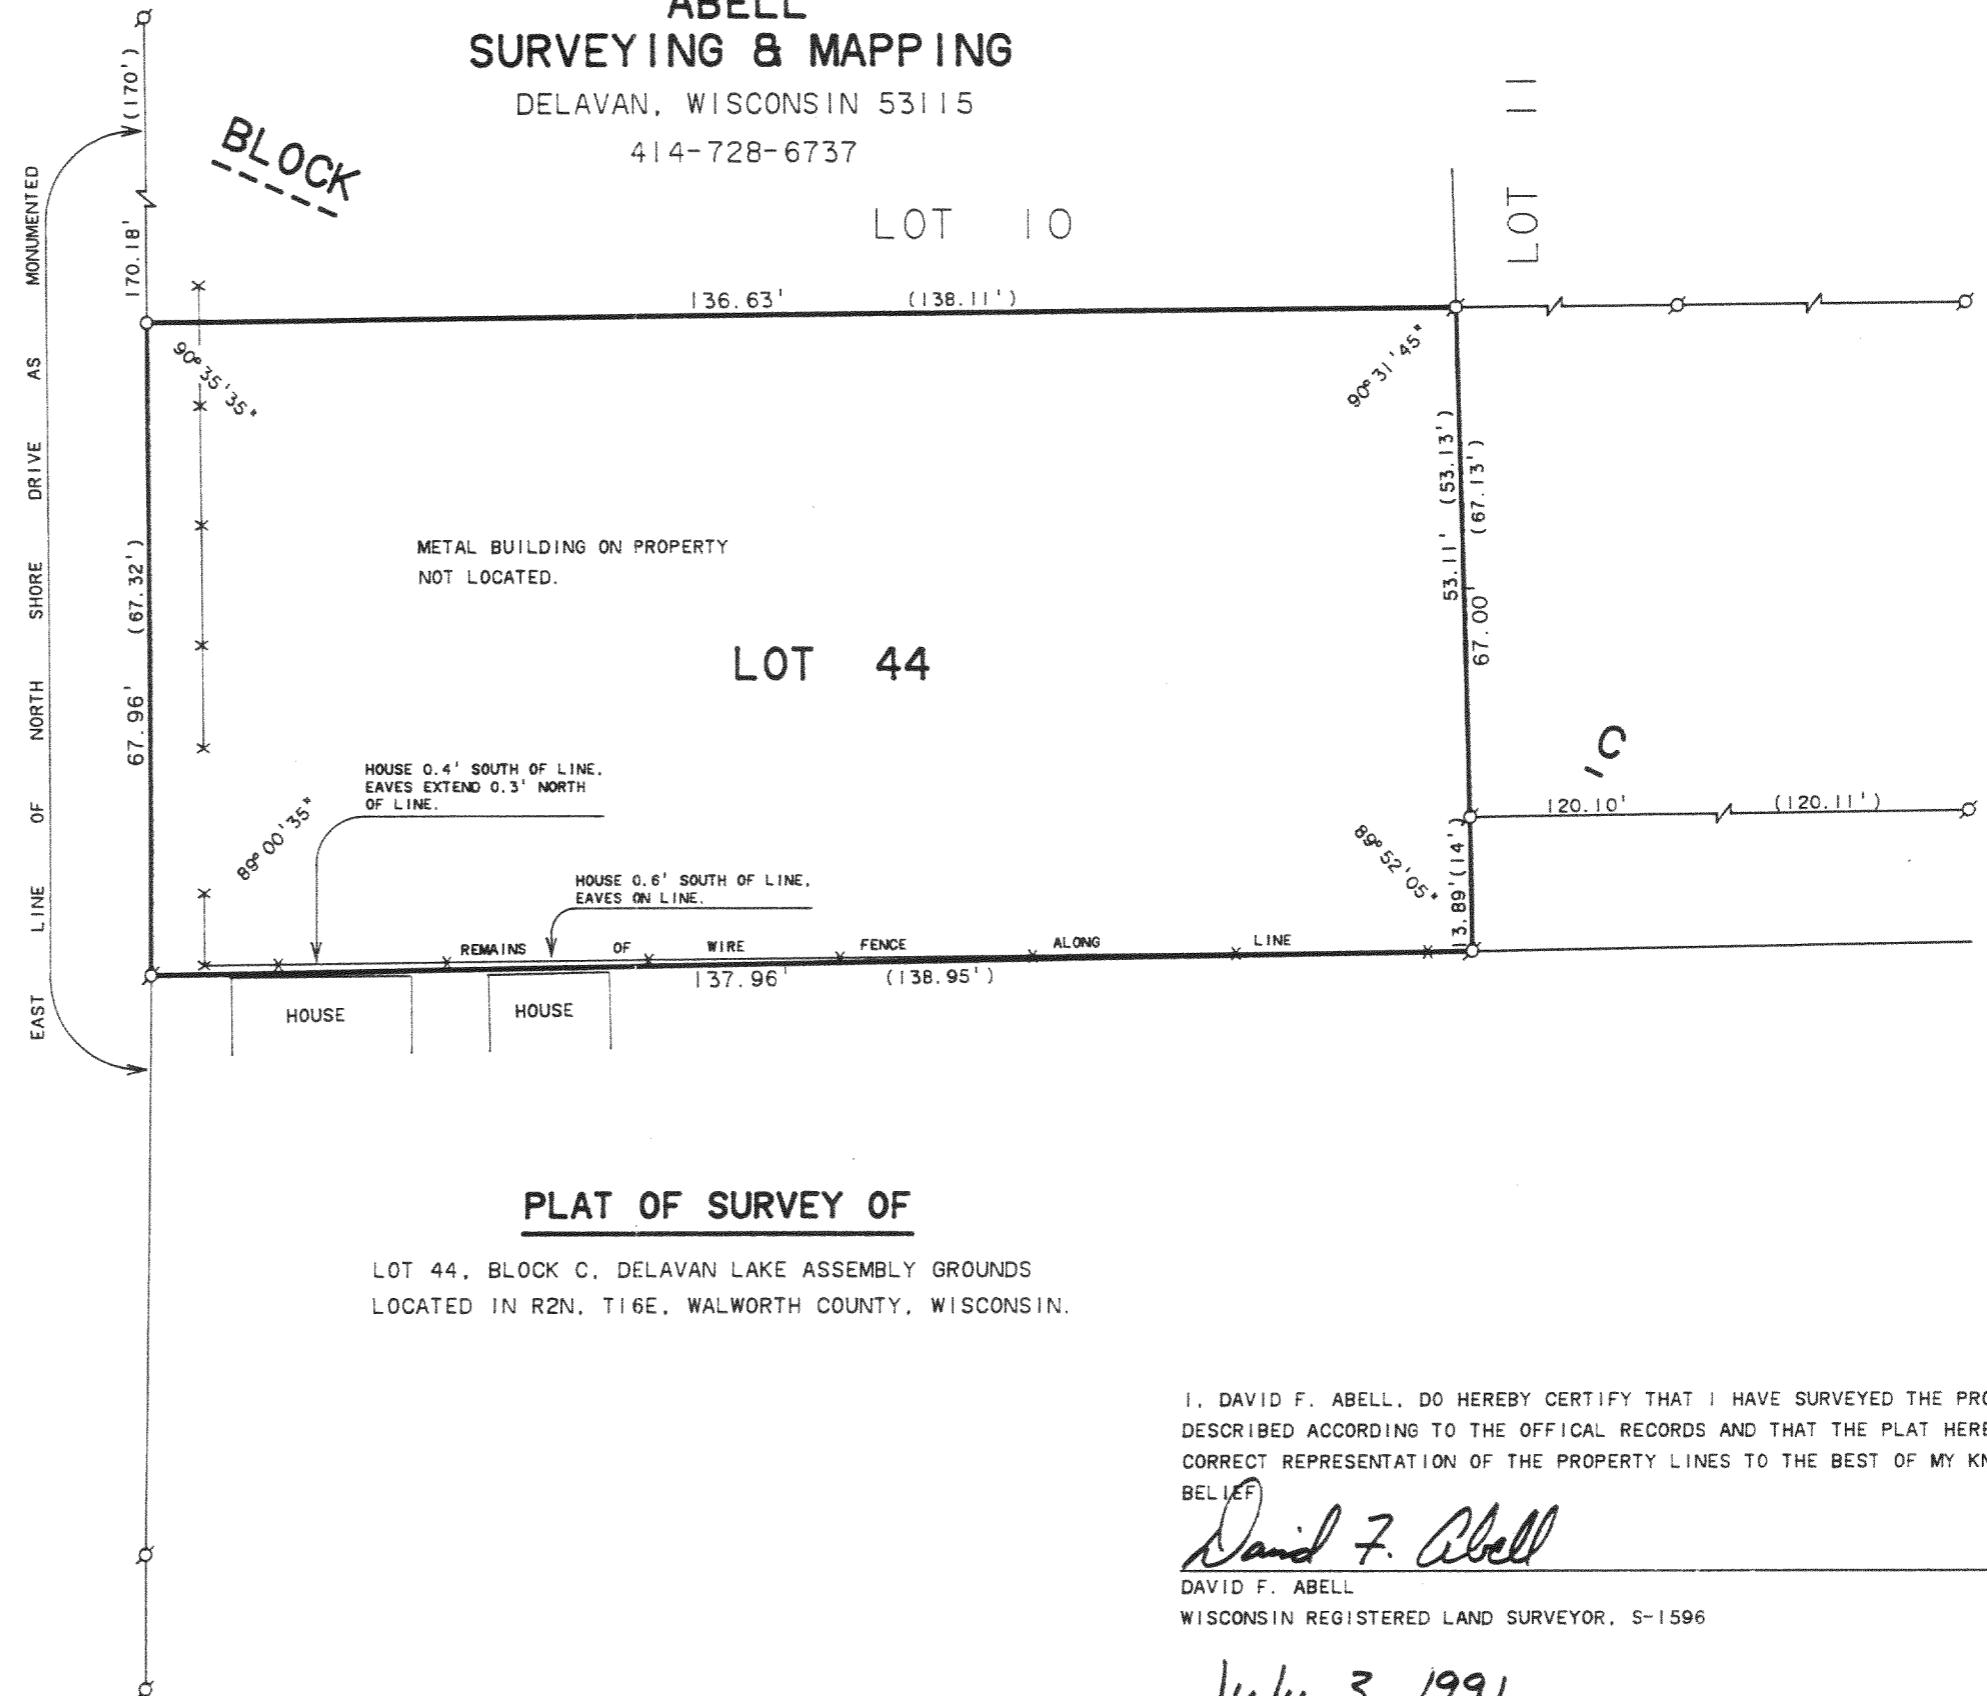

216-1477

FDLA -44F