

JUNIOR TERRACE

ABELL
SURVEYING & MAPPING

DELAVAN, WISCONSIN 53115


414-728-6737

LOT 18

LOT 19

LOT 20

LOT 21

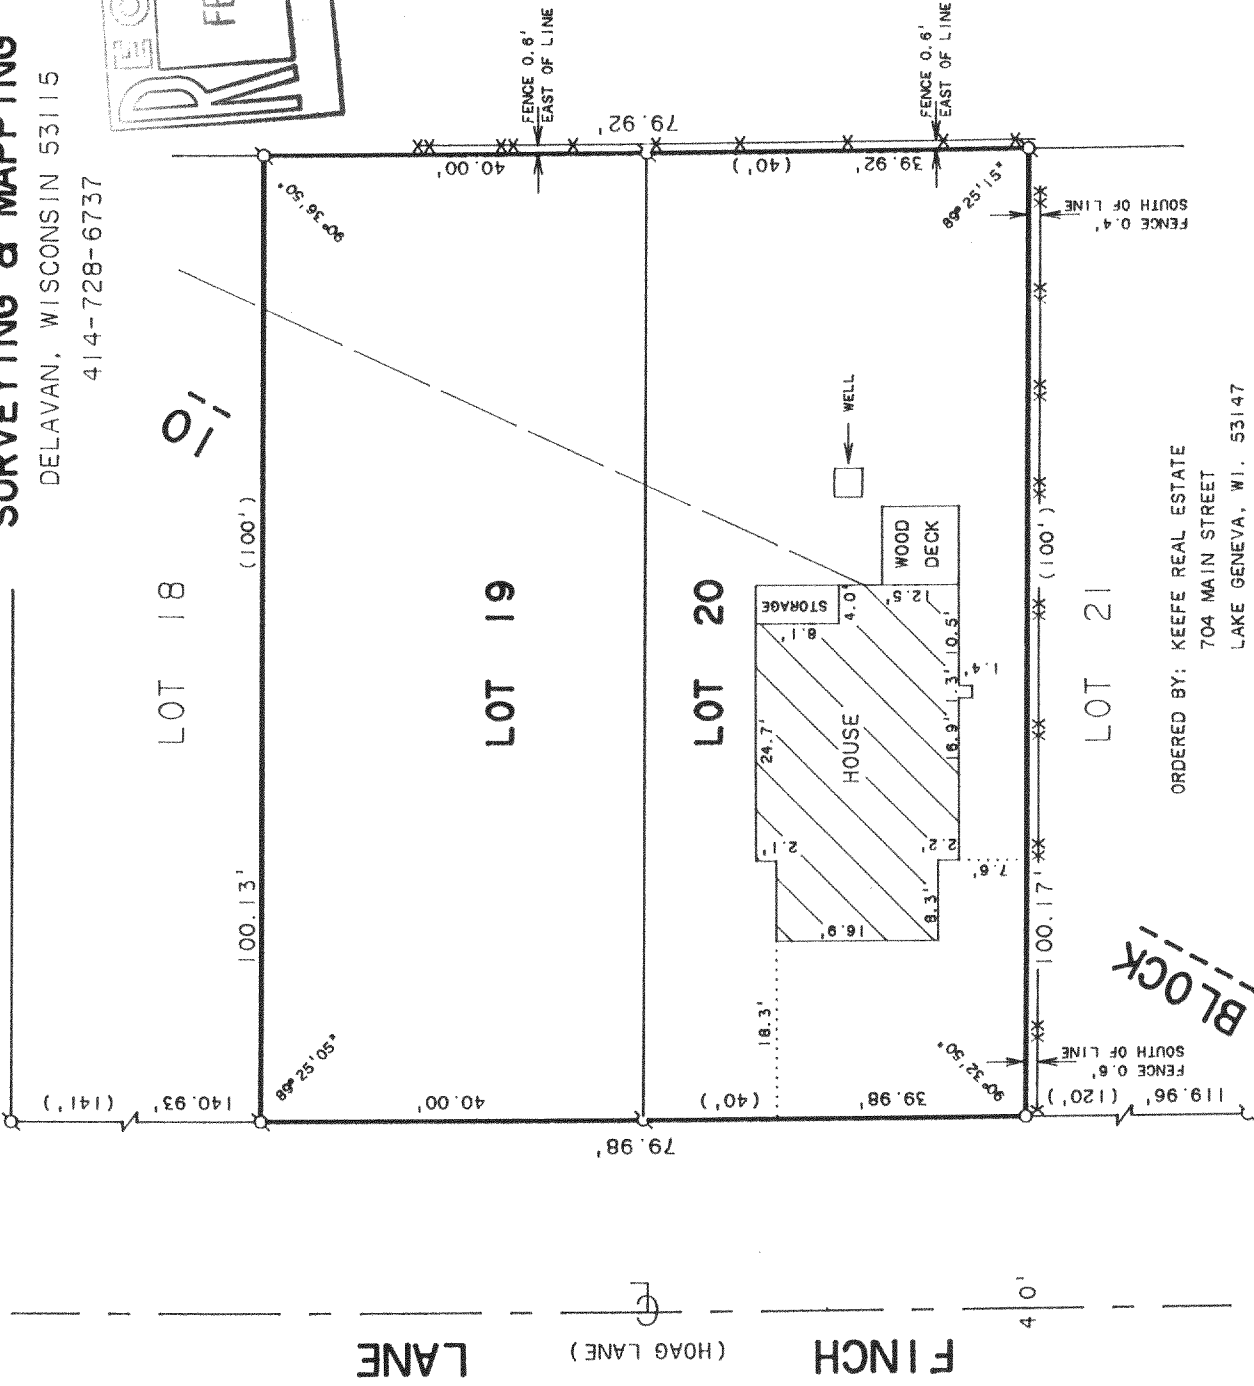

LANE


(HOAG LANE)

FINCH

40'

BLOCK

ORDERED BY: KEEFE REAL ESTATE
704 MAIN STREET
LAKE GENEVA, WI. 53147

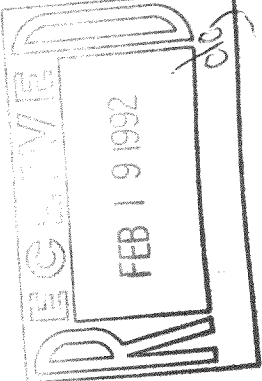

SCALE 1"=20'

LEGEND

- Ø - IRON PIPE FOUND
- ~ - IRON PIN FOUND
- - IRON PIPE SET
- - WIRE FENCE
- - WOOD FENCE
- - OVERHEAD UTILITY LINES
- () - RECORDED AS

PLAT OF SURVEY OF

LOTS 19 & 20, BLOCK 10, SOUTH SHORE MANOR
FIRST ADDITION, LOCATED IN T2N, R16E, WALWORTH
COUNTY, WISCONSIN.

I HEREBY CERTIFY THAT I HAVE SURVEYED THE ABOVE DESCRIBED PROPERTY AND THAT THE ABOVE MAP IS A TRUE REPRESENTATION THEREOF AND SHOWS THE SIZE AND LOCATION OF THE PROPERTY, ITS EXTERIOR BOUNDARIES, THE LOCATION OF ALL VISIBLE STRUCTURES AND DIMENSIONS OF ALL PRINCIPAL BUILDINGS THEREON, BOUNDARY FENCES, APPARENT EASEMENTS, ROADWAYS AND VISIBLE ENCROACHMENTS, IF ANY, TO THE BEST OF MY KNOWLEDGE AND BELIEF.

THIS SURVEY IS MADE FOR THE USE OF THE PRESENT OWNERS OF THE PROPERTY, AND ALSO THOSE WHO PURCHASE, MORTGAGE, OR GUARANTEE THE TITLE THERETO WITHIN ONE (1) YEAR FROM DATE HEREOF.

David F. Abell

DAVID F. ABELL
WISCONSIN REGISTERED LAND SURVEYOR, S-1596

December 12, 1991

DATE JOB NUMBER - 91262
NOTE: THIS IS NOT A CERTIFIED COPY UNLESS SEALED.

216-1513

FSS1-25