


ABELL SURVEYING & MAPPING


DELAVER, WISCONSIN 53115

414-728-6737

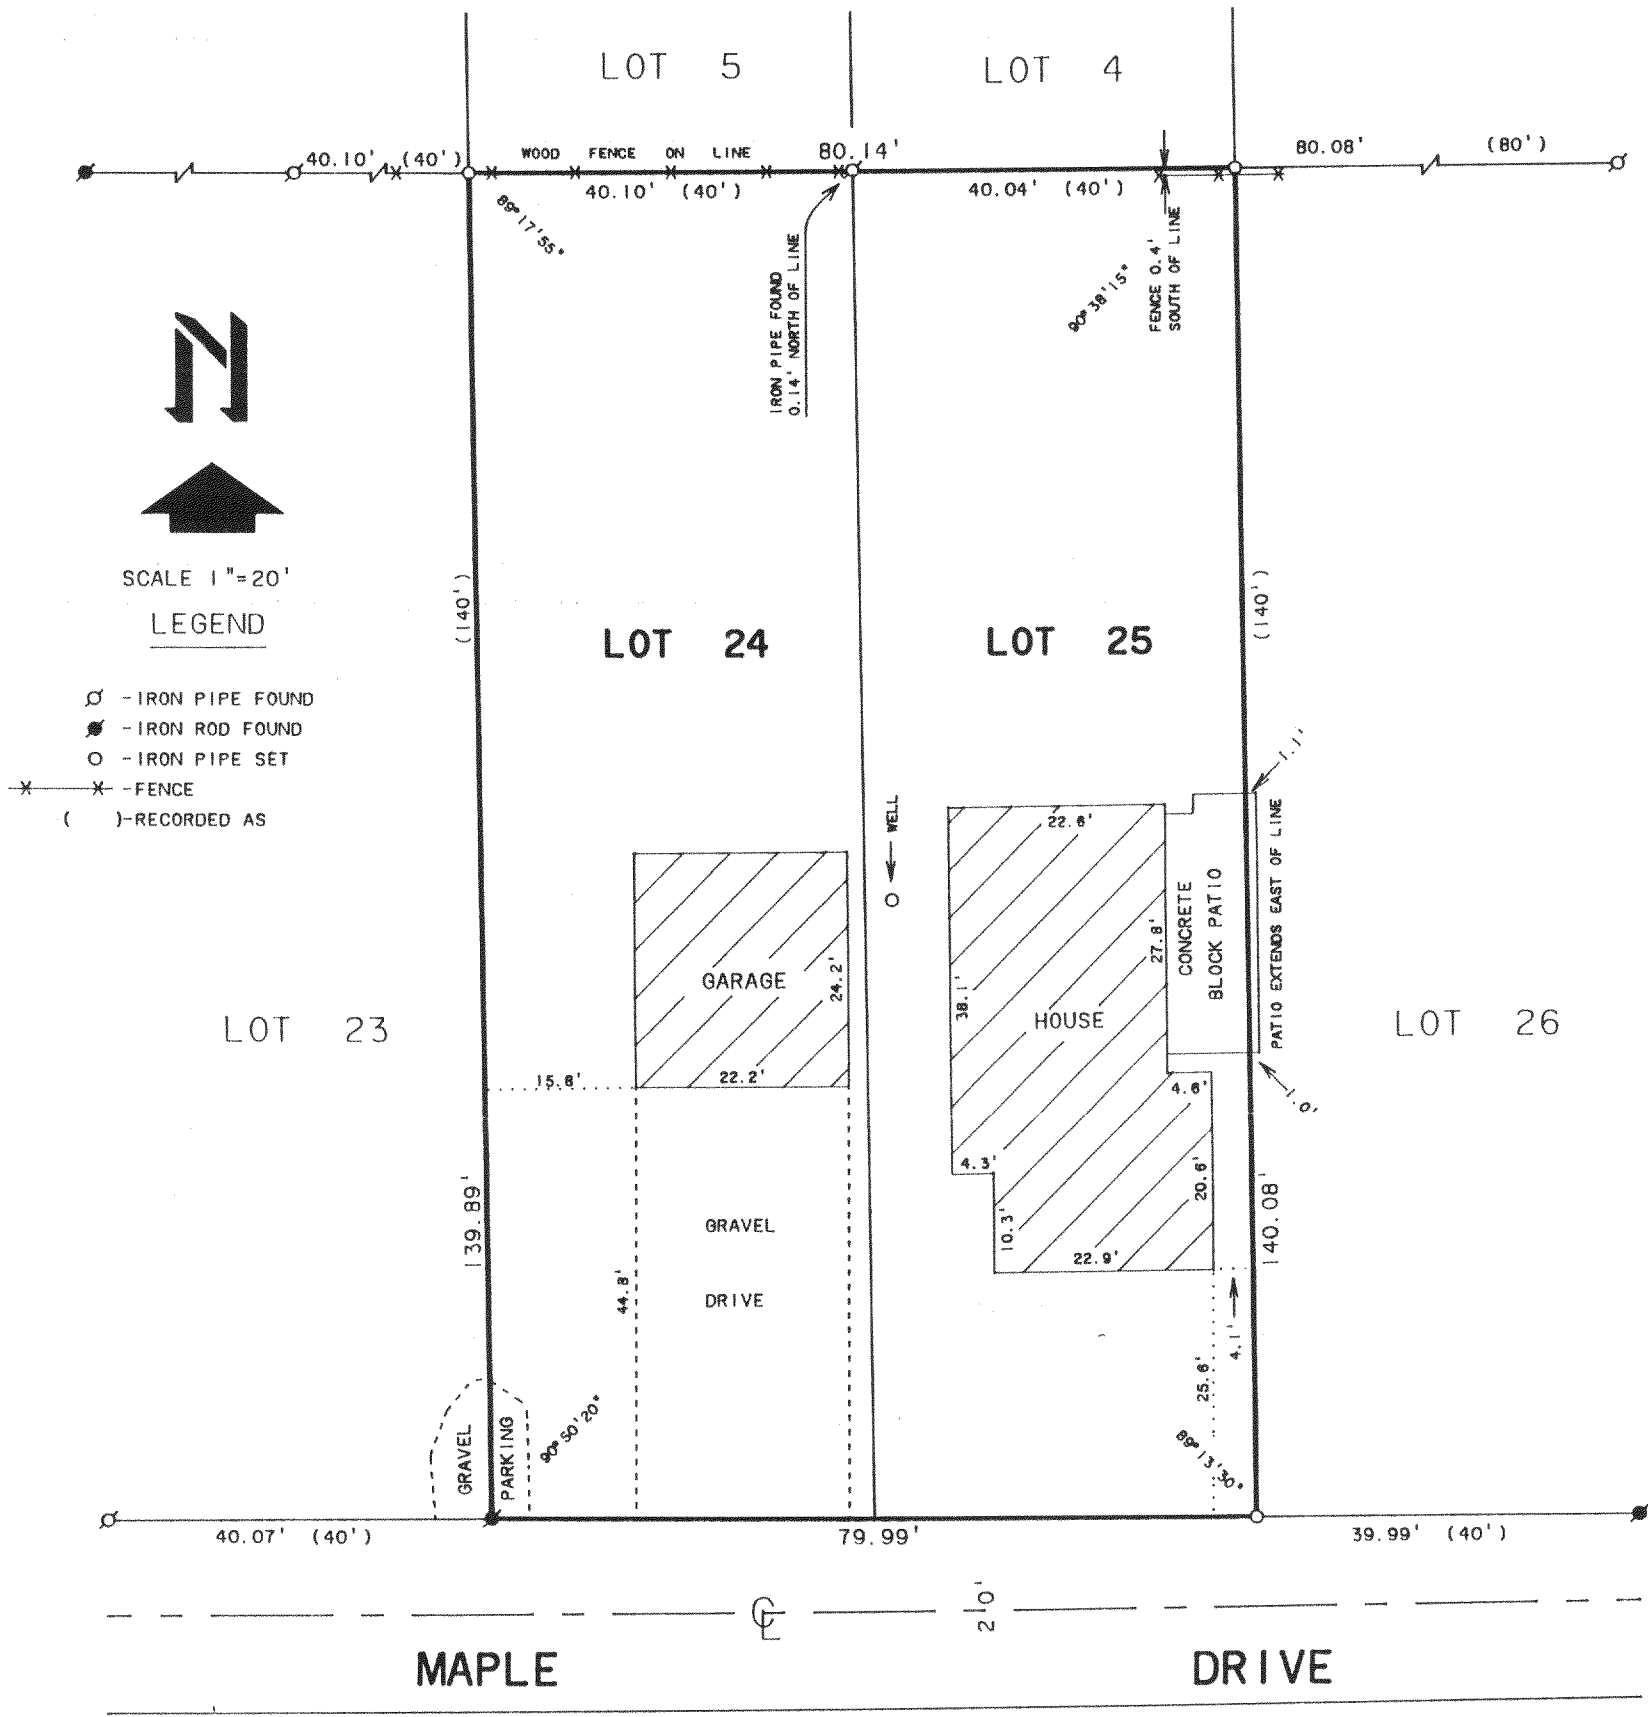

PLAT OF SURVEY OF

LOTS 24 AND 25 OF KRUMHAAR'S ADDITION TO RAVENSWOOD,
A SUBDIVISION LOCATED IN T2N. R16E. WALWORTH
COUNTY, WISCONSIN.

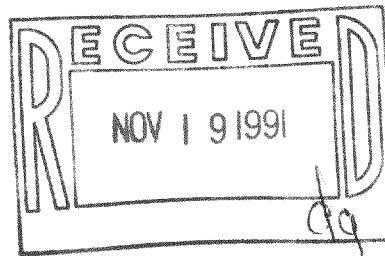

ORDERED BY: TOM BOSCO
1607 N. 19th AVE.
MELROSE PARK, IL. 60160

I, DAVID F. ABELL, DO HEREBY CERTIFY THAT I HAVE SURVEYED THE PROPERTY HEREON DESCRIBED ACCORDING TO THE OFFICAL RECORDS AND THAT THE PLAT HEREON IS A CORRECT REPRESENTATION OF THE PROPERTY LINES TO THE BEST OF MY KNOWLEDGE AND BELIEF.

David F. Abell
DAVID F. ABELL

WISCONSIN REGISTERED LAND SURVEYOR, S-1596

September 5, 1991

DATE JOB NUMBER - 91177

NOTE: THIS IS NOT A CERTIFIED COPY UNLESS SEALED.