


GEORGE T. DUNHAM  
SURVEYING & SUBDIVIDING  
DELAVAN, WISCONSIN

Scale - 1" = 20'  
○ = Iron Pipe

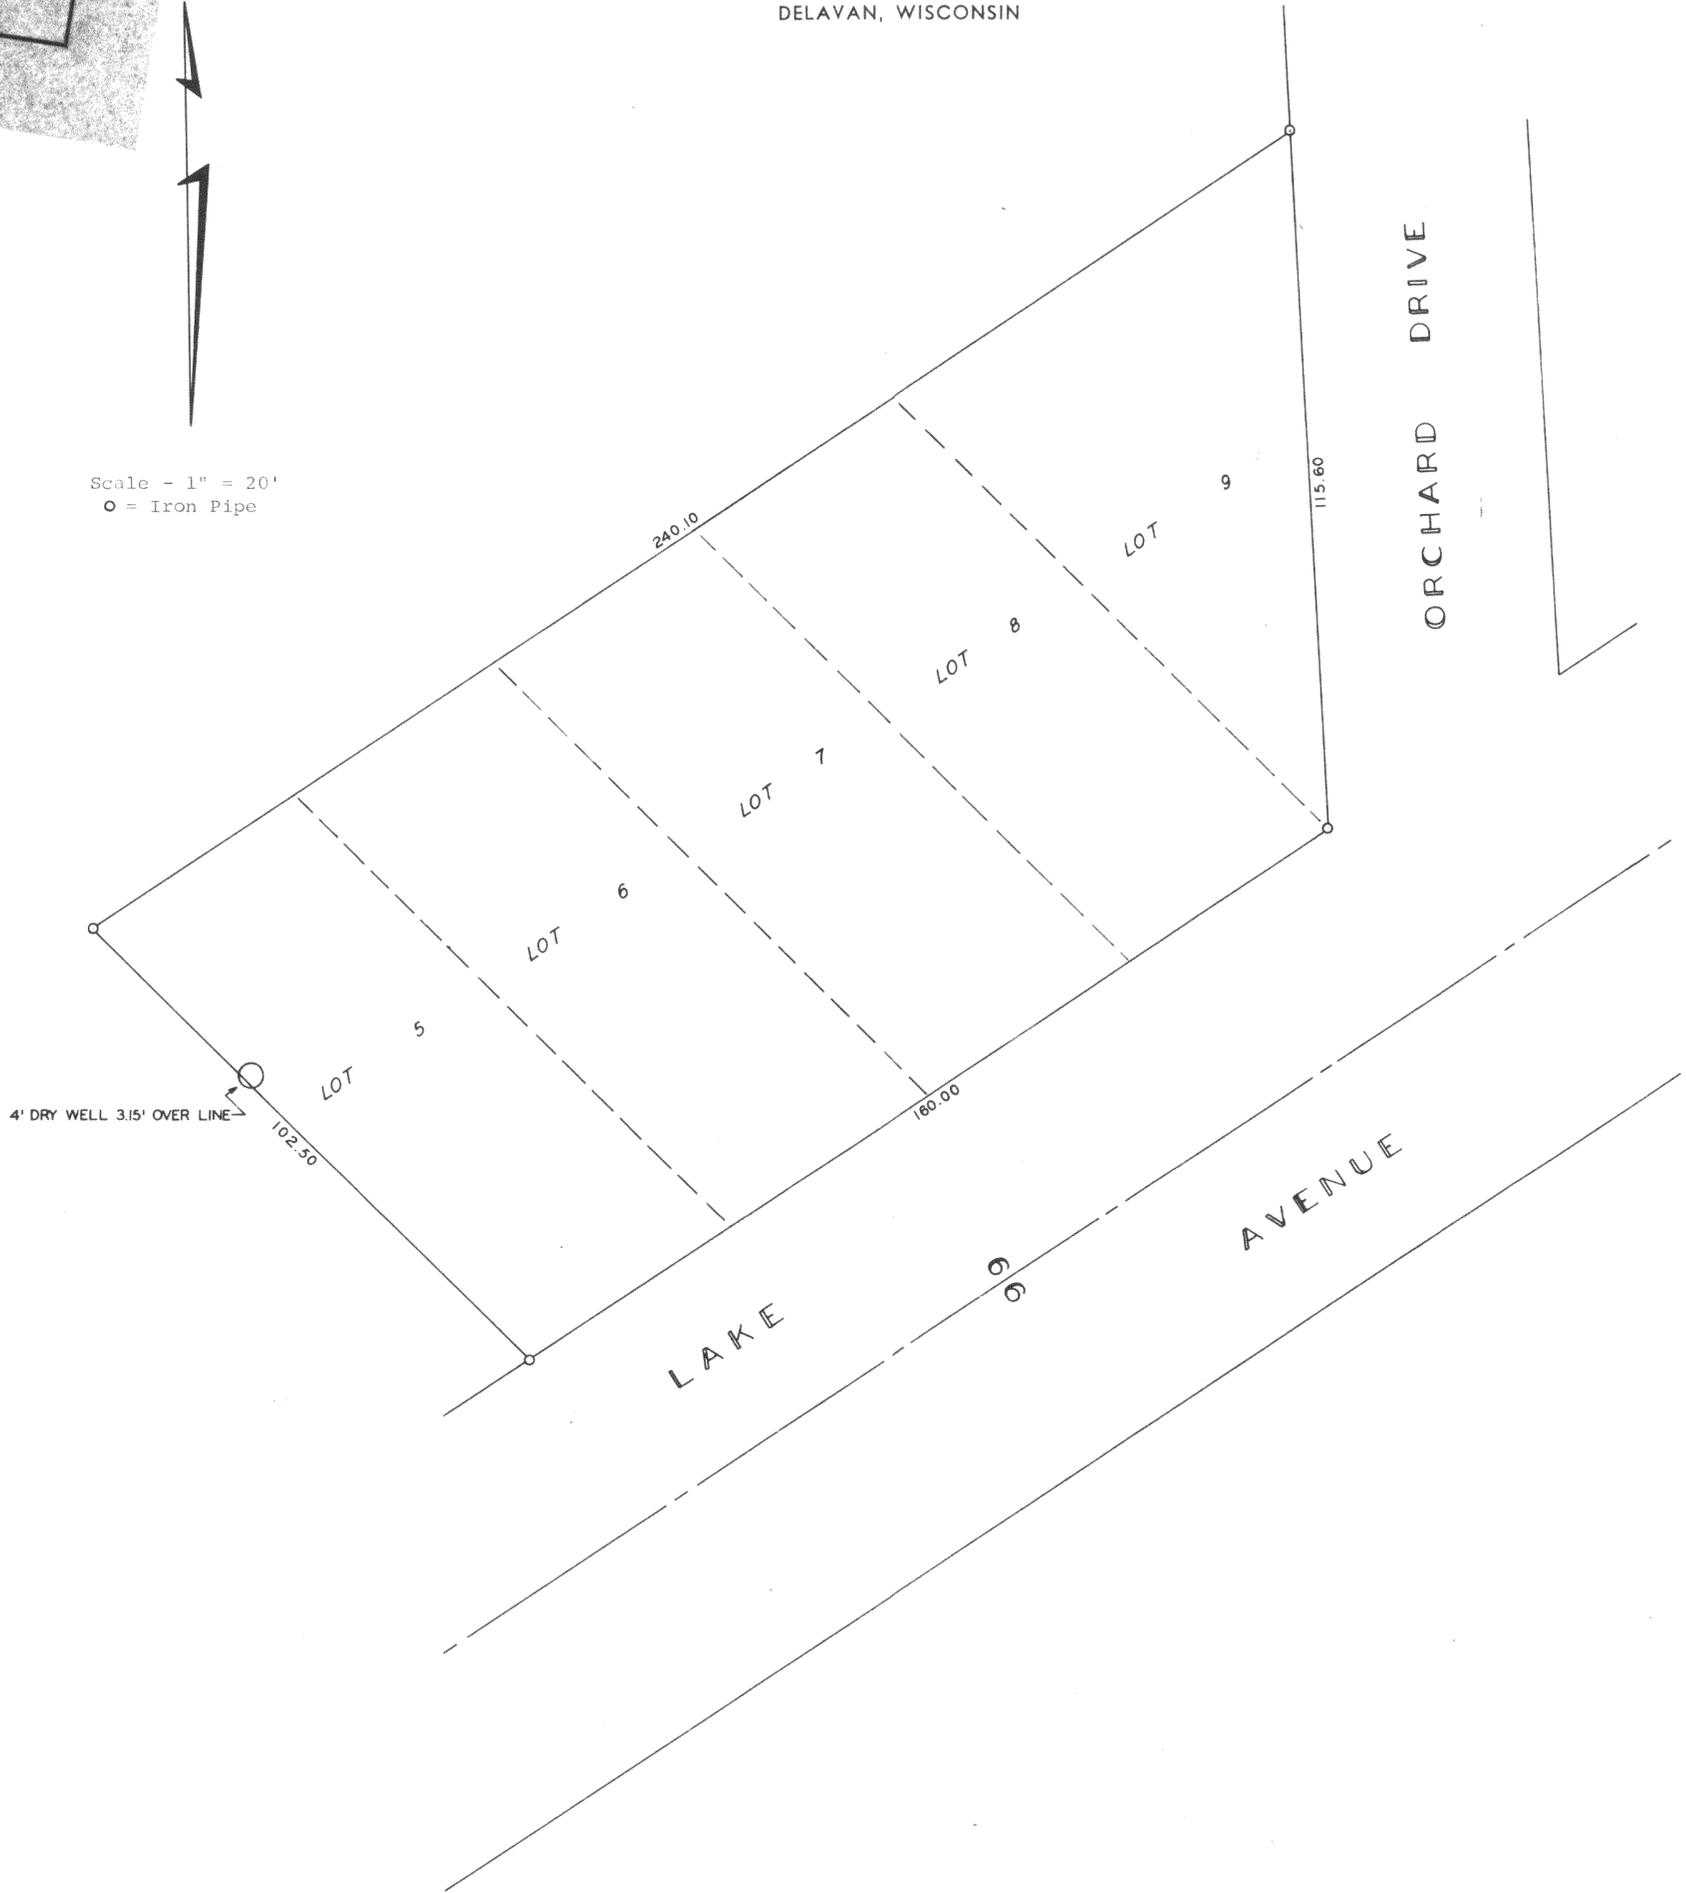

Plat of survey of Lots 5-9, Block 4 of South Shore Manor  
located in Section 32, T 2 N R 16 E of Walworth County, Wis-  
consin.  
July 20, 1962

*George T. Dunham*  
George T. Dunham, Surveyor

FSS-62