


DUNHAM SURVEYING, S.C.
SURVEYING & SUBDIVIDING
DELAVAN, WISCONSIN 53115



SCHROEDER

AVENUE

Scale - 1" = 20'
● = 1/2" Iron Rod Found
○ = 3/4" Iron Pipe Found
⊘ = 1" Iron Pipe Found
⊗ = 1 1/4" Iron Pipe Found
(0.00) = recorded distance
Bearings referenced to the south line of
Schroeder Avenue with the assumed bearing
of East
Survey ordered by:
Craig Anderson
1011 South 2nd Street
Delavan, WI 53115

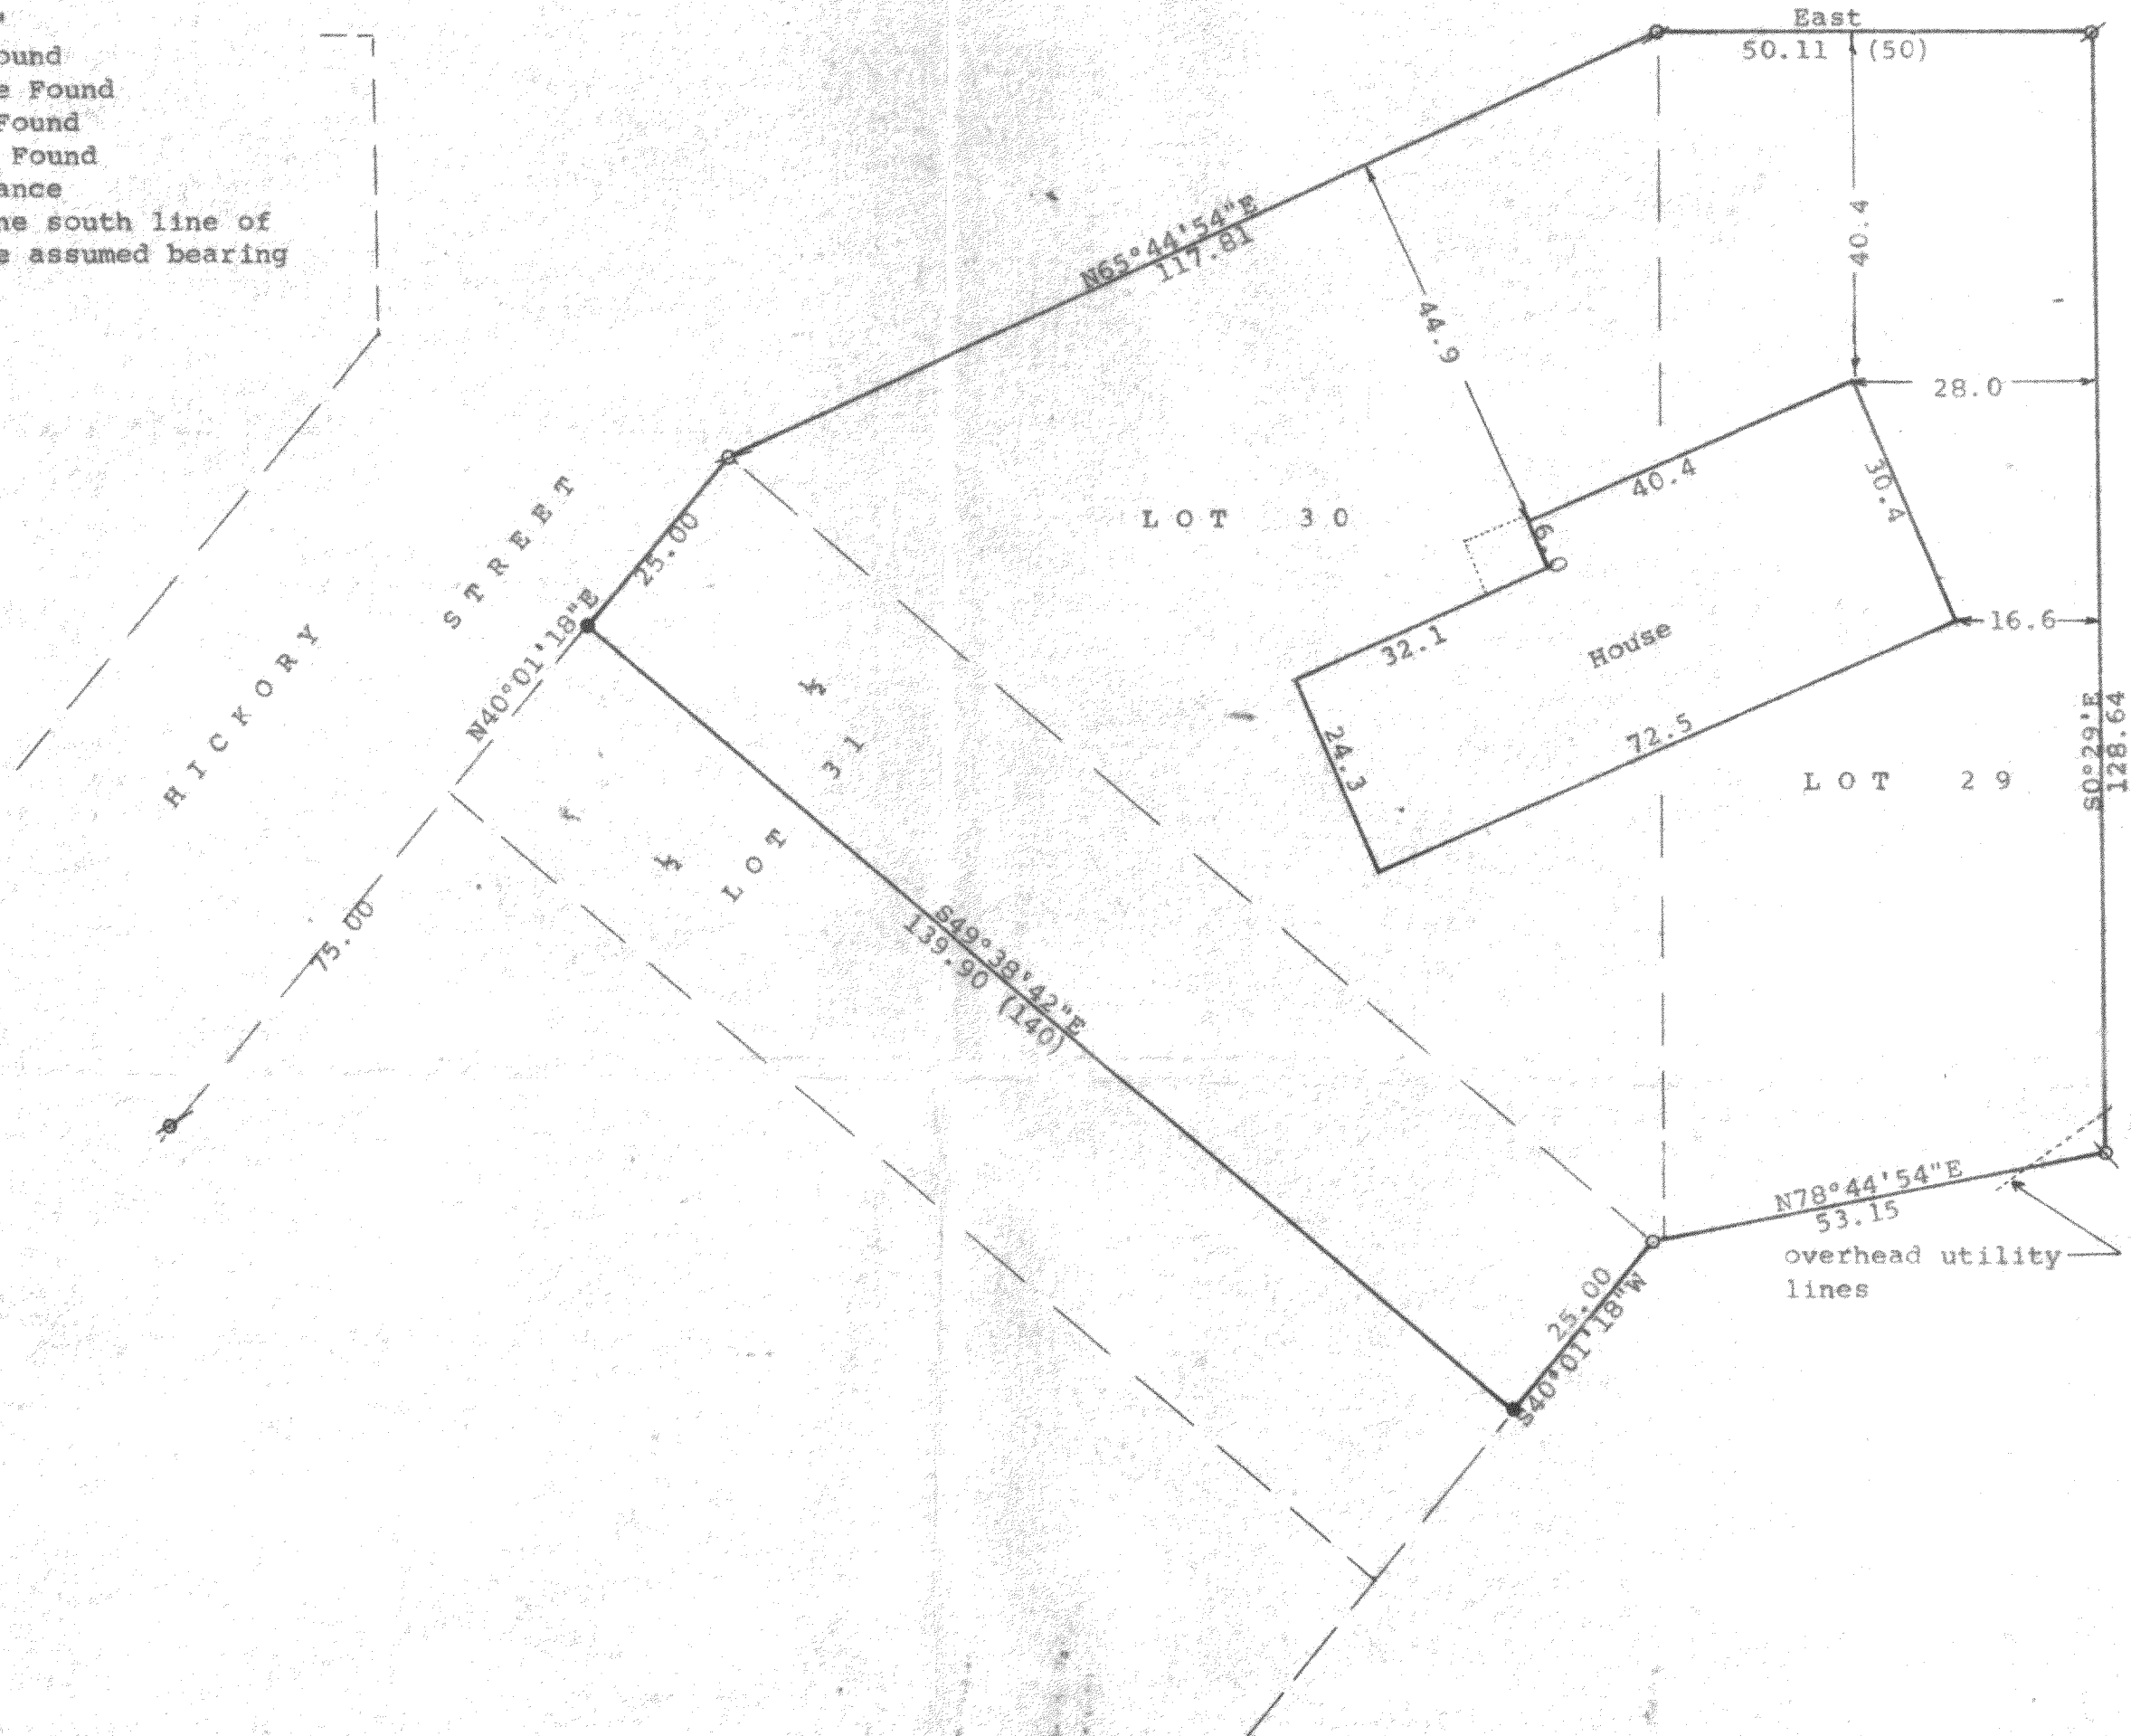

STATE OF WISCONSIN) SS
COUNTY OF WALWORTH)

I, George T. Dunham, Surveyor, certify that I have surveyed the property
described as follows:
Lot 29, Lot 30, and the NE 1/4 of Lot 31 in Block 7 of Inlet Oaks
Subdivision No. 4, located in Section 15, T 2 N, R 16 E, Walworth County,
Wisconsin.

and that the plat shown hereon is a correct representation thereof and shows
the size and location of the property, its exterior boundaries, the location
of all visible structures and dimensions of all principal buildings thereon,
boundary fences, apparent easements, roadways and visible encroachments, if
any, and that I have surveyed the property hereon described, according to the
official records, to the best of my knowledge and belief.

March 22, 1991

George T. Dunham
George T. Dunham, Surveyor

