



BOUNDARY & TOPOGRAPHIC SURVEY
LOTS 23 & 24, BLOCK 7
SOUTH SHORE MANOR SUBDIVISION
 SEC. 32, T. 2 N., R. 16 E.
 WALWORTH COUNTY, WISCONSIN



ASSIGNED NORTHEASTERLY LINE
 LOTS 23 & 24
 BEARING S 48° E

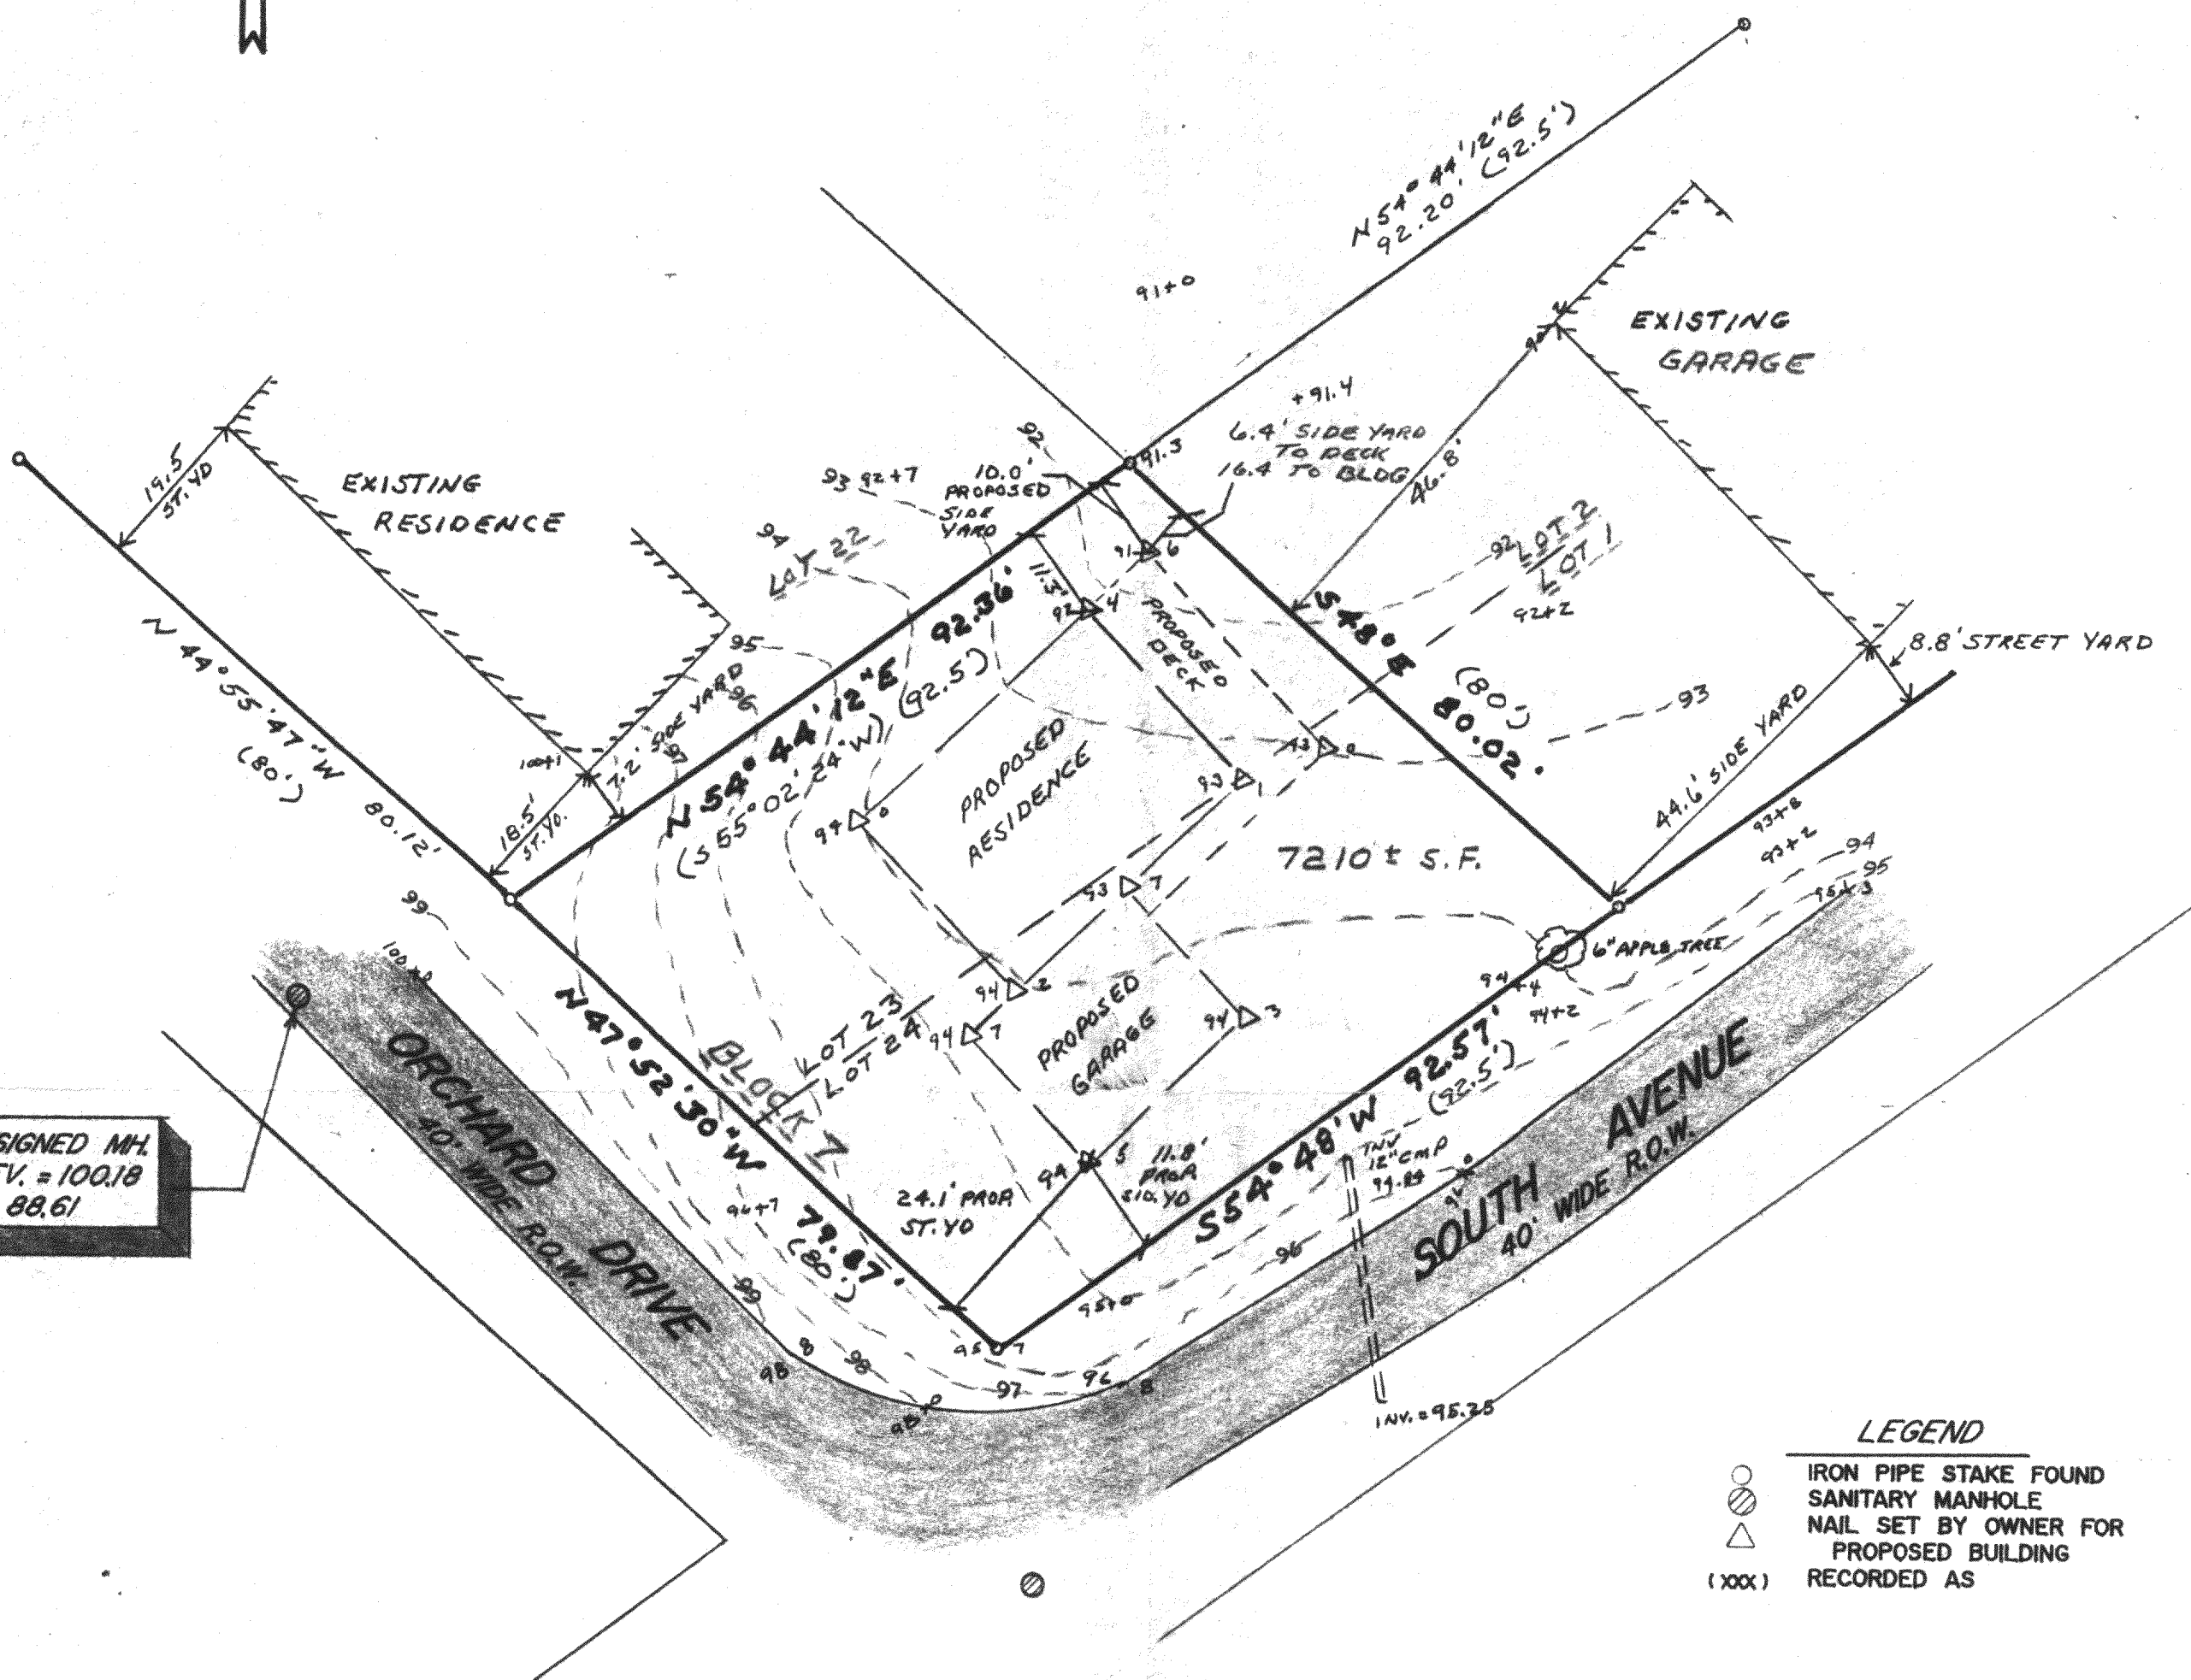

BM: ASSIGNED M.H.
 RIM ELEV. = 100.18
 IE = 88.61

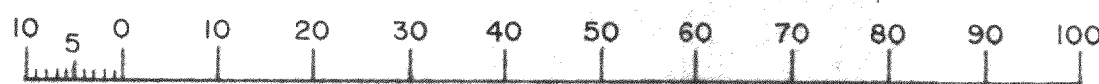

MAP SCALE IN FEET
 1" = 20'

LEGEND
 ○ IRON PIPE STAKE FOUND
 ⊗ SANITARY MANHOLE
 △ NAIL SET BY OWNER FOR
 PROPOSED BUILDING
 (XXX) RECORDED AS



SURVEYOR'S CERTIFICATE:

COPIES OF THIS MAP TO WHICH THIS CERTIFICATE WILL APPLY ARE BLUE LINE PRINTS SHOWING THE SURVEYOR'S ORIGINAL SEAL AND CERTIFICATE IN BLACK INK. COPIES BY ANY OTHER MEANS MAY HAVE ALTERATIONS WHICH DO NOT REPRESENT THE SURVEYOR'S WORK PRODUCT.

I HEREBY CERTIFY THAT THIS PLAT OF SURVEY IS A TRUE AND ACCURATE REPRESENTATION OF THE BOUNDARY LINES OF THE SUBJECT PARCEL AND OF THE EXISTING PHYSICAL FEATURES OF THE PARCEL SHOWN HEREON TO THE BEST OF MY KNOWLEDGE AND BELIEF. THIS SURVEY IS MADE FOR THE USE OF THE PRESENT OWNERS OF THE PROPERTY, AND ALSO THOSE WHO PURCHASE, MORTGAGE, OR GUARANTEE THE TITLE THERETO WITHIN ONE YEAR FROM THE DATE HEREOF.

DATED THIS 3RD DAY OF FEBRUARY, 1992

Peter S. Gordon

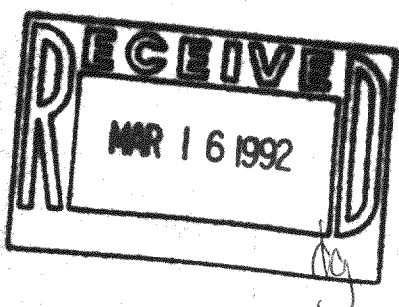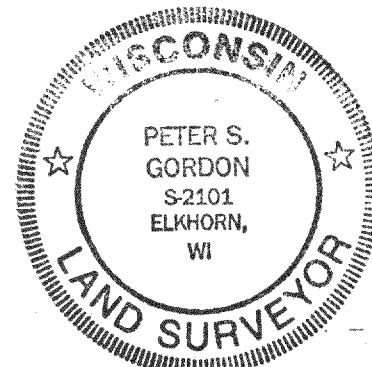

WORK ORDERED BY: TED & KRIS DICKMAN

BOUNDARY & TOPOGRAPHIC SURVEY

LOTS 23 & 24, BLOCK 7
 SOUTH SHORE MANOR SUBDIVISION
 SEC. 32, T. 2 N., R. 16 E.
 WALWORTH COUNTY, WISCONSIN

FOR: TED AND CHRIS DICKMAN

FARRIS, HANSEN & ASSOCIATES, INC.
 Engineering, Architecture, Surveying
 7 Ridgeway Court P.O. Box 437
 ELKHORN, WISCONSIN 53121
 Office: (414) 723-2098
 Fax: (414) 723-5886

REVISIONS
 REV. 2-3-92
 CHANGE RES.
 TO GARAGE
 ADD CORN. S.Y.

PROJECT NO
3601
DATE
01-30-92
SHEET NO
1 of 1