


DUNHAM SURVEYING, S.C.
SURVEYING & SUBDIVIDING
DELAVER, WISCONSIN 53115

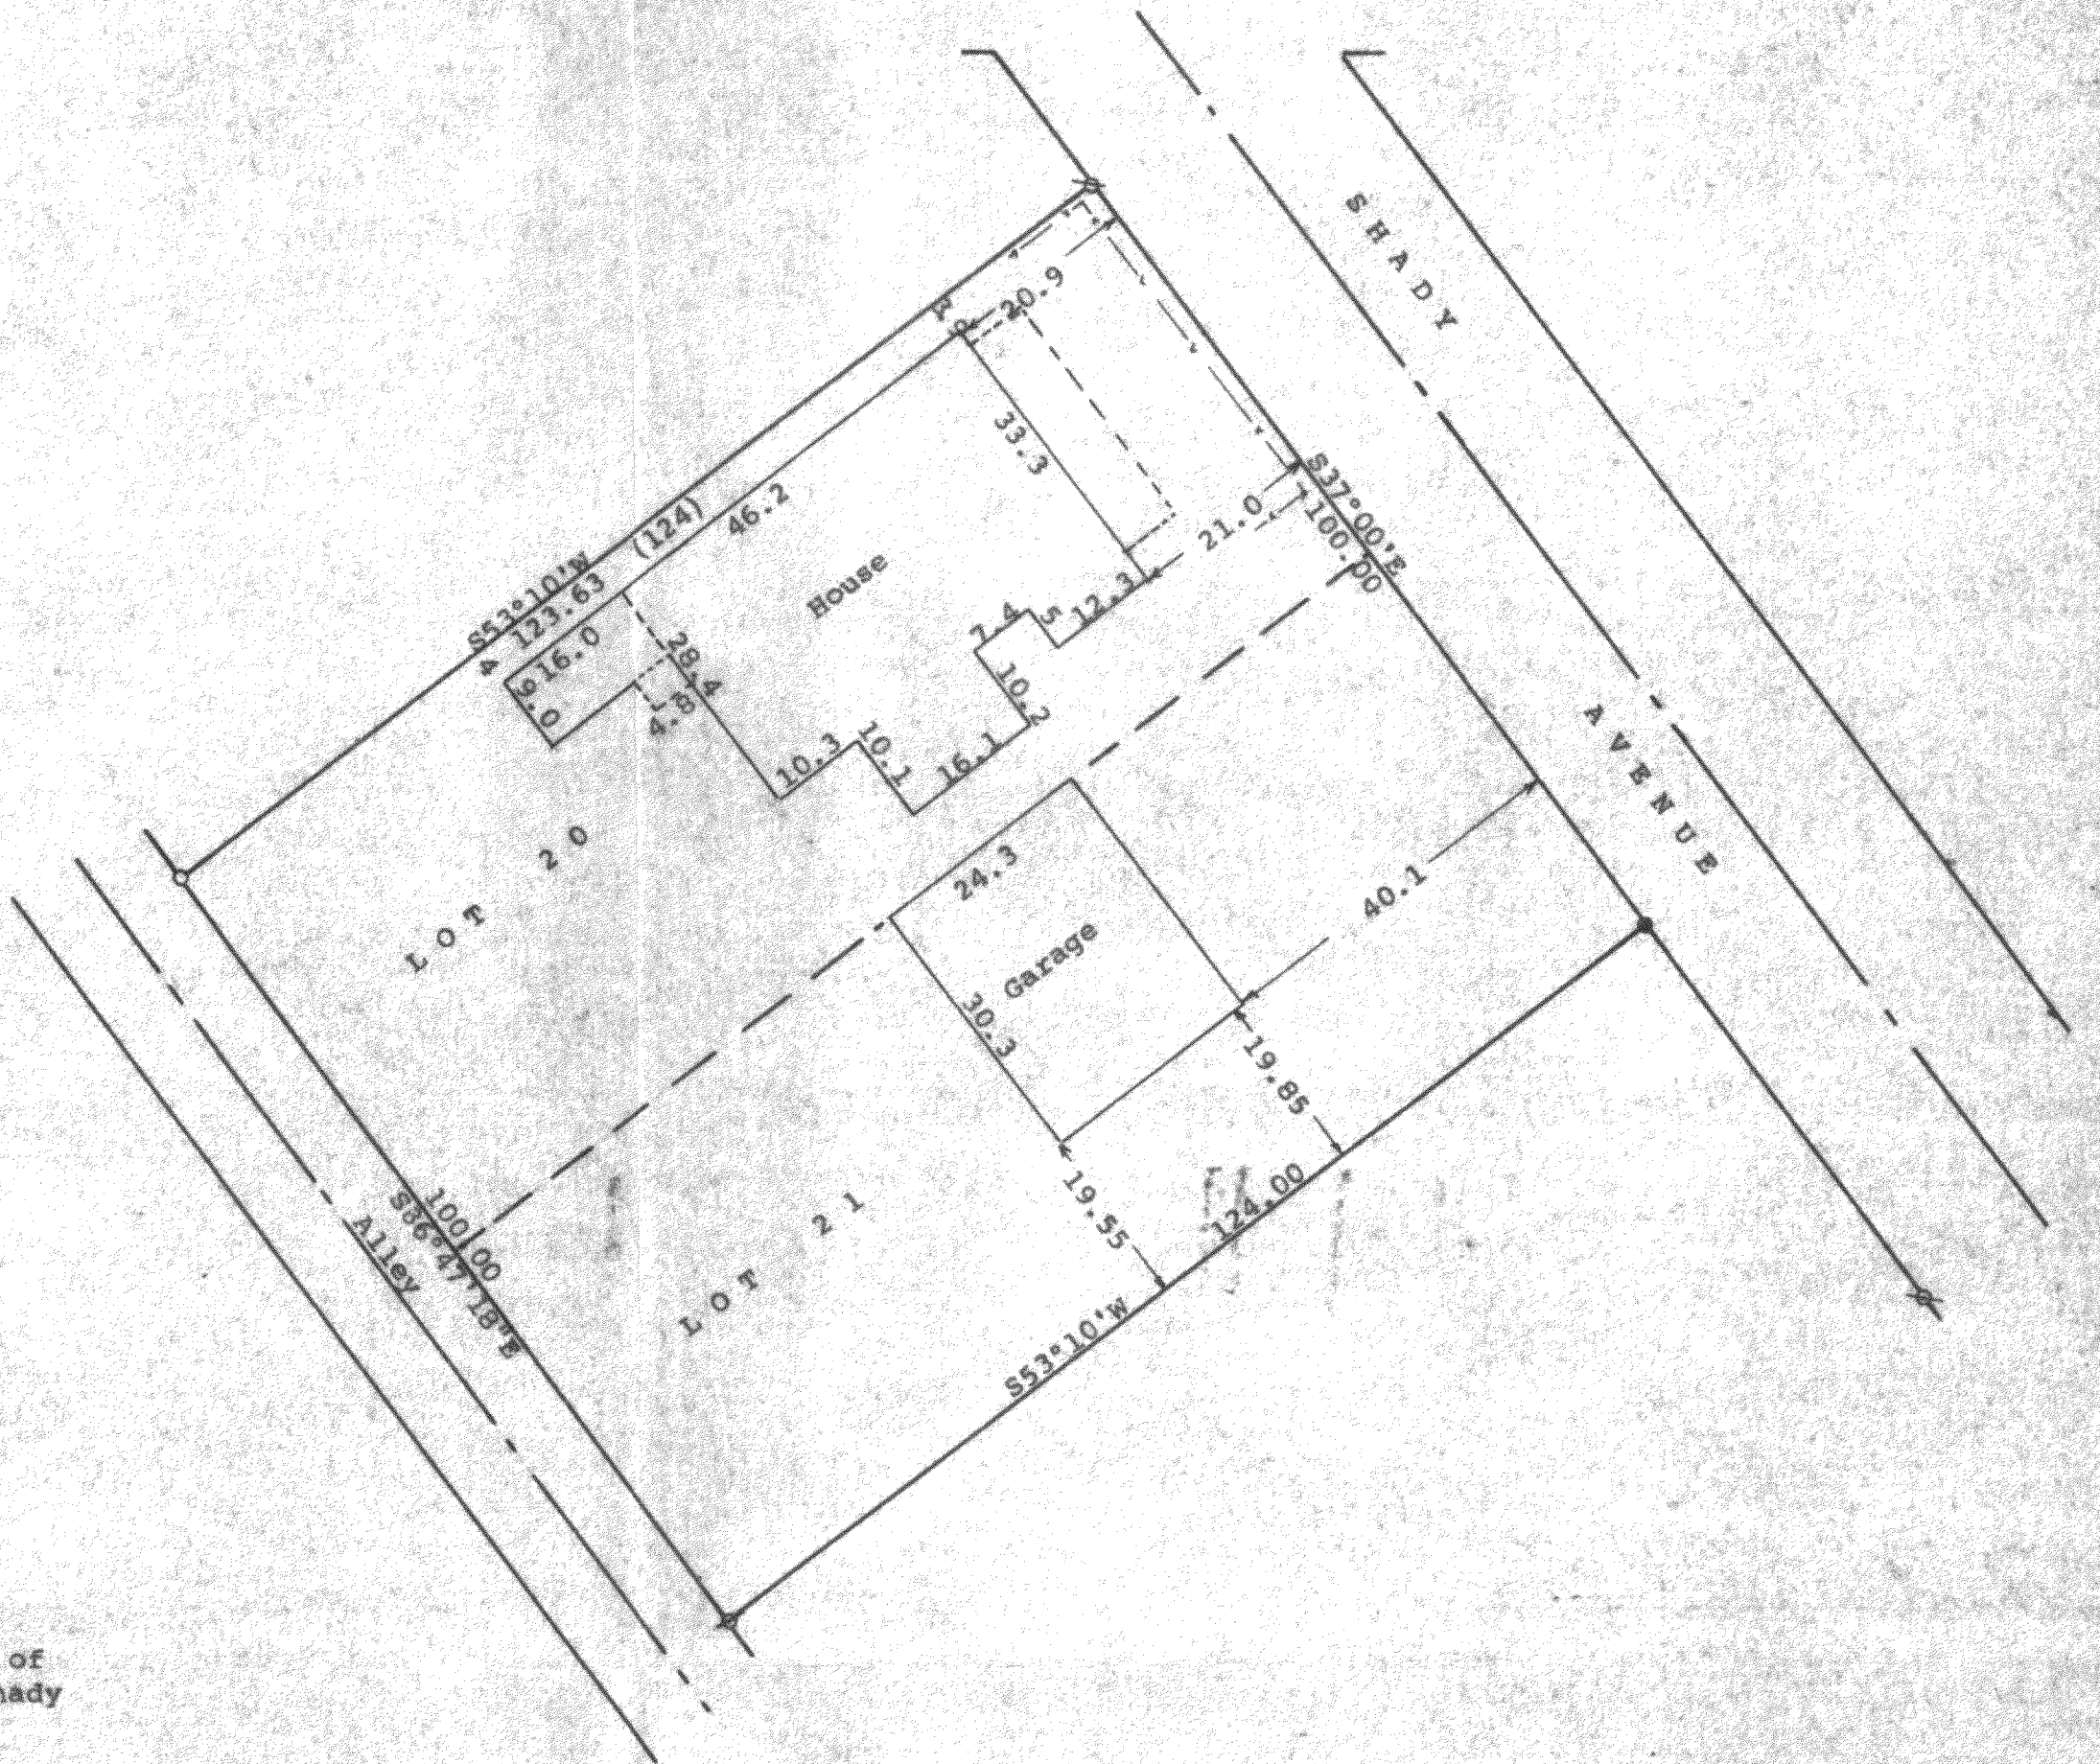

Scale - 1" = 20'
 IPF = 1 1/4" Iron Pipe Found
 IPF = 1" Iron Pipe Found
 IPF = 3/4" Iron Pipe Found
 SIRF = 3/4" Square Iron Rod Found
 (0.00) = recorded distance
 --- = fence line
 Bearings referenced to the assumed bearing of
 S37°00'E along the southwesterly line of Shady
 Avenue
 Survey ordered by: Mrs Raymond Alberth
 Shady Lane Avenue
 Delavan, WI 53115

STATE OF WISCONSIN)
 COUNTY OF WALWORTH) SS

I, George T. Dunham, Surveyor, certify that I have surveyed the
 property described as follows:
 Lots 20 and 21 in Block 2 of Inlet Oaks, a subdivision located
 in Section 22, T 2 N, R 16 E, Walworth County, Wisconsin,
 and that the plat shown hereon is a correct representation thereof and shows
 the size and location of the property, its exterior boundaries, the location
 of all visible structures and dimensions of all principal buildings thereon,
 boundary fences, apparent easements, roadways and visible encroachments, if
 any, and that I have surveyed the property hereon described, according to the
 official records, to the best of my knowledge and belief.
 April 5, 1991

George T. Dunham
 George T. Dunham, Surveyor

