
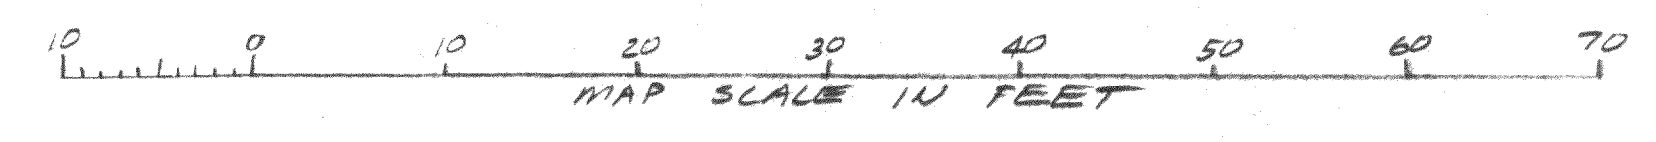


Lot 29 surveyed by G. Dunham Nov. 1989  
WCSR 216-1189  
S 24° 13' 30" E 164.44' = Bearing Basis This Plat

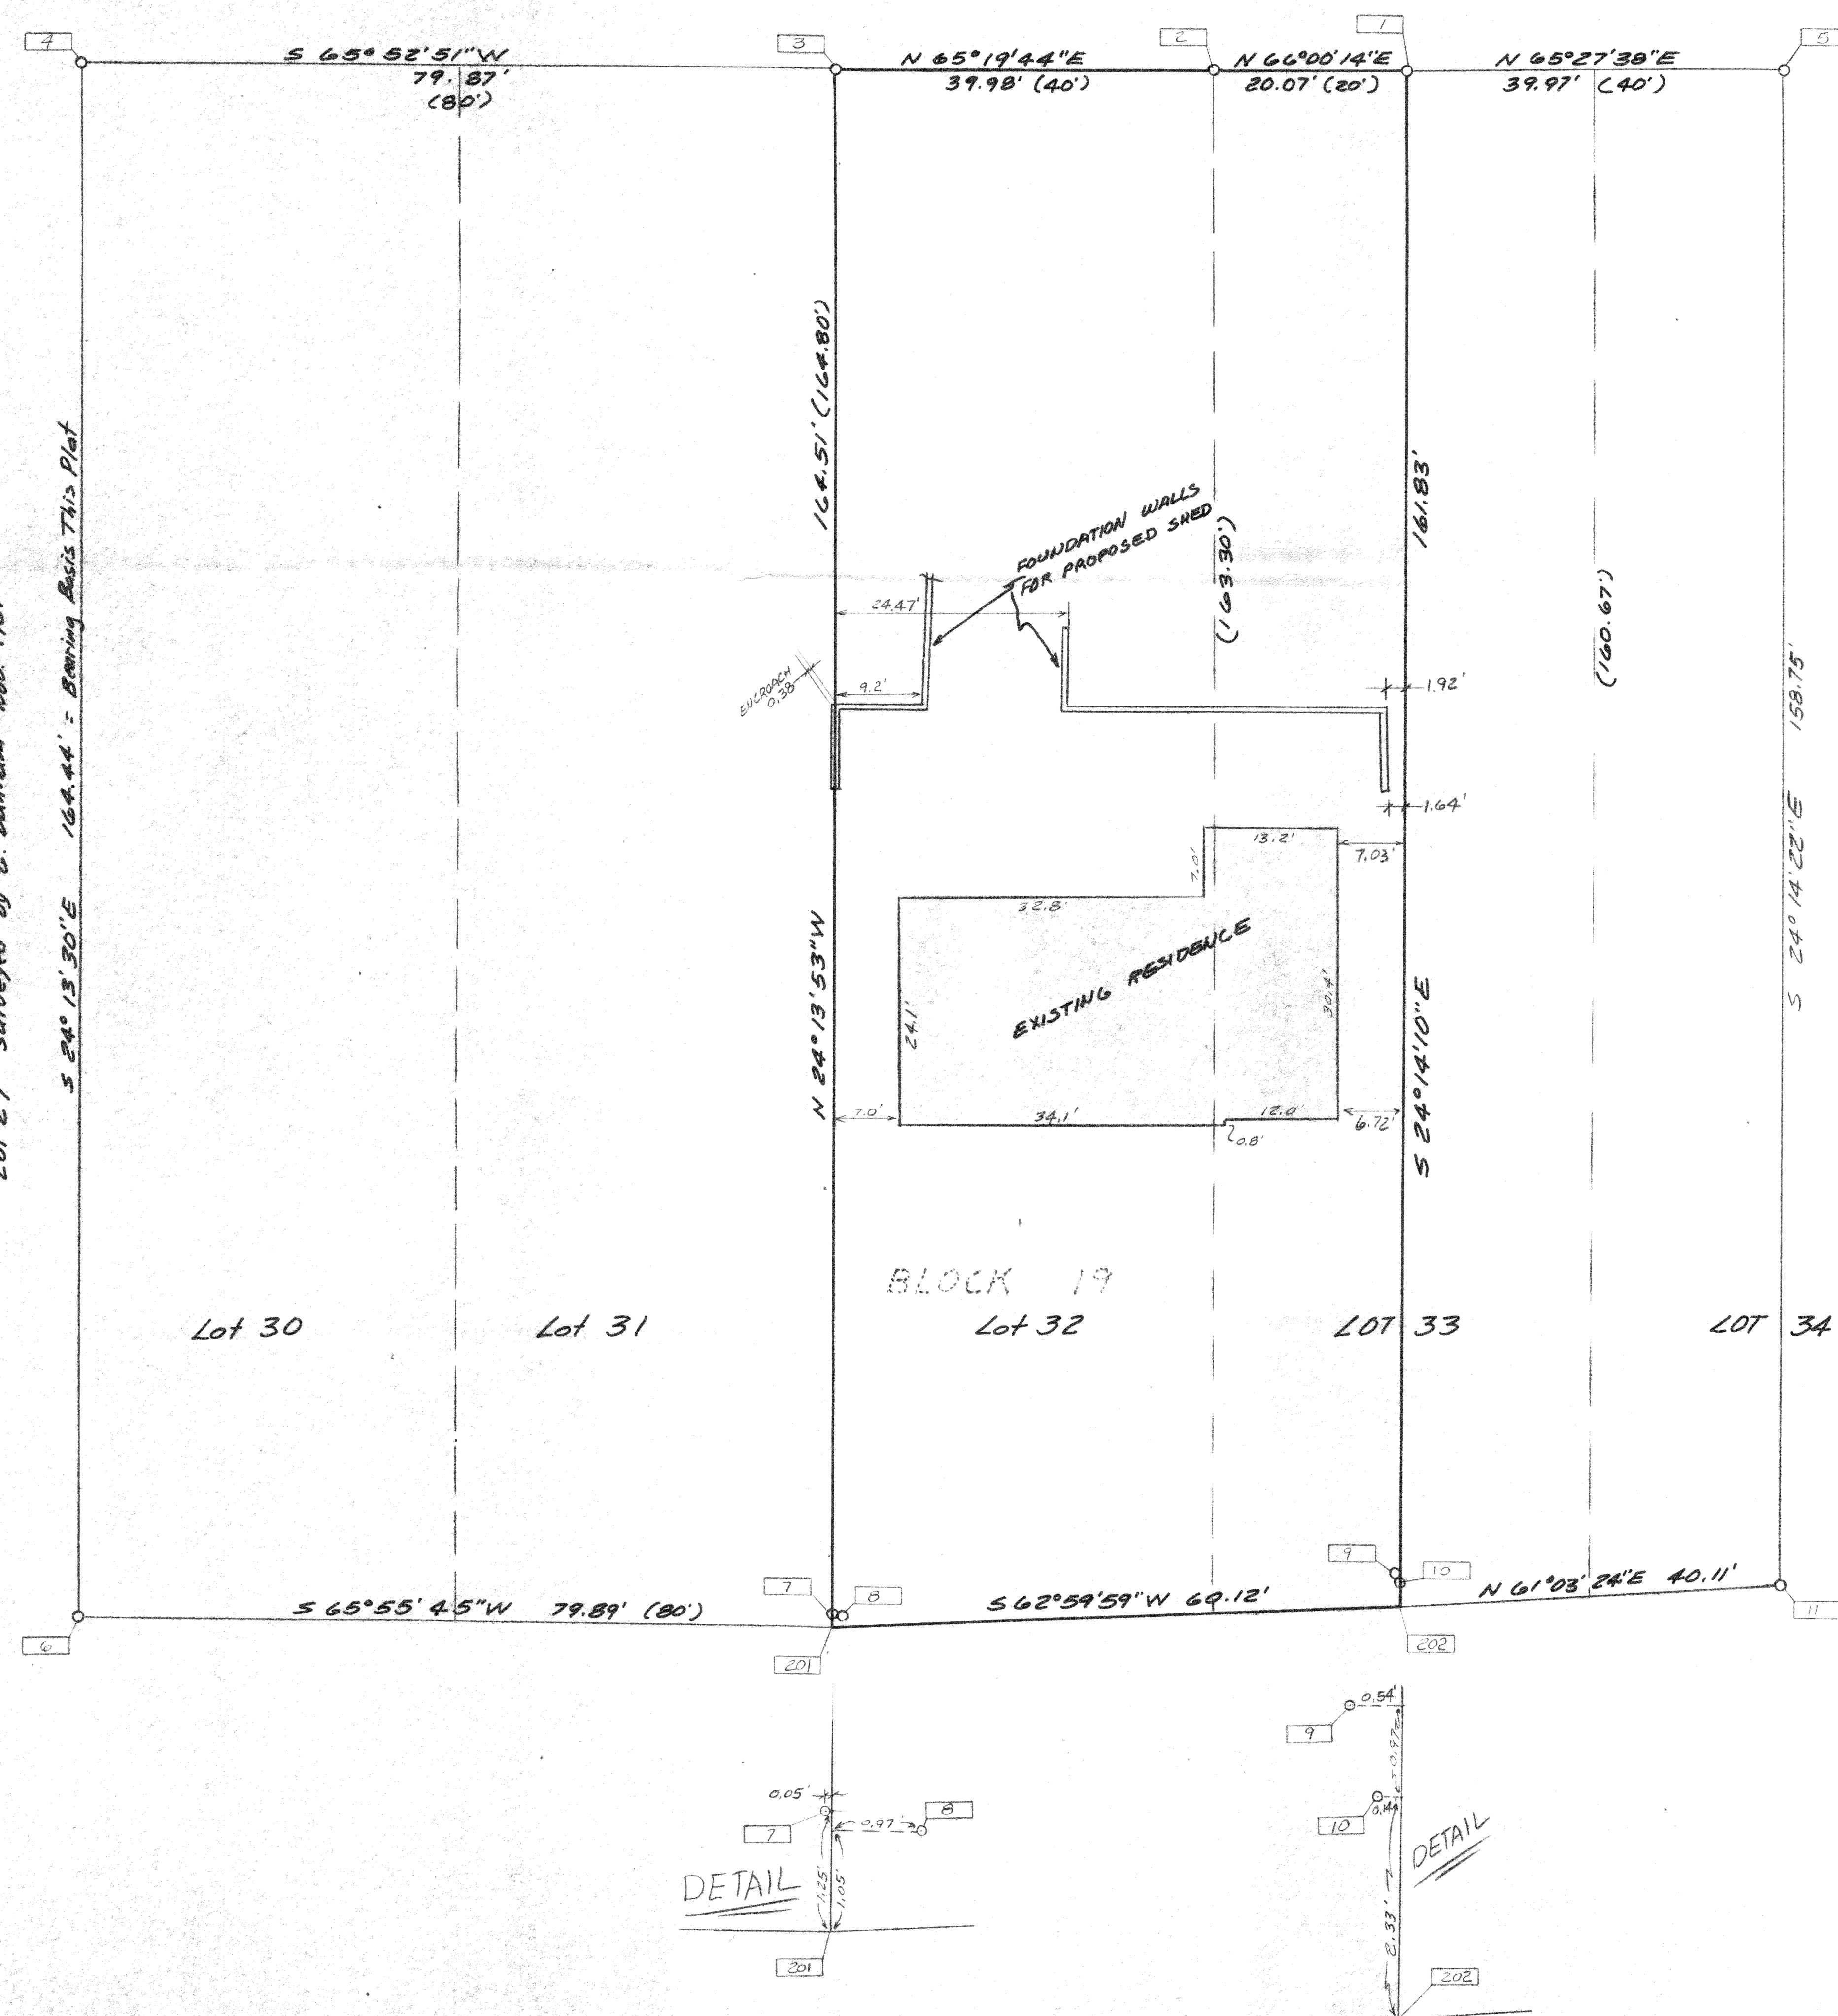


0 = IRON STAKE FOUND  
(XXX') = RECORDED PLAT DIMENSION  
E LINE WCSR 216-1189

E. HALF LOT 34 SURVEYED  
BY D. ABELL AUG. 1988  
WCSR 216-1089


PROJECT NO 3540 DATED SEPT 18TH 1991  
ANALYSIS OF STAKES FOUND:  
FOUND IRON STAKES 4 & 6 IN CLOSE AGREEMENT WITH DUNHAM PLAT NOV 1989  
EAST LINE LOT 29 CALC FROM 9/17/91 MEASUREMENT  
4 TO 6 S 24 - 13 - 30 E 164.44 FT  
RECORD LENGTH OF THIS LOT LINE IS 164.44  
FOUND IRON STAKES 5 & 11 IN CLOSE AGREEMENT WITH ABELL PLAT AUG 1988  
DIVIDING LINE FOR HALF OF LOT 34 CALC FROM 9/17/91 MEASUREMENT  
5 TO 11 S 24 - 14 - 22 E 158.75 FT  
RECORD LENGTH FOR THIS LINE WOULD BE (156.92+160.67)/2=158.8  
ACCEPT LINE 4==5 LINE BETWEEN CORNERS OF DOCUMENTED ORIGIN AS REAR LINE  
CALC OFFSETS FOR STAKES 1 2 & 3 AS FOLLOWS:  
4 TO 5 S 65 - 40 - 43 179.878 FT FP 1.0 D  
3 STA 0 + 79.87 OFF .25 RT FP 1.0 D  
2 STA 1 + 19.85 OFF .03 RT FR .75 D  
1 STA 1 + 39.91 OFF .16 RT FP 1.0 D  
DETERMINE DIRECTION OF WEST LINE LOT 32 AND LINE DIVIDING LOT 33  
IN DIRECT PROPORTION RELATIVE TO LINES 4==5 AND 5==11  
AND ADJUST LENGTHS FOR ABOVE OFFSETS TO GET TRUE POSITIONS AT ROAD  
3 TO 201 S 24 - 13 - 53 E 164.51 FT  
1 TO 202 S 24 - 14 - 10 E 161.83 FT  
DID NOT ACCEPT STAKE 7 SINCE CLIENT SAYS HE SET IT  
SUSPECT STAKES 8 9 & 10 ARE ALSO PROBABLY RESULT OF NON PROFESSIONALS  
SINCE STAKES 6 & 11 AGREE WITH RECORD MAPS AND LOT DEPTHS 8 9 & 10 DO NOT  
RESULTING LOT BOUNDED AS FOLLOWS:  
201 TO 3 N 24 - 13 - 53 W 164.51 FT  
3 TO 2 N 65 - 19 - 44 E 39.98 FT  
2 TO 1 N 66 - 0 - 14 E 20.07 FT  
1 TO 202 S 24 - 14 - 10 E 161.83 FT  
202 TO 201 S 62 - 59 - 59 W 60.12 FT  
AREA 9802 SF .225 ACRES

DETAIL

DETAIL

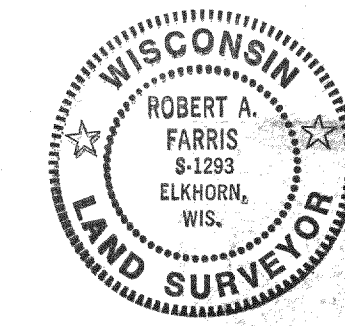

HEREBY CERTIFY THAT THIS MAP IS A TRUE AND ACCURATE  
REPRESENTATION OF THE BOUNDARY LINES AND LOCATION OF IMPROVEMENTS  
SHOWN TO THE BEST OF MY PROFESSIONAL KNOWLEDGE AND BELIEF.  
DATED: 9/18/91  
Robert A. Farris  
ROBERT A. FARRIS RLS

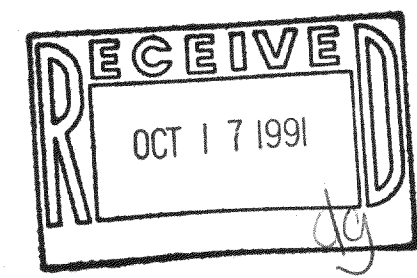

PLAT OF SURVEY  
LOT 32 & W. 1/2 33 BLOCK 19  
DELAUAN LAKE VIEWCREST  
TOWN OF DELAUA  
WALWORTH CO., WIS.

ORDERED BY:  
MRS. NESTLER  
4414 VIEWCREST DR  
DELAUAN, WI. 53181  
PURPOSE FOR SURVEY - OBTAIN  
BUILDING PERMIT FOR SHED

FARRIS, HANSEN & ASSOCIATES, INC.  
Engineering, Architecture, Surveying  
7 Ridgway Court P.O. Box 437  
ELKHORN, WISCONSIN 53121  
Office: (414) 723-2098  
Fax: (414) 723-5886

REVISIONS  
Orig. 9/18/91

PROJECT NO  
3540  
DATE  
09/18/91  
SHEET NO.  
1 of 1