


DUNHAM SURVEYING, S.C.
SURVEYING & SUBDIVIDING
DELAVER, WISCONSIN 53115

N

Scale - 1" = 40'
● = Iron Pipe Found
○ = Iron Pipe Set
● = Concrete Monument

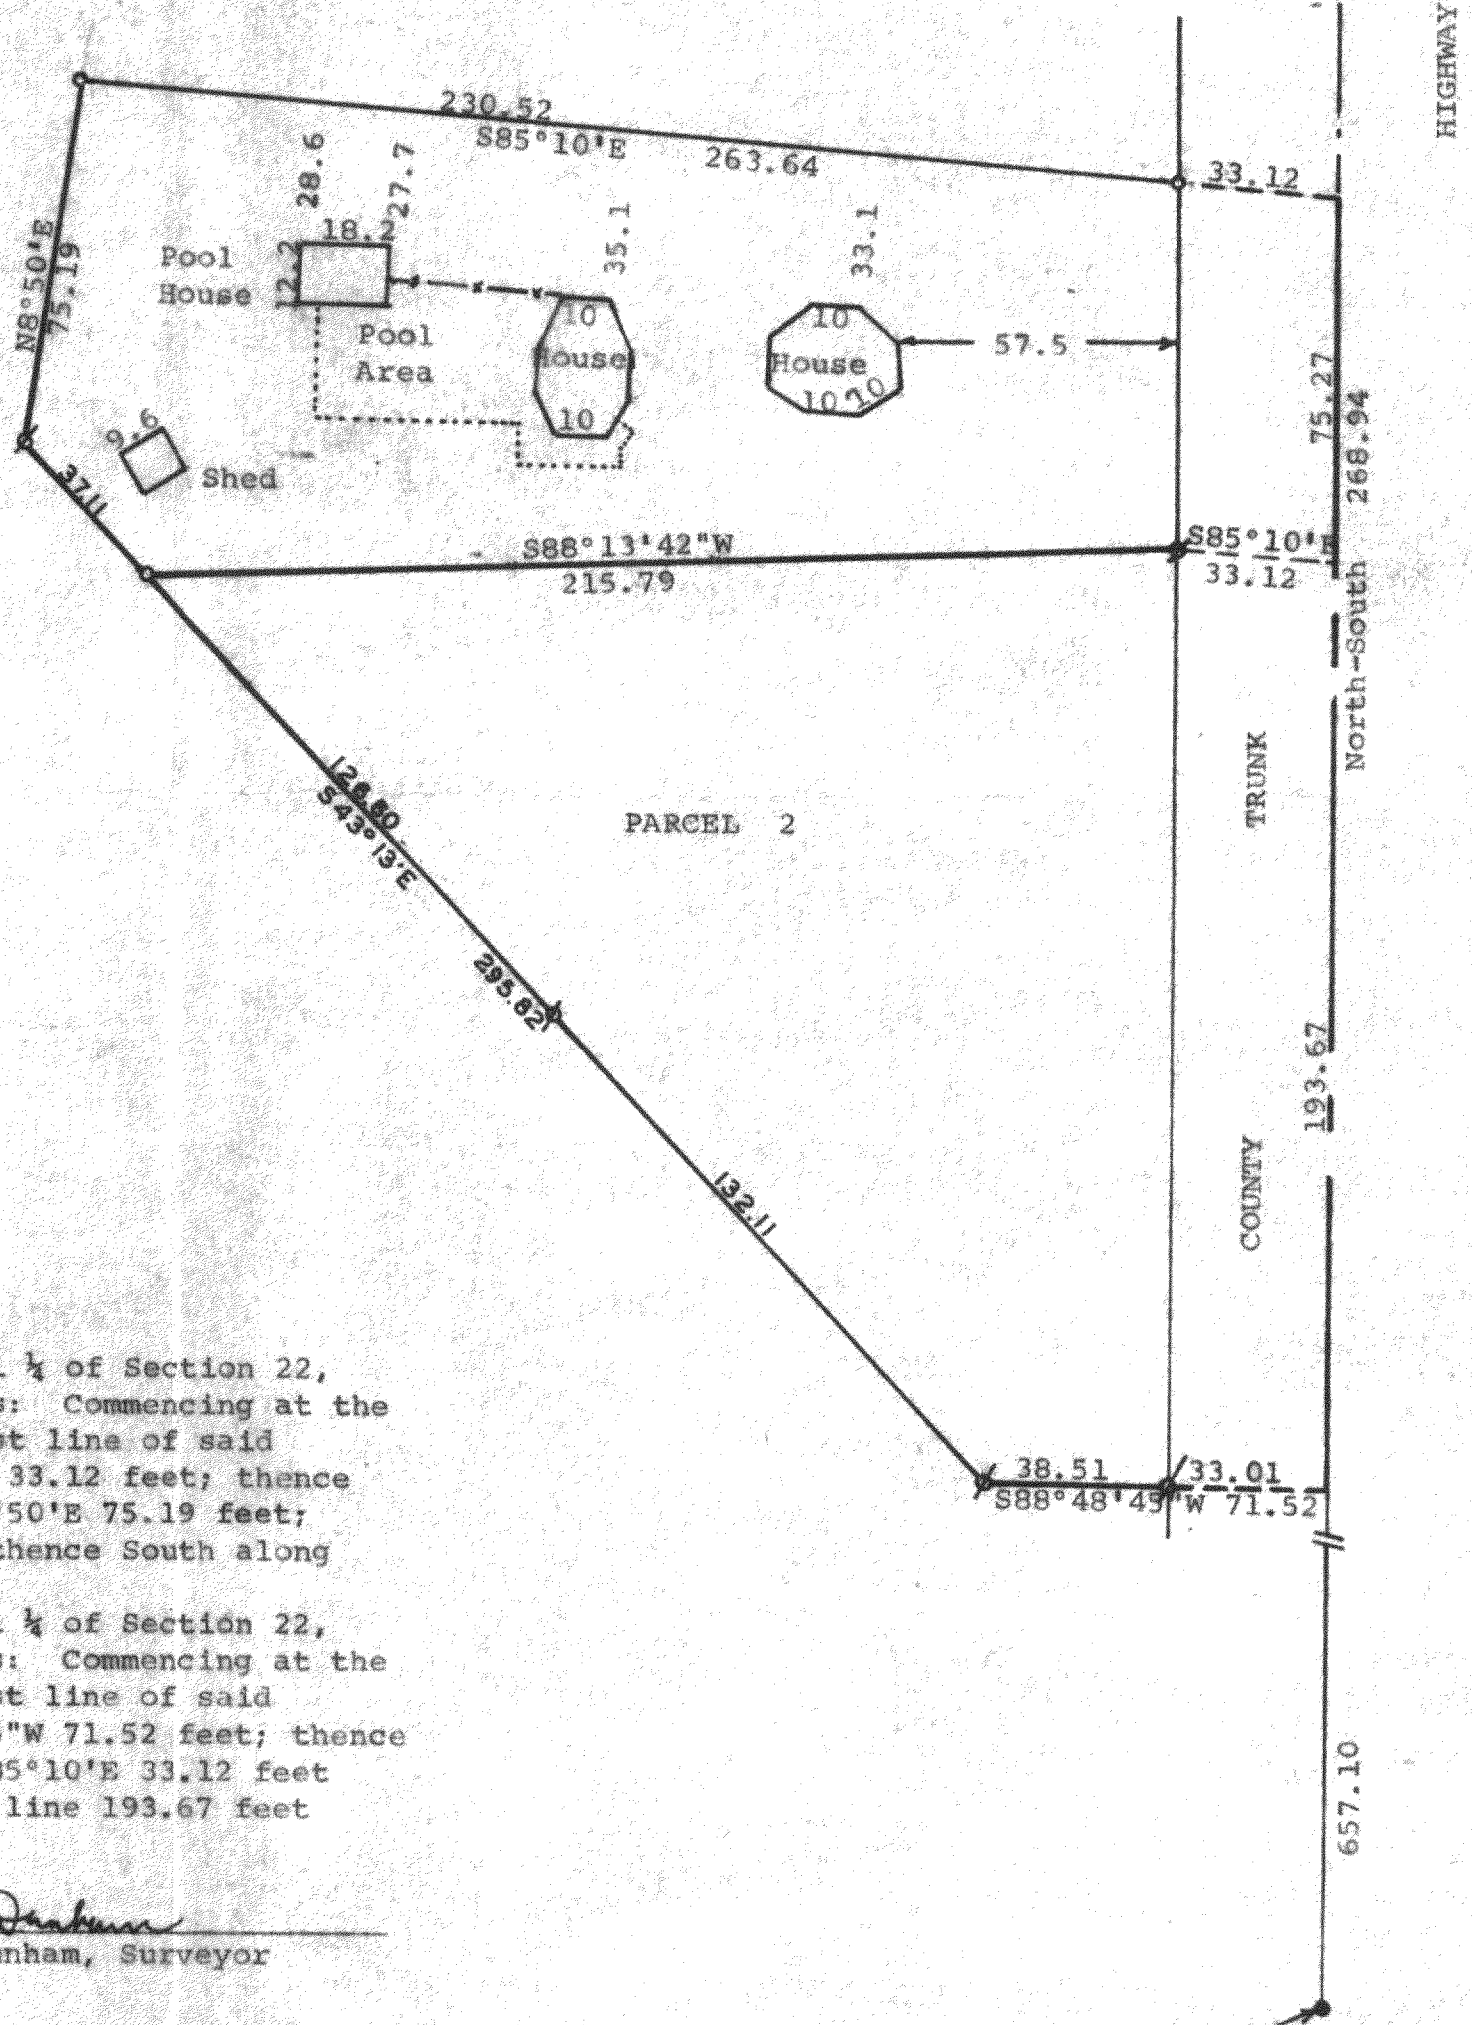

Plat of survey of:

PARCEL 1: A parcel of land located in the Southeast Fractional $\frac{1}{4}$ of Section 22, T 2 N, R 16 E, Walworth County, Wisconsin, described as follows: Commencing at the southeast corner of said Section 22; thence North along the east line of said section 850.77 feet to the place of beginning; thence N85°10'W 33.12 feet; thence S88°13'42"W 215.79 feet; thence N43°13'W 37.11 feet; thence N8°50'E 75.19 feet; thence S85°10'E 263.64 feet to the east line of said section; thence South along said east line 75.27 feet to the place of beginning.



PARCEL 2: A parcel of land located in the Southeast Fractional $\frac{1}{4}$ of Section 22, T 2 N, R 16 E, Walworth County, Wisconsin, described as follows: Commencing at the southeast corner of said Section 22; thence North along the east line of said section 657.10 feet to the place of beginning; thence S88°48'45"W 71.52 feet; thence N43°13'W 258.71 feet; thence N88°13'42"E 215.79 feet; thence S85°10'E 33.12 feet to the east line of said section; thence South along said east line 193.67 feet to the place of beginning.

November 13, 1979

Revised Nov. 14, 1979

Survey updated to show building location
on October 30, 1990

George T. Dunham
George T. Dunham, Surveyor

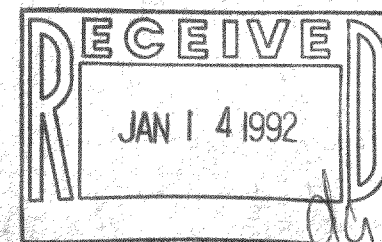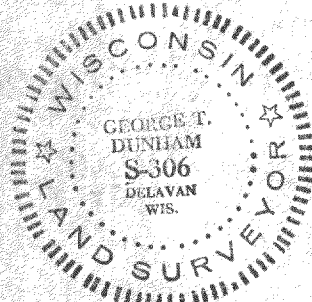

Southeast corner of Section
22, T2N, R16E, Walworth Cty.