


DUNHAM SURVEYING, S.C.
SURVEYING & SUBDIVIDING
DELAVAN, WISCONSIN 53115

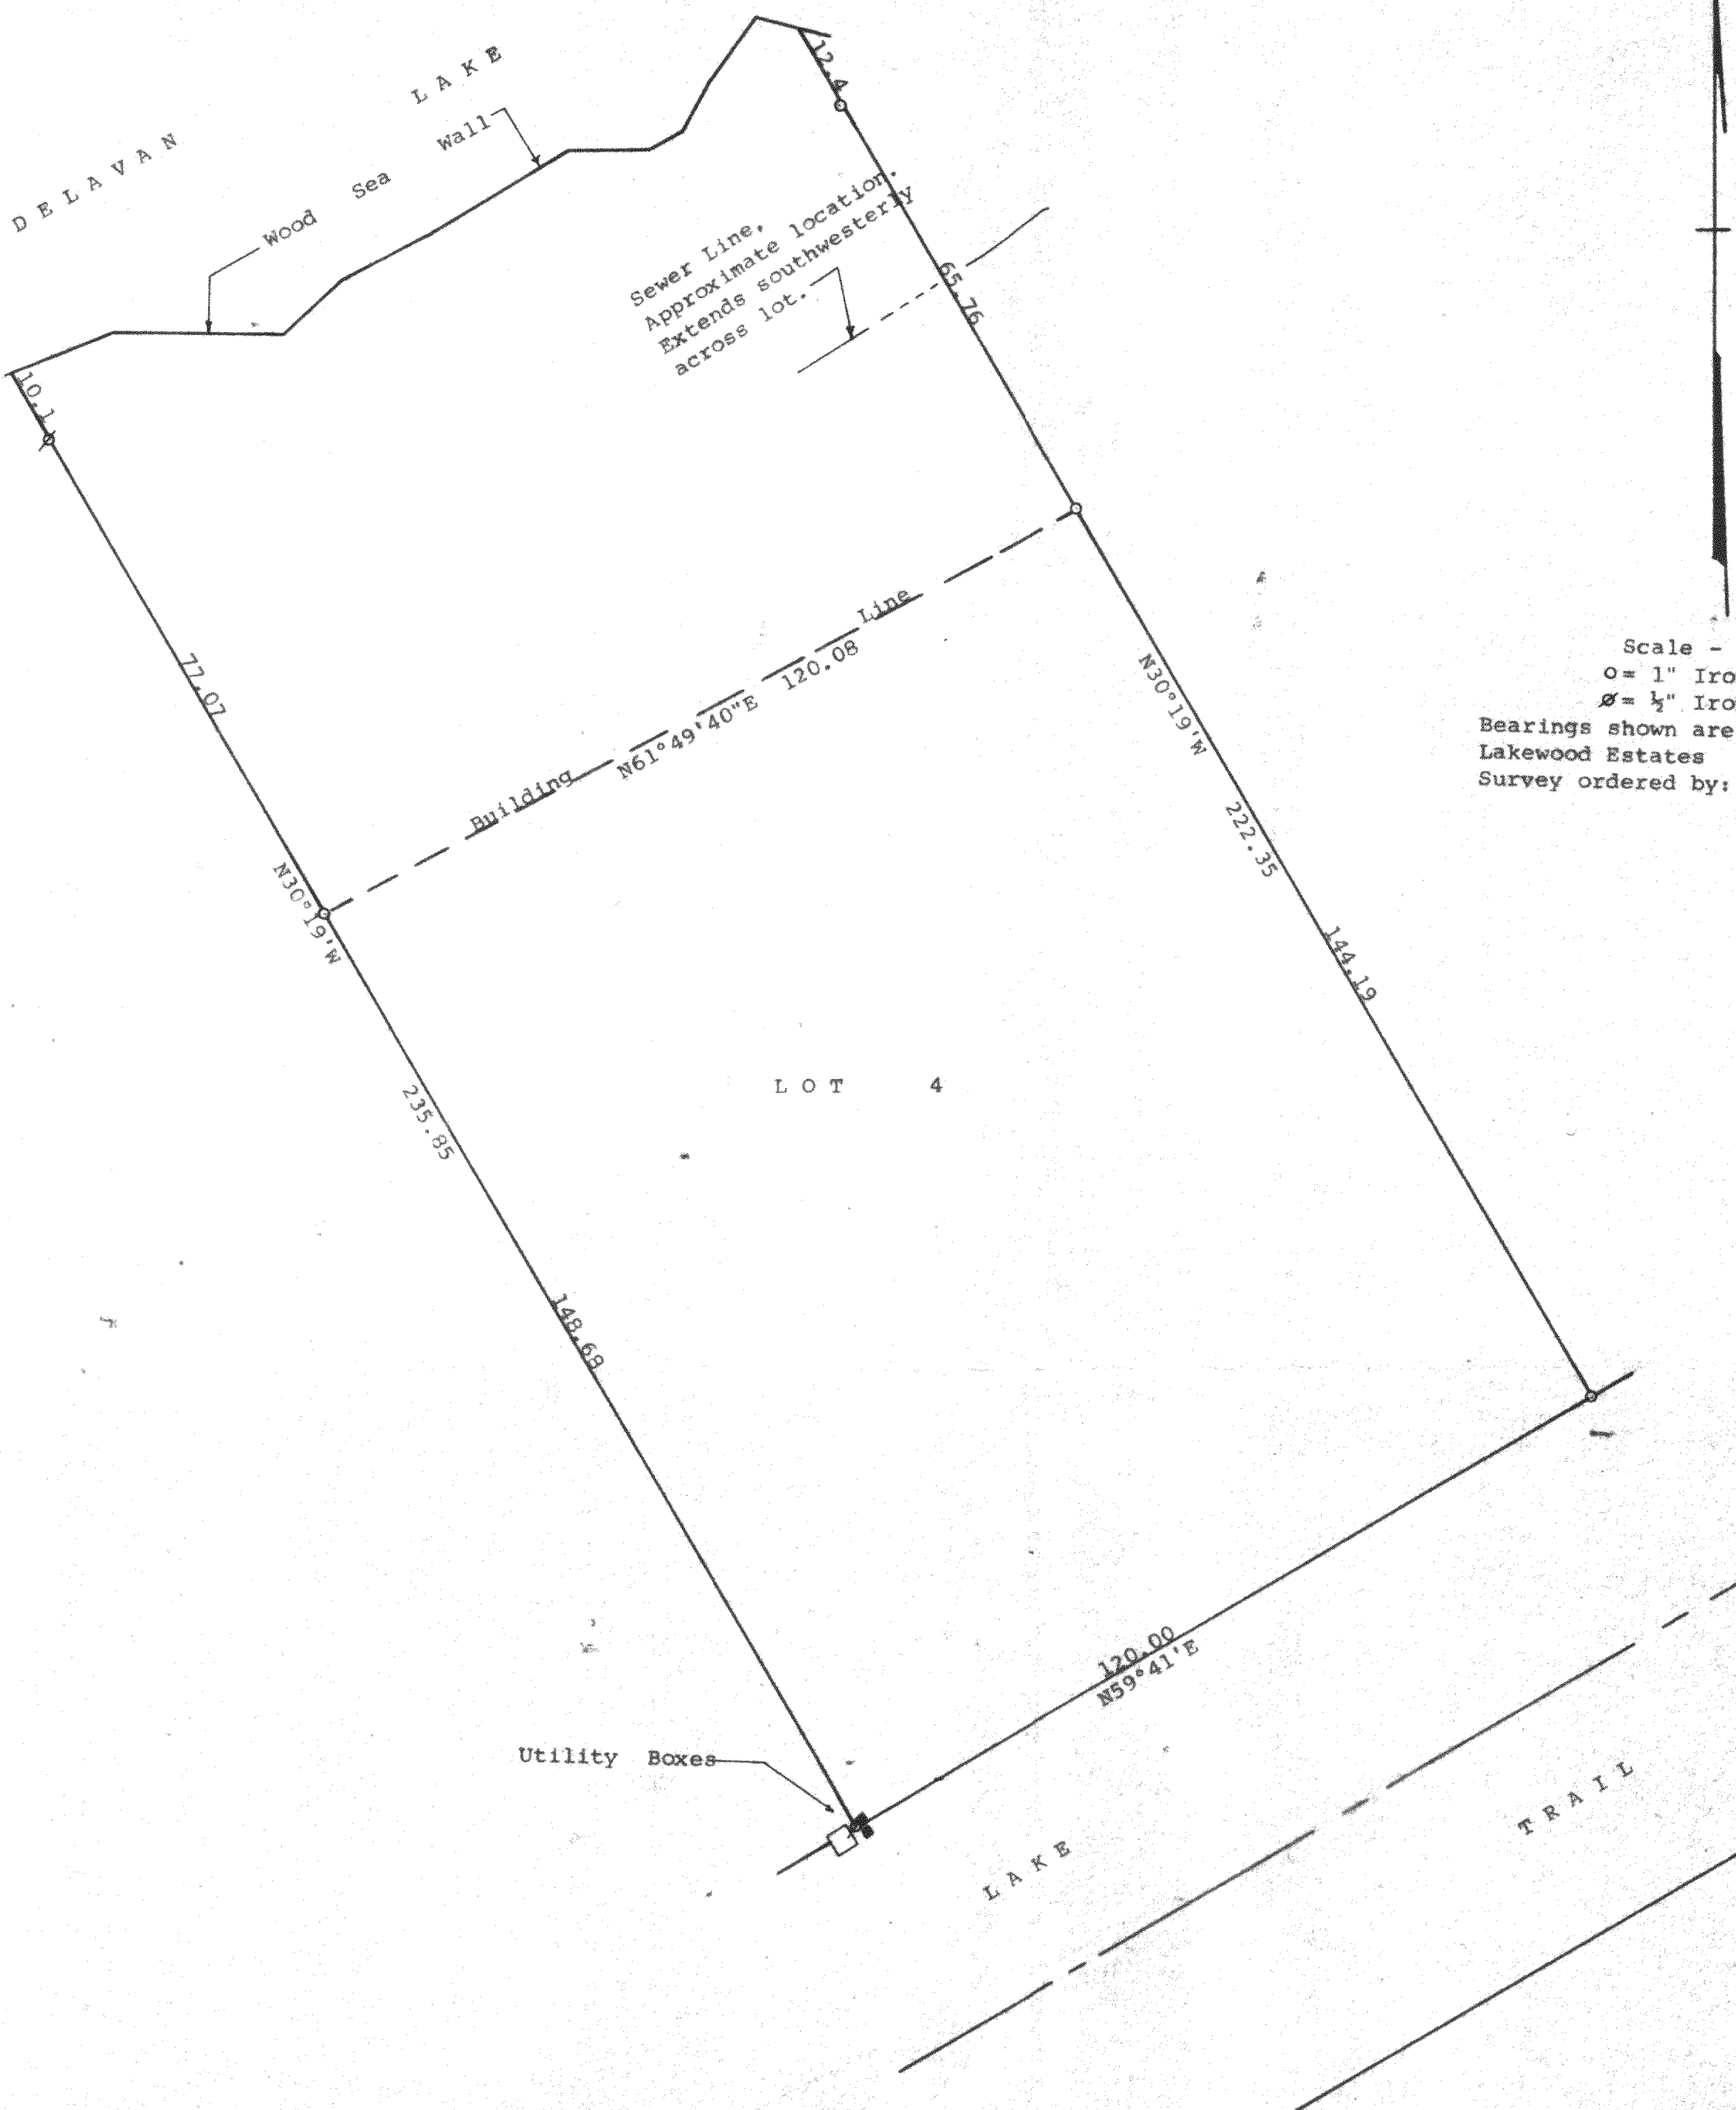

Scale - 1" = 20'
O = 1" Iron Pipe Found
Ø = 1/2" Iron Pipe Found
Bearings shown are those on the recorded plat of
Lakewood Estates
Survey ordered by: Century 21, Skandia Realty
312 South 7th Street
Delavan, WI 53115

STATE OF WISCONSIN)
COUNTY OF WALWORTH) SS

I, George T. Dunham, Surveyor, certify that I have surveyed the
property described as follows:

Lot 4 in Lakewood Estates, a subdivision located in the
Southwest 1/4 of Section 21, T 2 N, R 16 E, Walworth County,
Wisconsin, subject to easements of record

and that the plat shown hereon is a correct representation thereof and shows
the size and location of the property, its exterior boundaries, the location
of all visible structures and dimensions of all principal buildings thereon,
boundary fences, apparent easements, roadways and visible encroachments, if
any, and that I have surveyed the property hereon described, according to the
official records, to the best of my knowledge and belief.
July 26, 1991

George T. Dunham
George T. Dunham, Surveyor

