


DUNHAM SURVEYING, S.C.
SURVEYING & SUBDIVIDING
DELAVER, WISCONSIN 53115

N

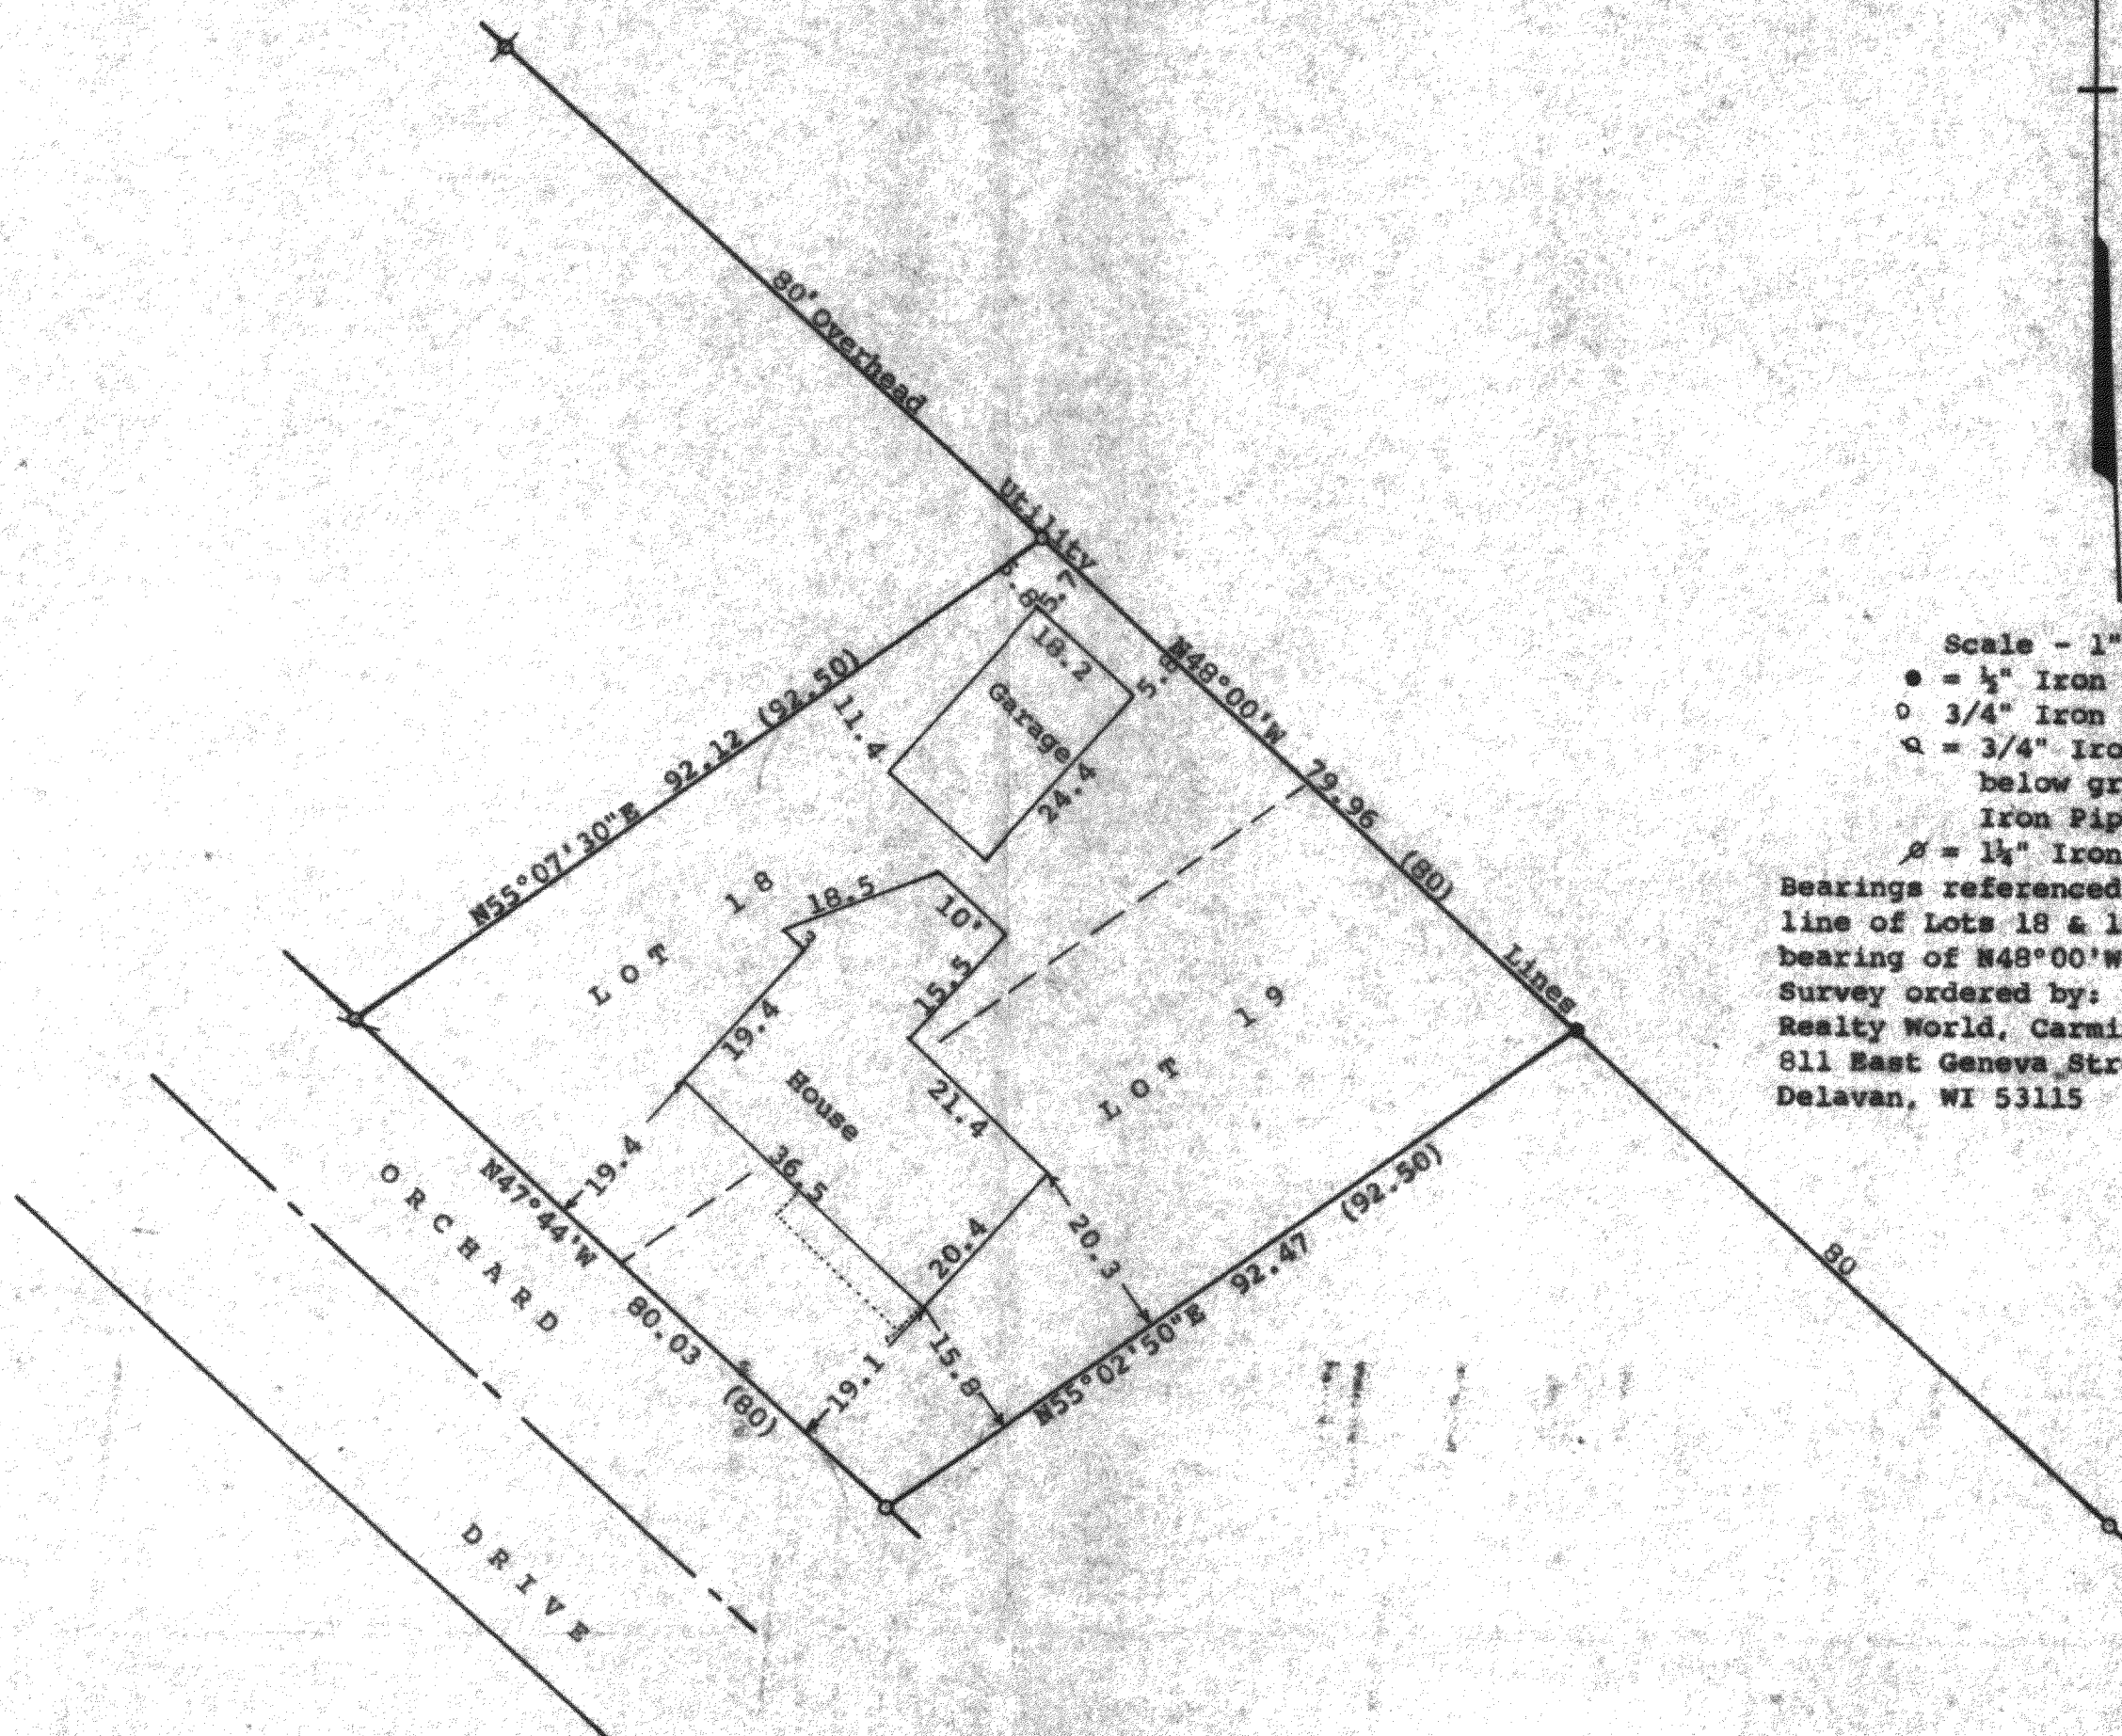

Scale - 1" = 20'
● = 1/4" Iron Rod Found
○ = 3/4" Iron Pipe Found
Q = 3/4" Iron Pipe Found 0.8' below ground. Set 3/4" X 24" Iron Pipe at surface
Ø = 1 1/4" Iron Pipe Found
Bearings referenced to the northeasterly line of Lots 18 & 19 with the assumed bearing of N48°00'W
Survey ordered by:
Realty World, Carmin Realtors
811 East Geneva Street
Delavan, WI 53115

STATE OF WISCONSIN) SS
COUNTY OF WALWORTH)

I, George T. Dunham, Surveyor, certify that I have surveyed the property described as follows:

Lots 18 and 19 in Block 7, South Shore Manor, a subdivision located in the Southeast Fractional 1/4 of Section 32, T 2 N, R 16 E, Walworth County, Wisconsin,

and that the plat shown hereon is a correct representation thereof and shows the size and location of the property, its exterior boundaries, the location of all visible structures and dimensions of all principal buildings thereon, boundary fences, apparent easements, roadways and visible encroachments, if any, and that I have surveyed the property hereon described, according to the official records, to the best of my knowledge and belief.
May 21, 1991

George T. Dunham
George T. Dunham, Surveyor

