


DUNHAM SURVEYING, S.C.
SURVEYING & SUBDIVIDING
DELAVER, WISCONSIN 53115

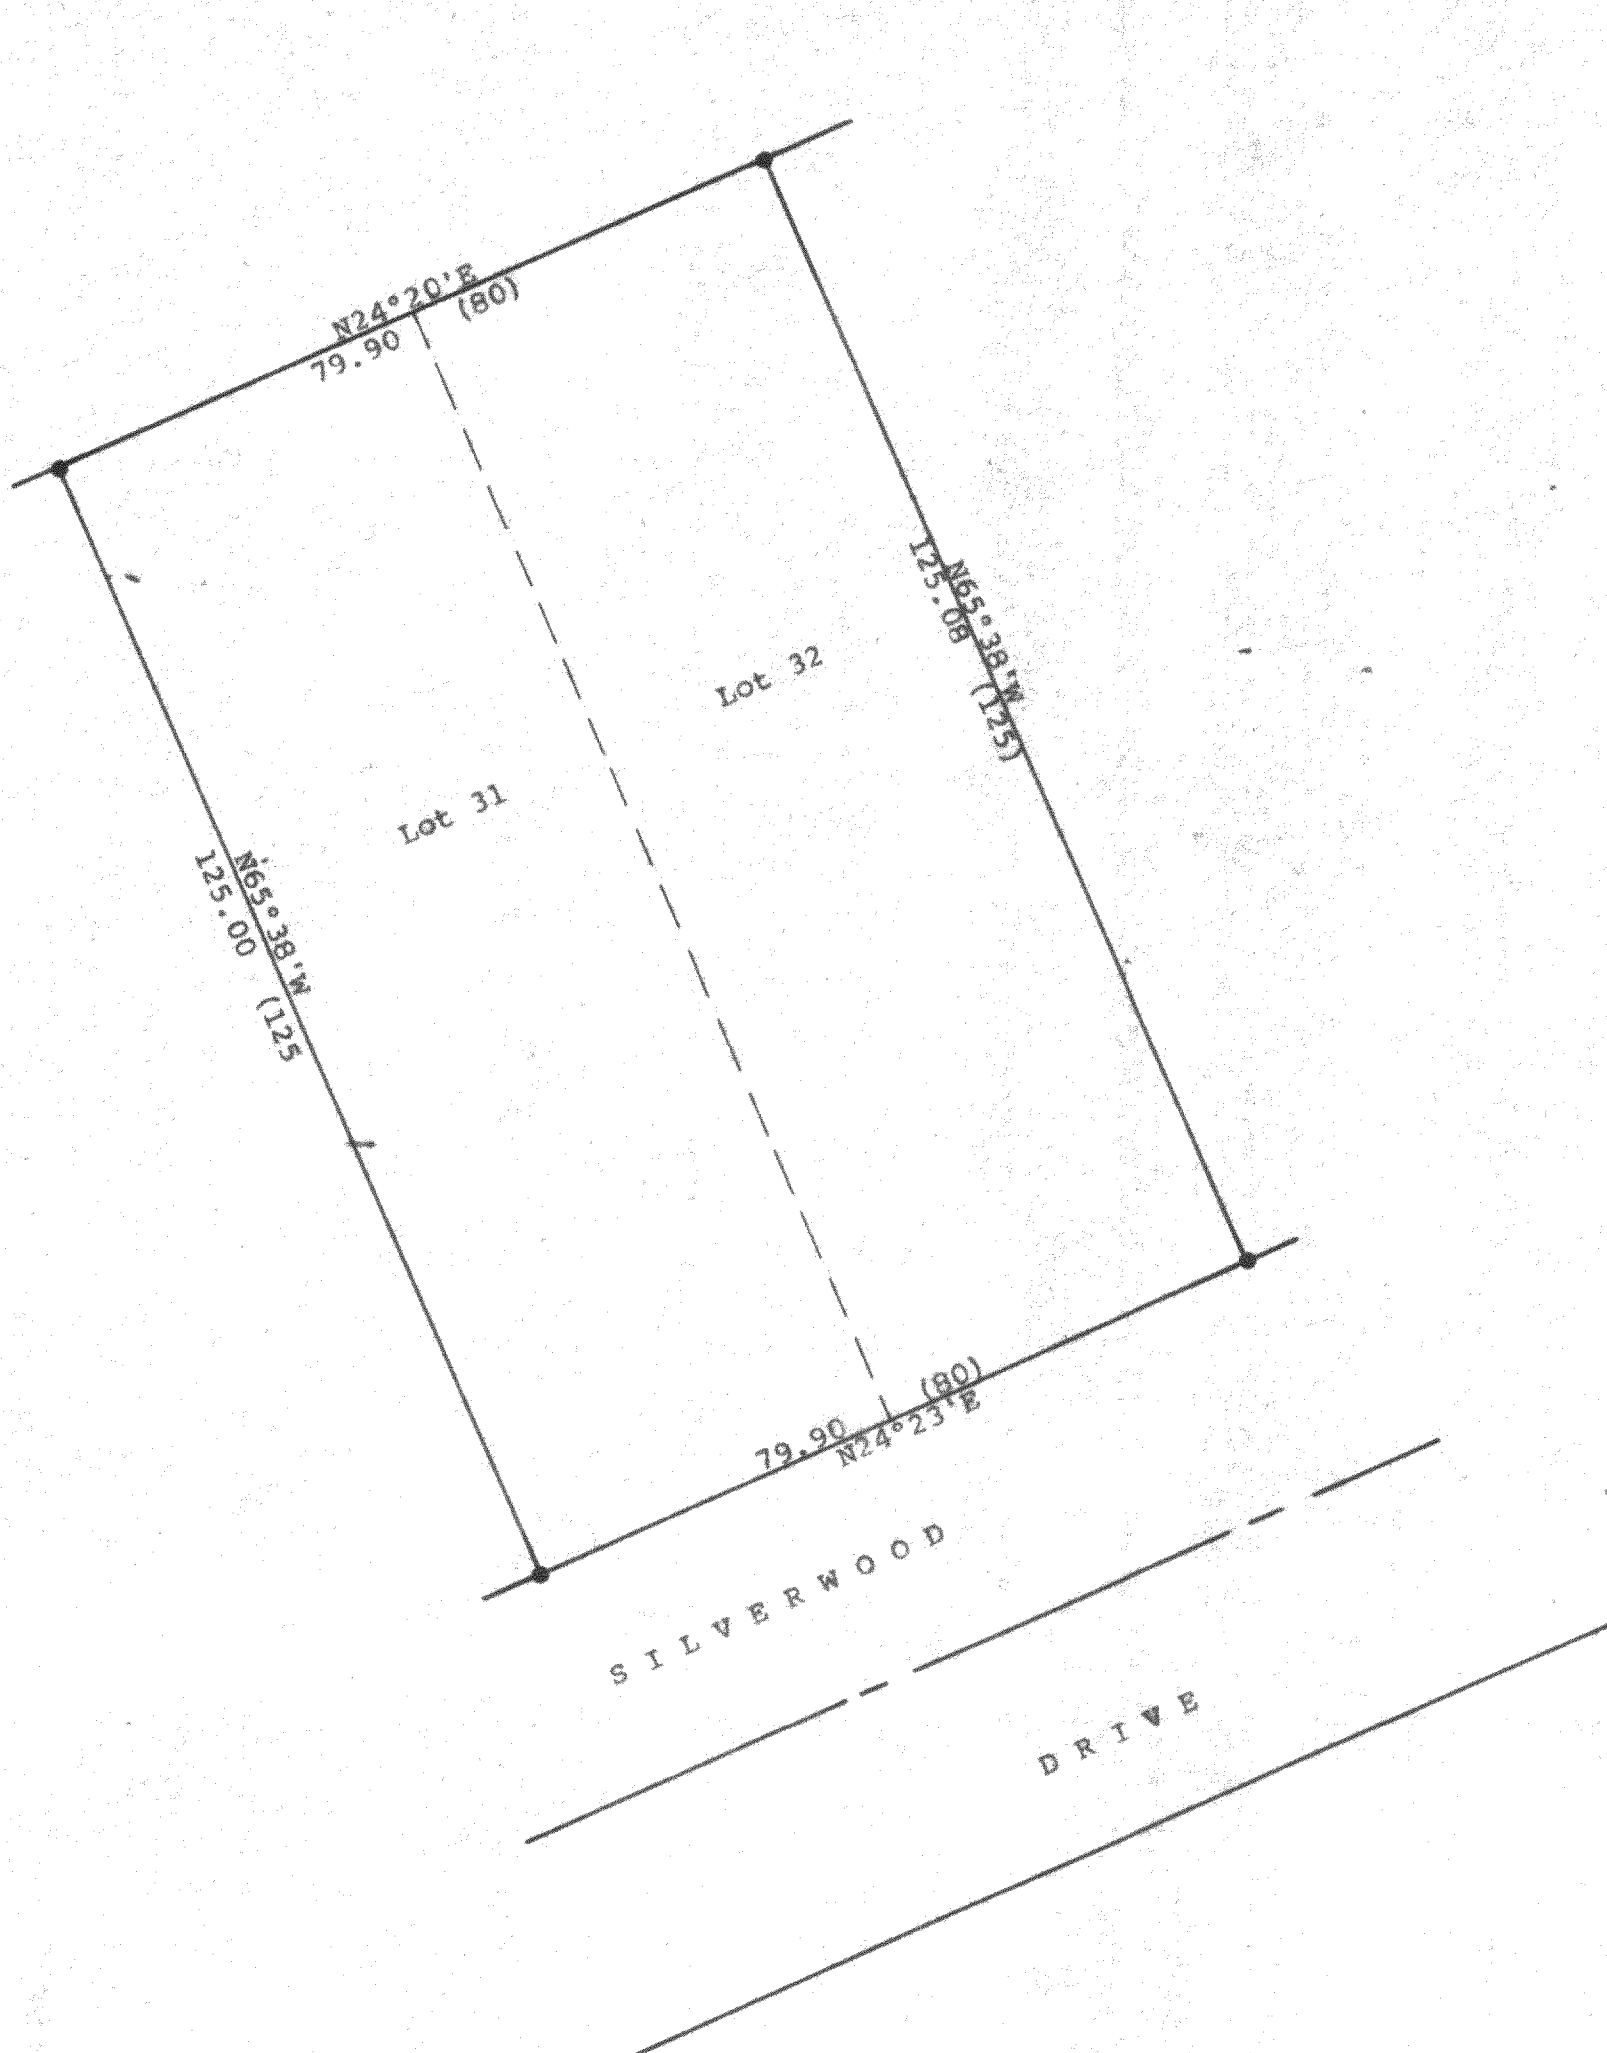

Scale - 1" = 20'
● = Concrete Monument Found (Homemade)
(0.00) = recorded distance
Bearings referenced to the assumed bearing of
N24°23'E along the northerly line of Silverwood
Drive
Survey ordered by:
Jane Bohn
Century 21, Skandia Realty
312 South 7th Street
Delavan, WI 53115

STATE OF WISCONSIN)
COUNTY OF WALWORTH)SS

I, George T. Dunham, Surveyor, certify that I have surveyed the
property described as follows:

Lots 31 and 32 in Block 12, Delavan Lake View Crest, a subdivision
located in Fractional Section 31, T 2 N, R 16 E, Walworth County,
Wisconsin

and that the plat shown hereon is a correct representation thereof and shows
the size and location of the property, its exterior boundaries, the location
of all visible structures and dimensions of all principal buildings thereon,
boundary fences, apparent easements, roadways and visible encroachments, if
any, and that I have surveyed the property hereon described, according to the
official records, to the best of my knowledge and belief.

November 1, 1991

George T. Dunham
George T. Dunham, Surveyor

