


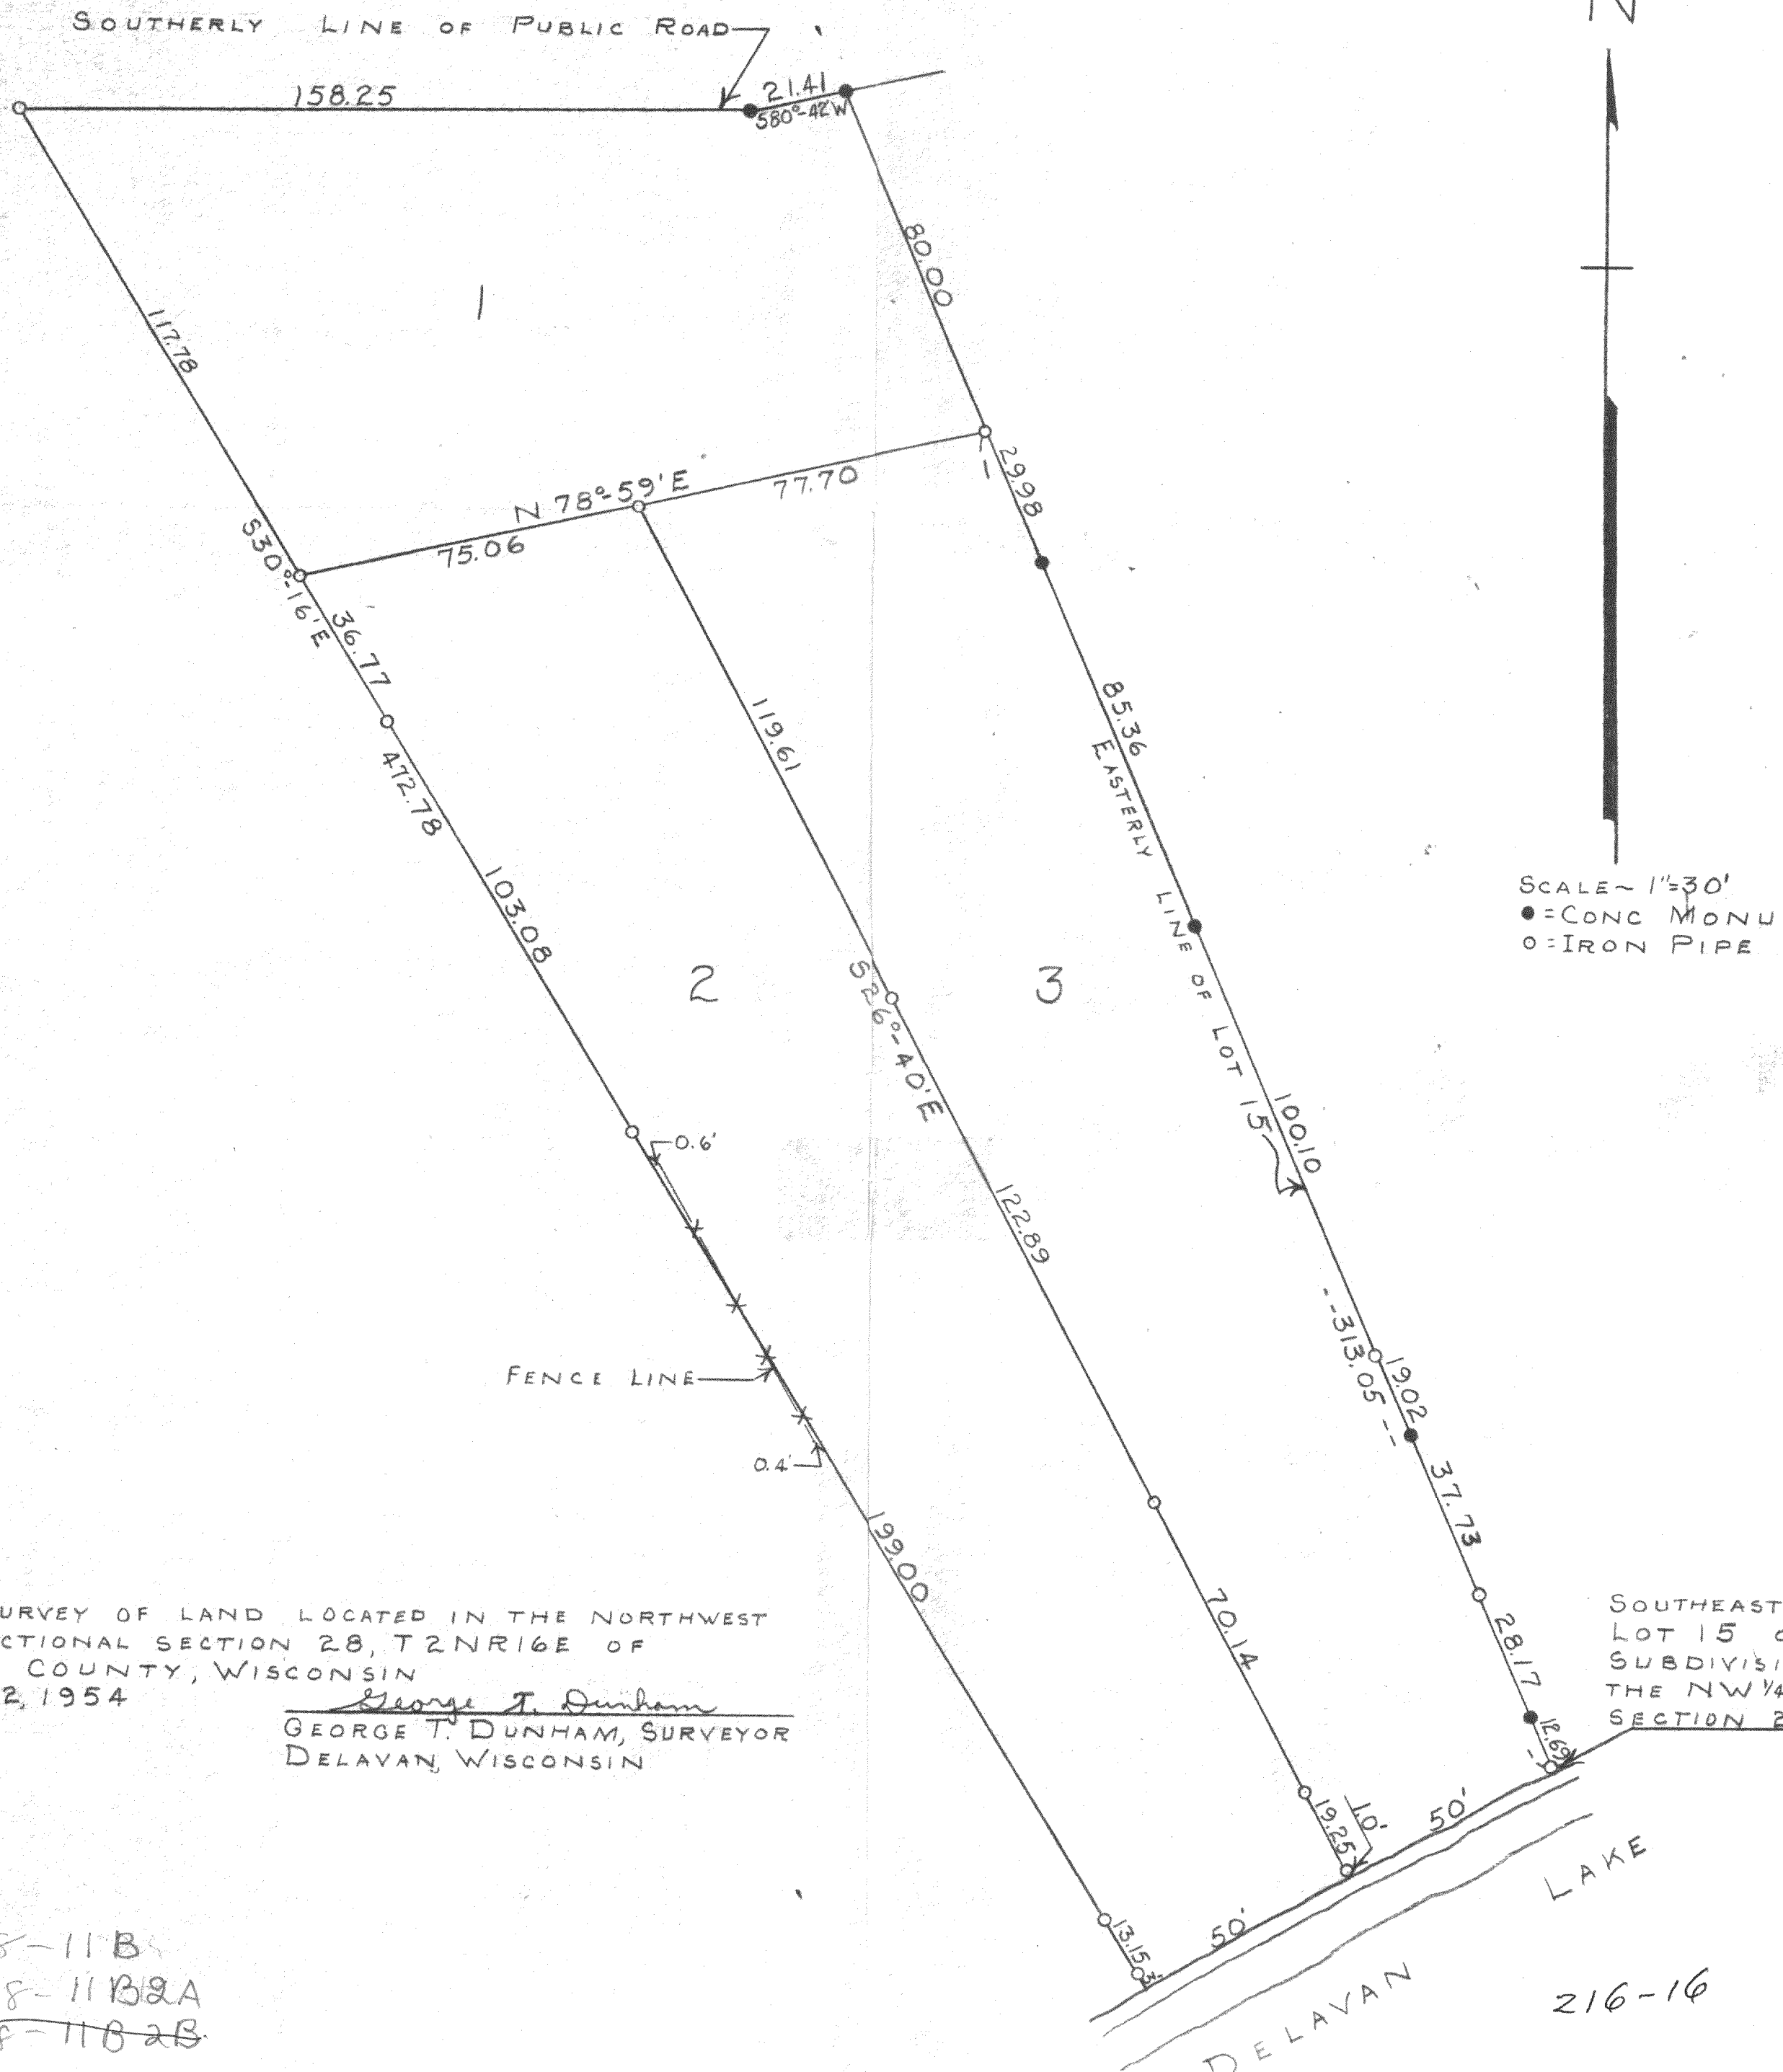

PLAT OF SURVEY OF LAND LOCATED IN THE NORTHWEST
 1/4 OF FRACTIONAL SECTION 28, T2N R16E OF
 WALWORTH COUNTY, WISCONSIN
 AUGUST 12, 1954
George T. Dunham
 GEORGE T. DUNHAM, SURVEYOR
 DELAVAN, WISCONSIN

SOUTHEAST CORNER OF
 LOT 15 OF ST. MARY'S
 SUBDIVISION LOCATED IN
 THE NW 1/4 OF FRACTIONAL
 SECTION 28, T2N R16E

FSR
 D-28-11B
 D-28-11B2A
 D-28-11B2B