


Wisconsin Registered Land Surveyor S-1594

Rt. 3, Box 273
Elkhorn, Wisconsin 53121
Phone: (414) 723-4260 (office)
(414) 723-4813 (residence)

PLAT OF SURVEY

THE NORTH 1/2 OF LOT 12 AND LOT 13
OF BLOCK "O" OF DELAVAN LAKE
ASSEMBLY GROUNDS SUBDIVISION LOCATED
IN THE SOUTHEAST 1/4 OF SECTION 21,
TOWN 2 NORTH, RANGE 16 EAST, TOWN OF
DELAN, WALWORTH COUNTY, WISCONSIN.


OWNER: CHARLES MAZUROWSKI
1115 SIOUX ROAD
DELAN, WI. 53115

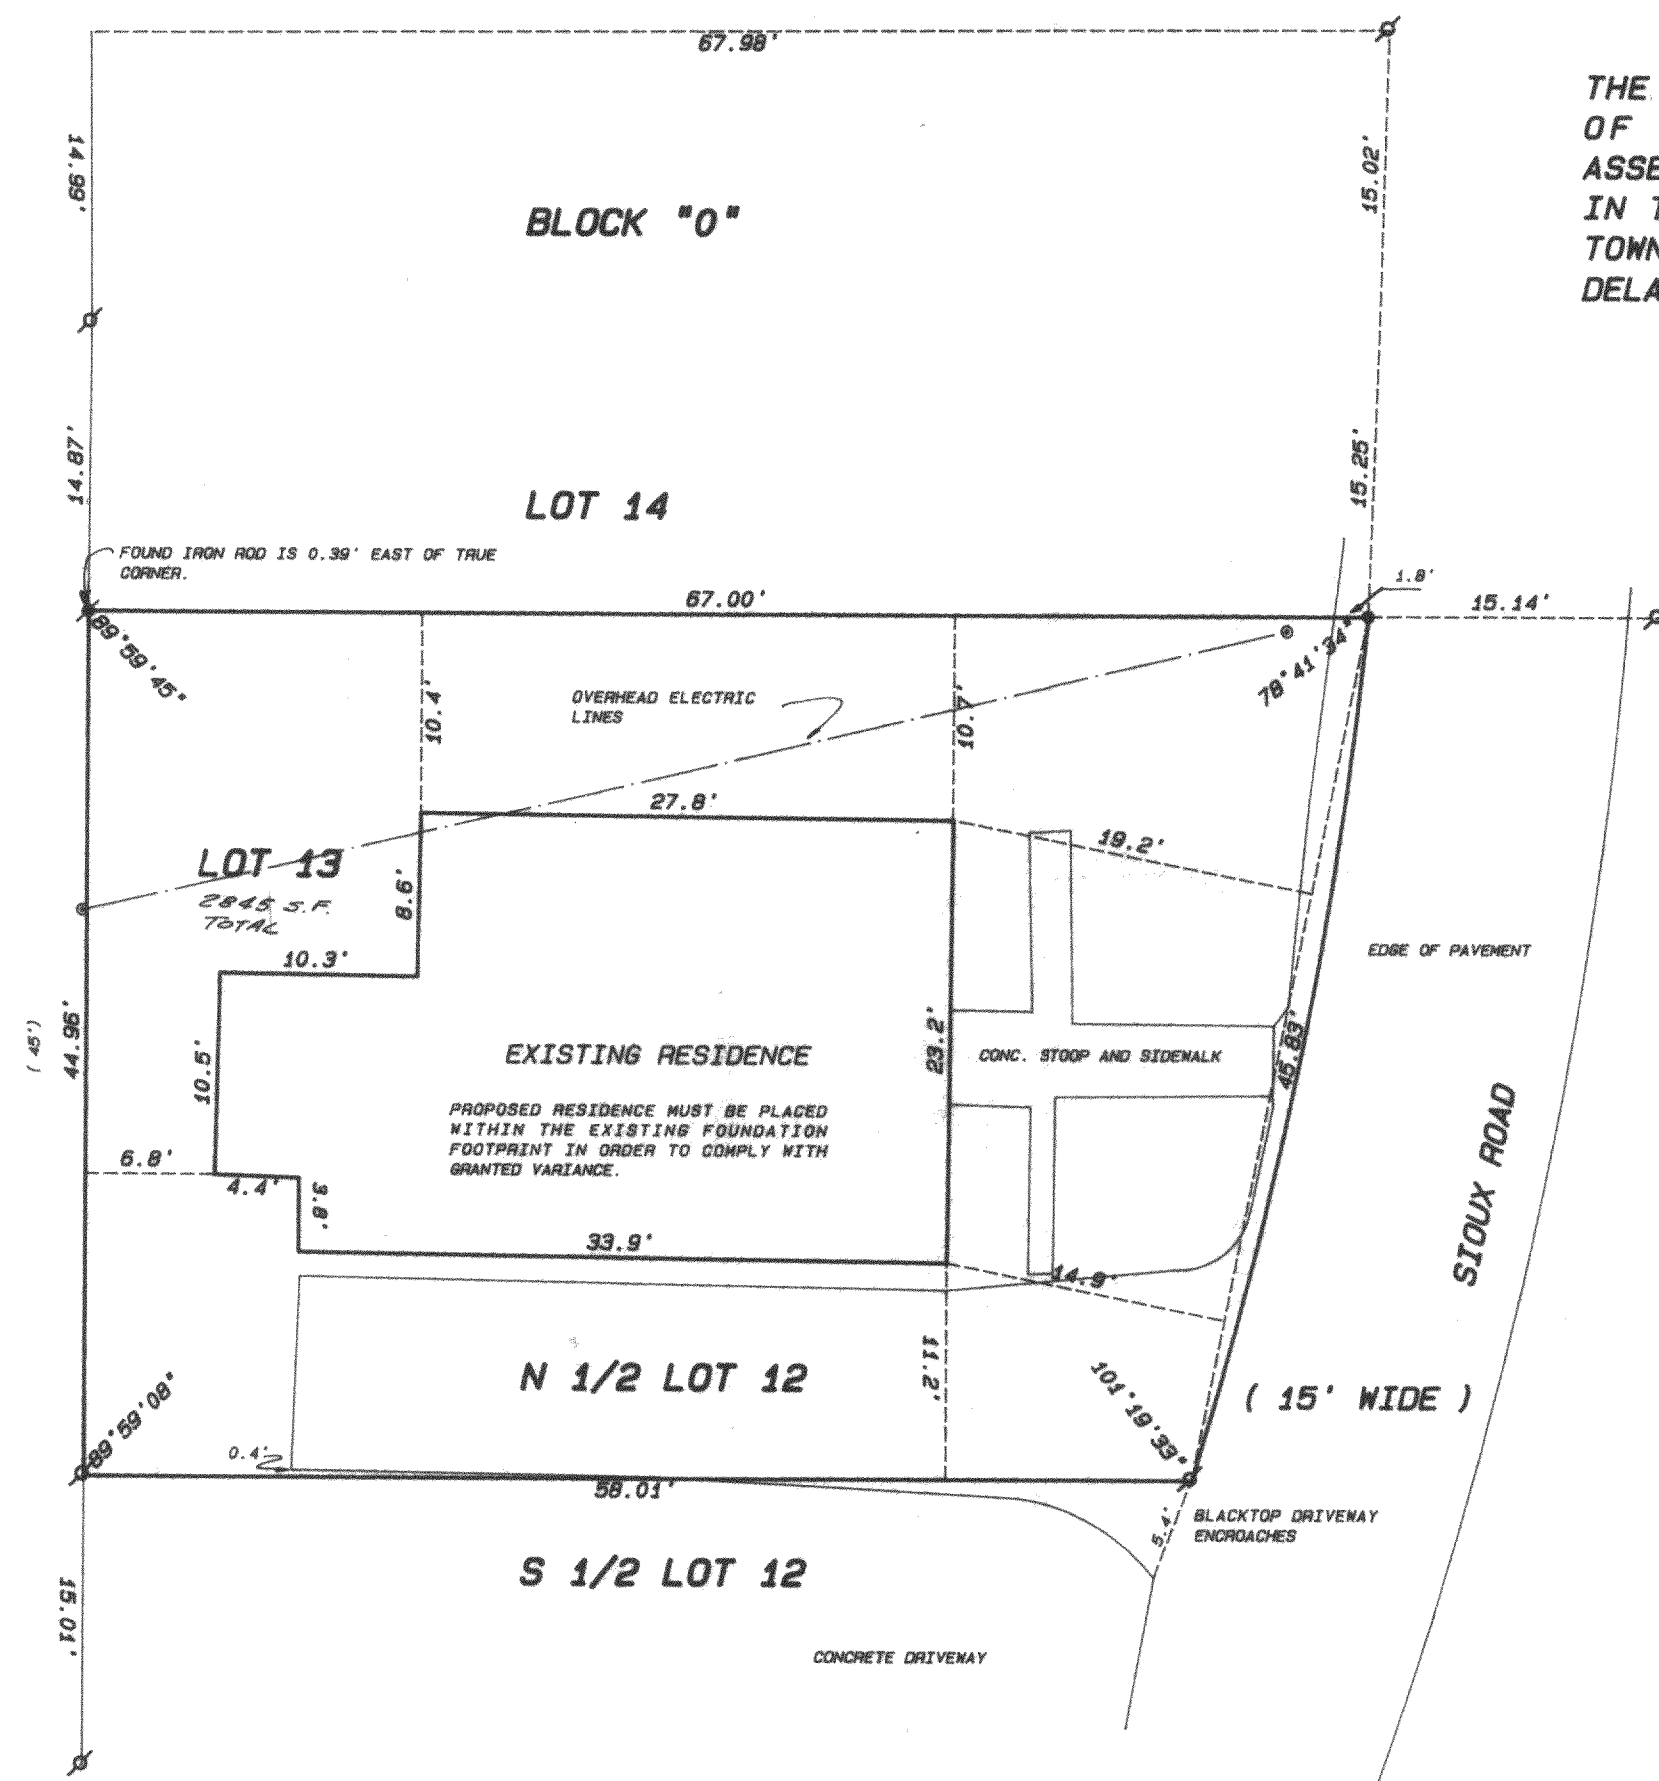

SCALE 1"= 10 FEET

Legend

- FOUND IRON PIPE
FOUND IRON ROD
FOUND BRASS CAPPED MONUMENT
FOUND CONCRETE MONUMENT
CHISEL CUT IN CONCRETE
SET IRON ROD, 24" LONG, WEIGHING
1.5 LBS./LINEAL FT., 3/4" DIA.
SET IRON ROD, 30" LONG, WEIGHING
4.5 LBS./LINEAL FT., 1-11/16" DIA.
(xx) RECORDED AS DIMENSION
EXISTING FENCE

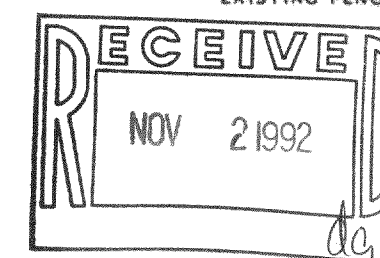

SCALE: 1" = 10 FEET

"I hereby certify that I have surveyed the above described property and that the above map is a true representation thereof and shows the size and location of the property, its exterior boundaries, the location of all visible structures and dimensions of all principal buildings thereon, boundary fences, apparent easements, roadways and visible encroachments, if any."

"This survey is made for the use of the present owners of the property, and also those who purchase, mortgage, or guarantee the title thereto within one year from date hereof."

guarantee the title thereto within one year from date hereof."

Kenneth B. Abernathy, Jr.

KENNETH B. ABERNATHY, JR.
WISCONSIN REGISTERED LAND SURVEYOR,

Date: 10/6/92 Job No. 92.914



216-1604

FDLA-151