


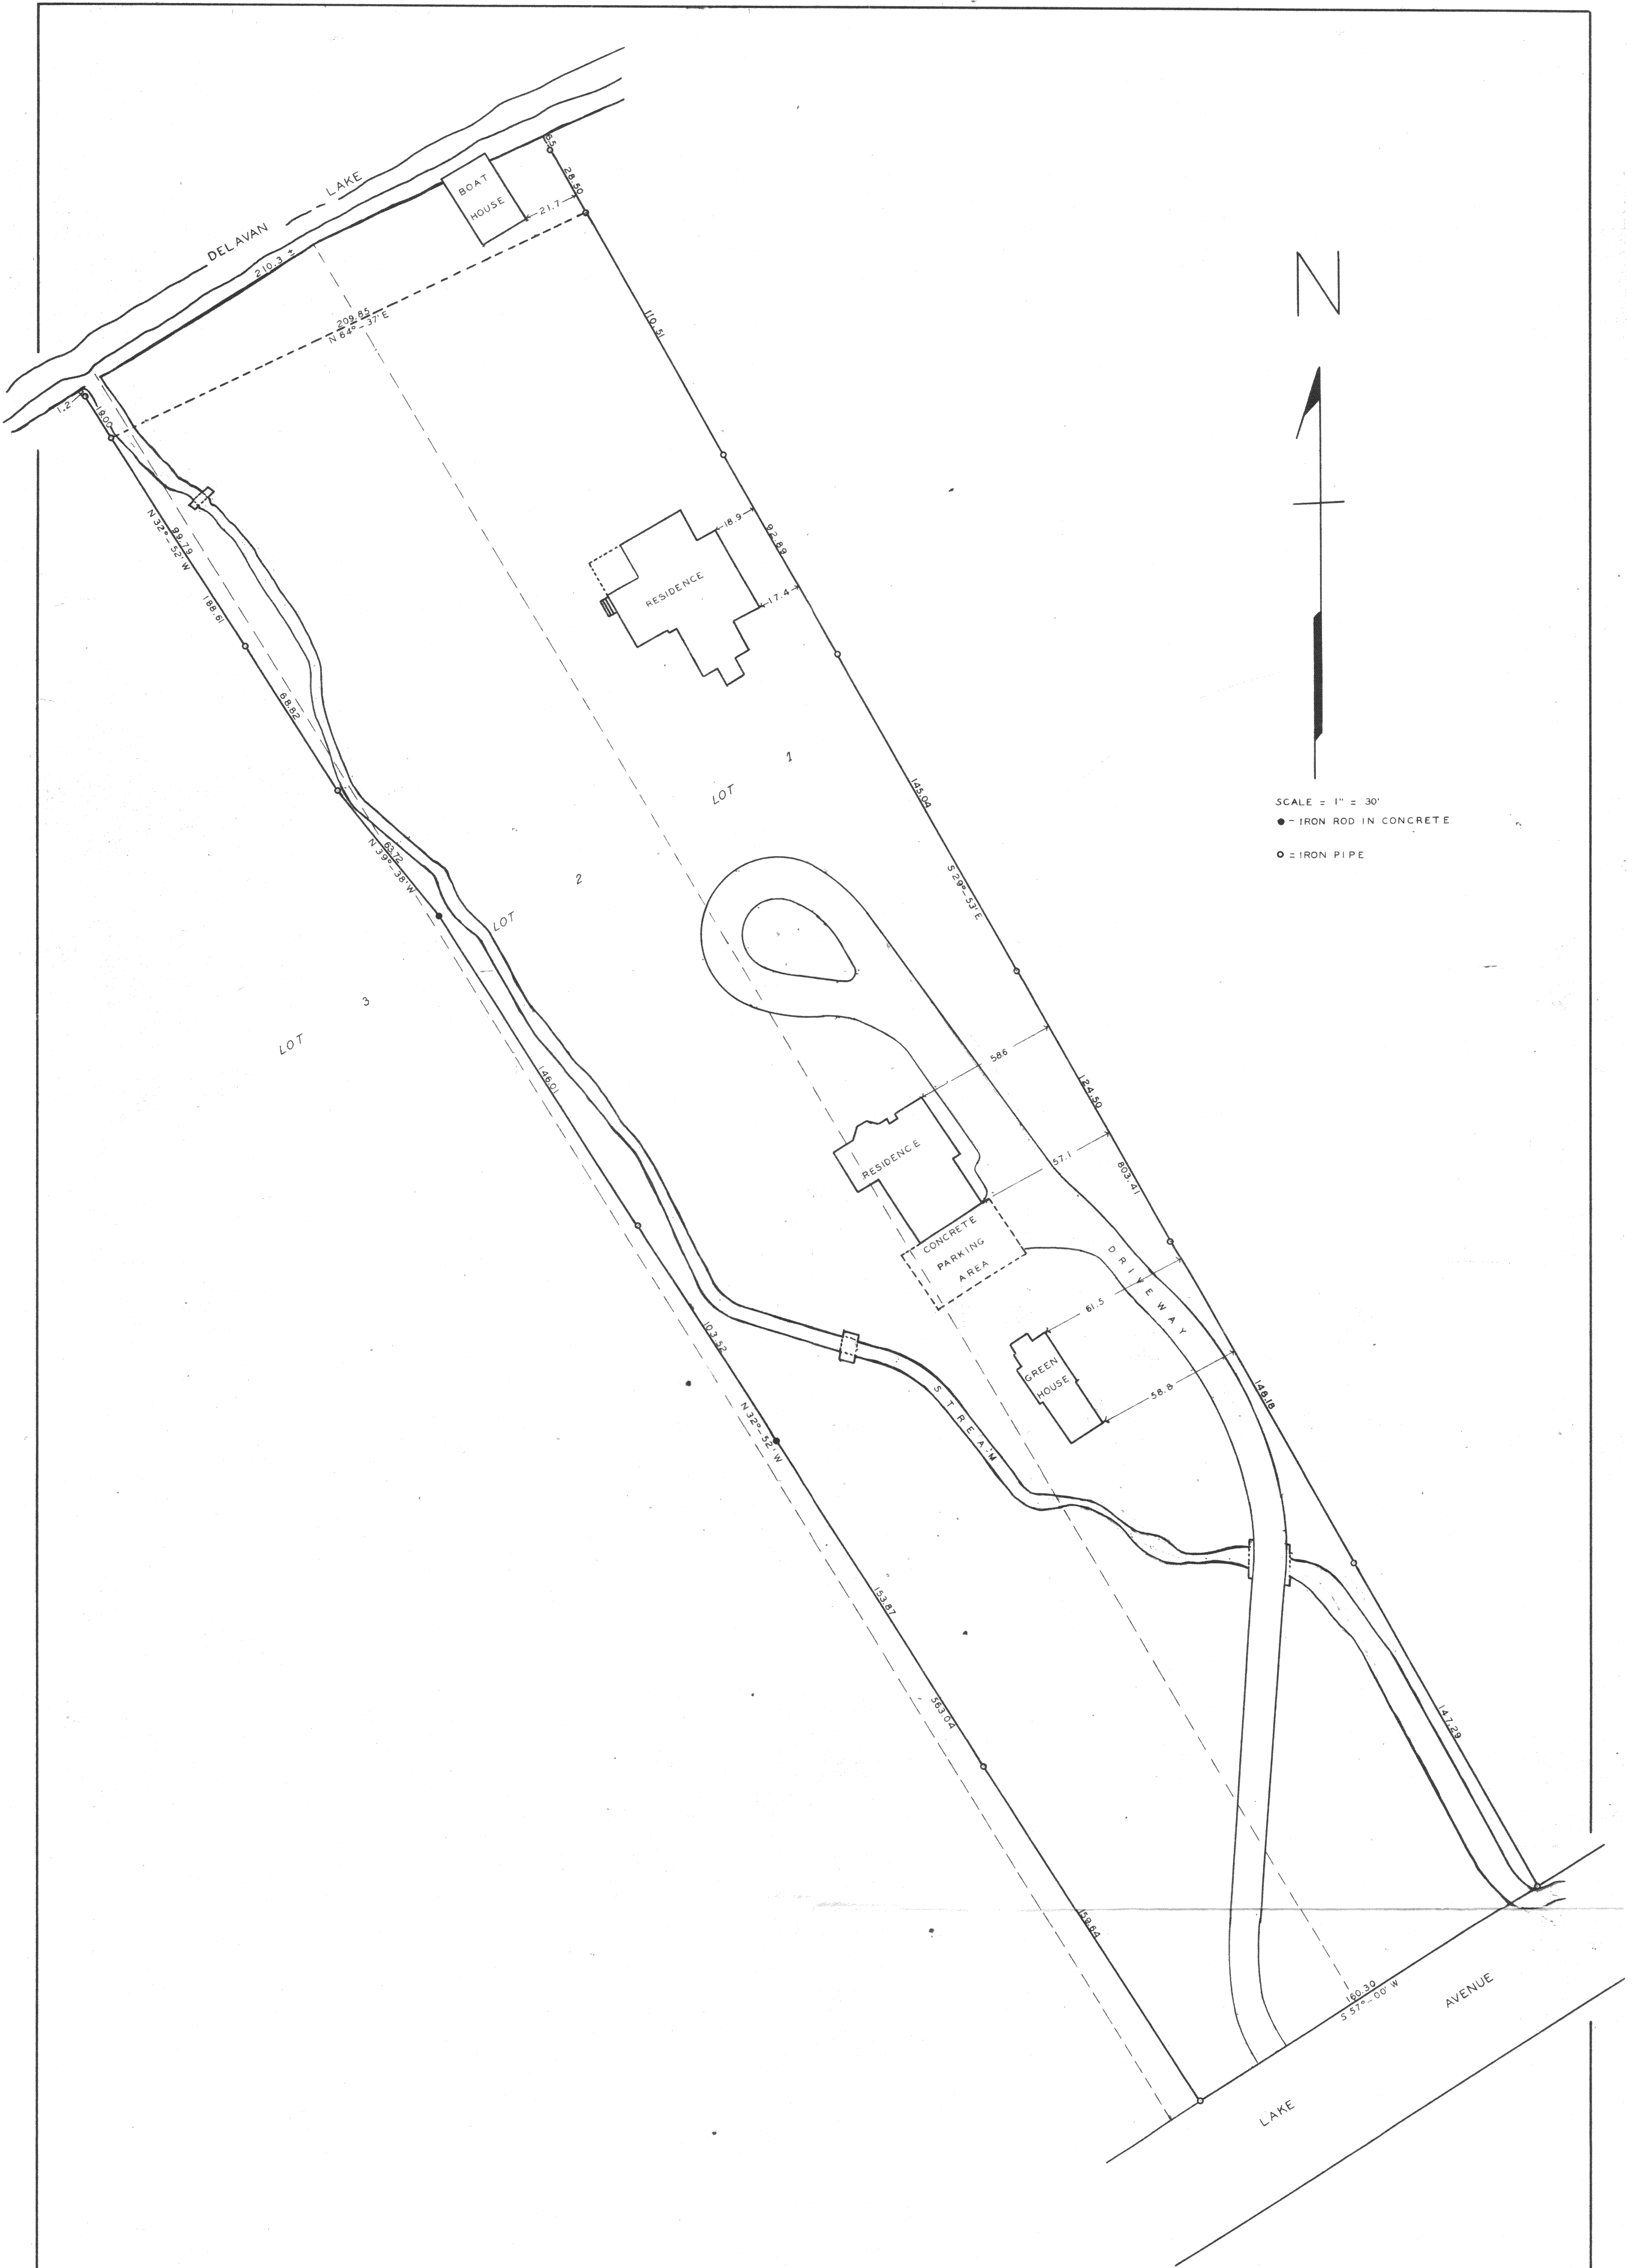

Plat of survey of land described as follows; a parcel of land located in Lots 1, 2, and 3 of Barnes & Von Suessmlich Subdivision in Section 33, T 2 N, R 16 E of 4 P. M., Walworth County, Wisconsin, described as follows, to-wit: Beginning at a point in the southeasterly line of said Lot 2 located 13.00 feet northeasterly of the southeast corner thereof; thence N 32° - 52' W 563.04 feet to an iron rod in concrete; thence N 39° - 38' W 63.72 feet to an iron pipe; thence N 32° - 52' W 188.61 feet more or less to the shore of Delavan Lake; thence northeasterly along the shore of Delavan Lake 210.3 feet more or less to the northeast corner of said Lot 1; thence S 29° - 53' E along the northeasterly line of said Lot 1, 803.41 feet to the southeast corner of said Lot 1; thence S 57° - 00' W along the southeasterly line of said Lots 1 and 2, 160.30 feet to the place of beginning.

August 1964

George T. Dunham
George T. Dunham, Surveyor