


ABELL
SURVEYING & MAPPING

DELAVAN, WISCONSIN 53115

414-728-6737

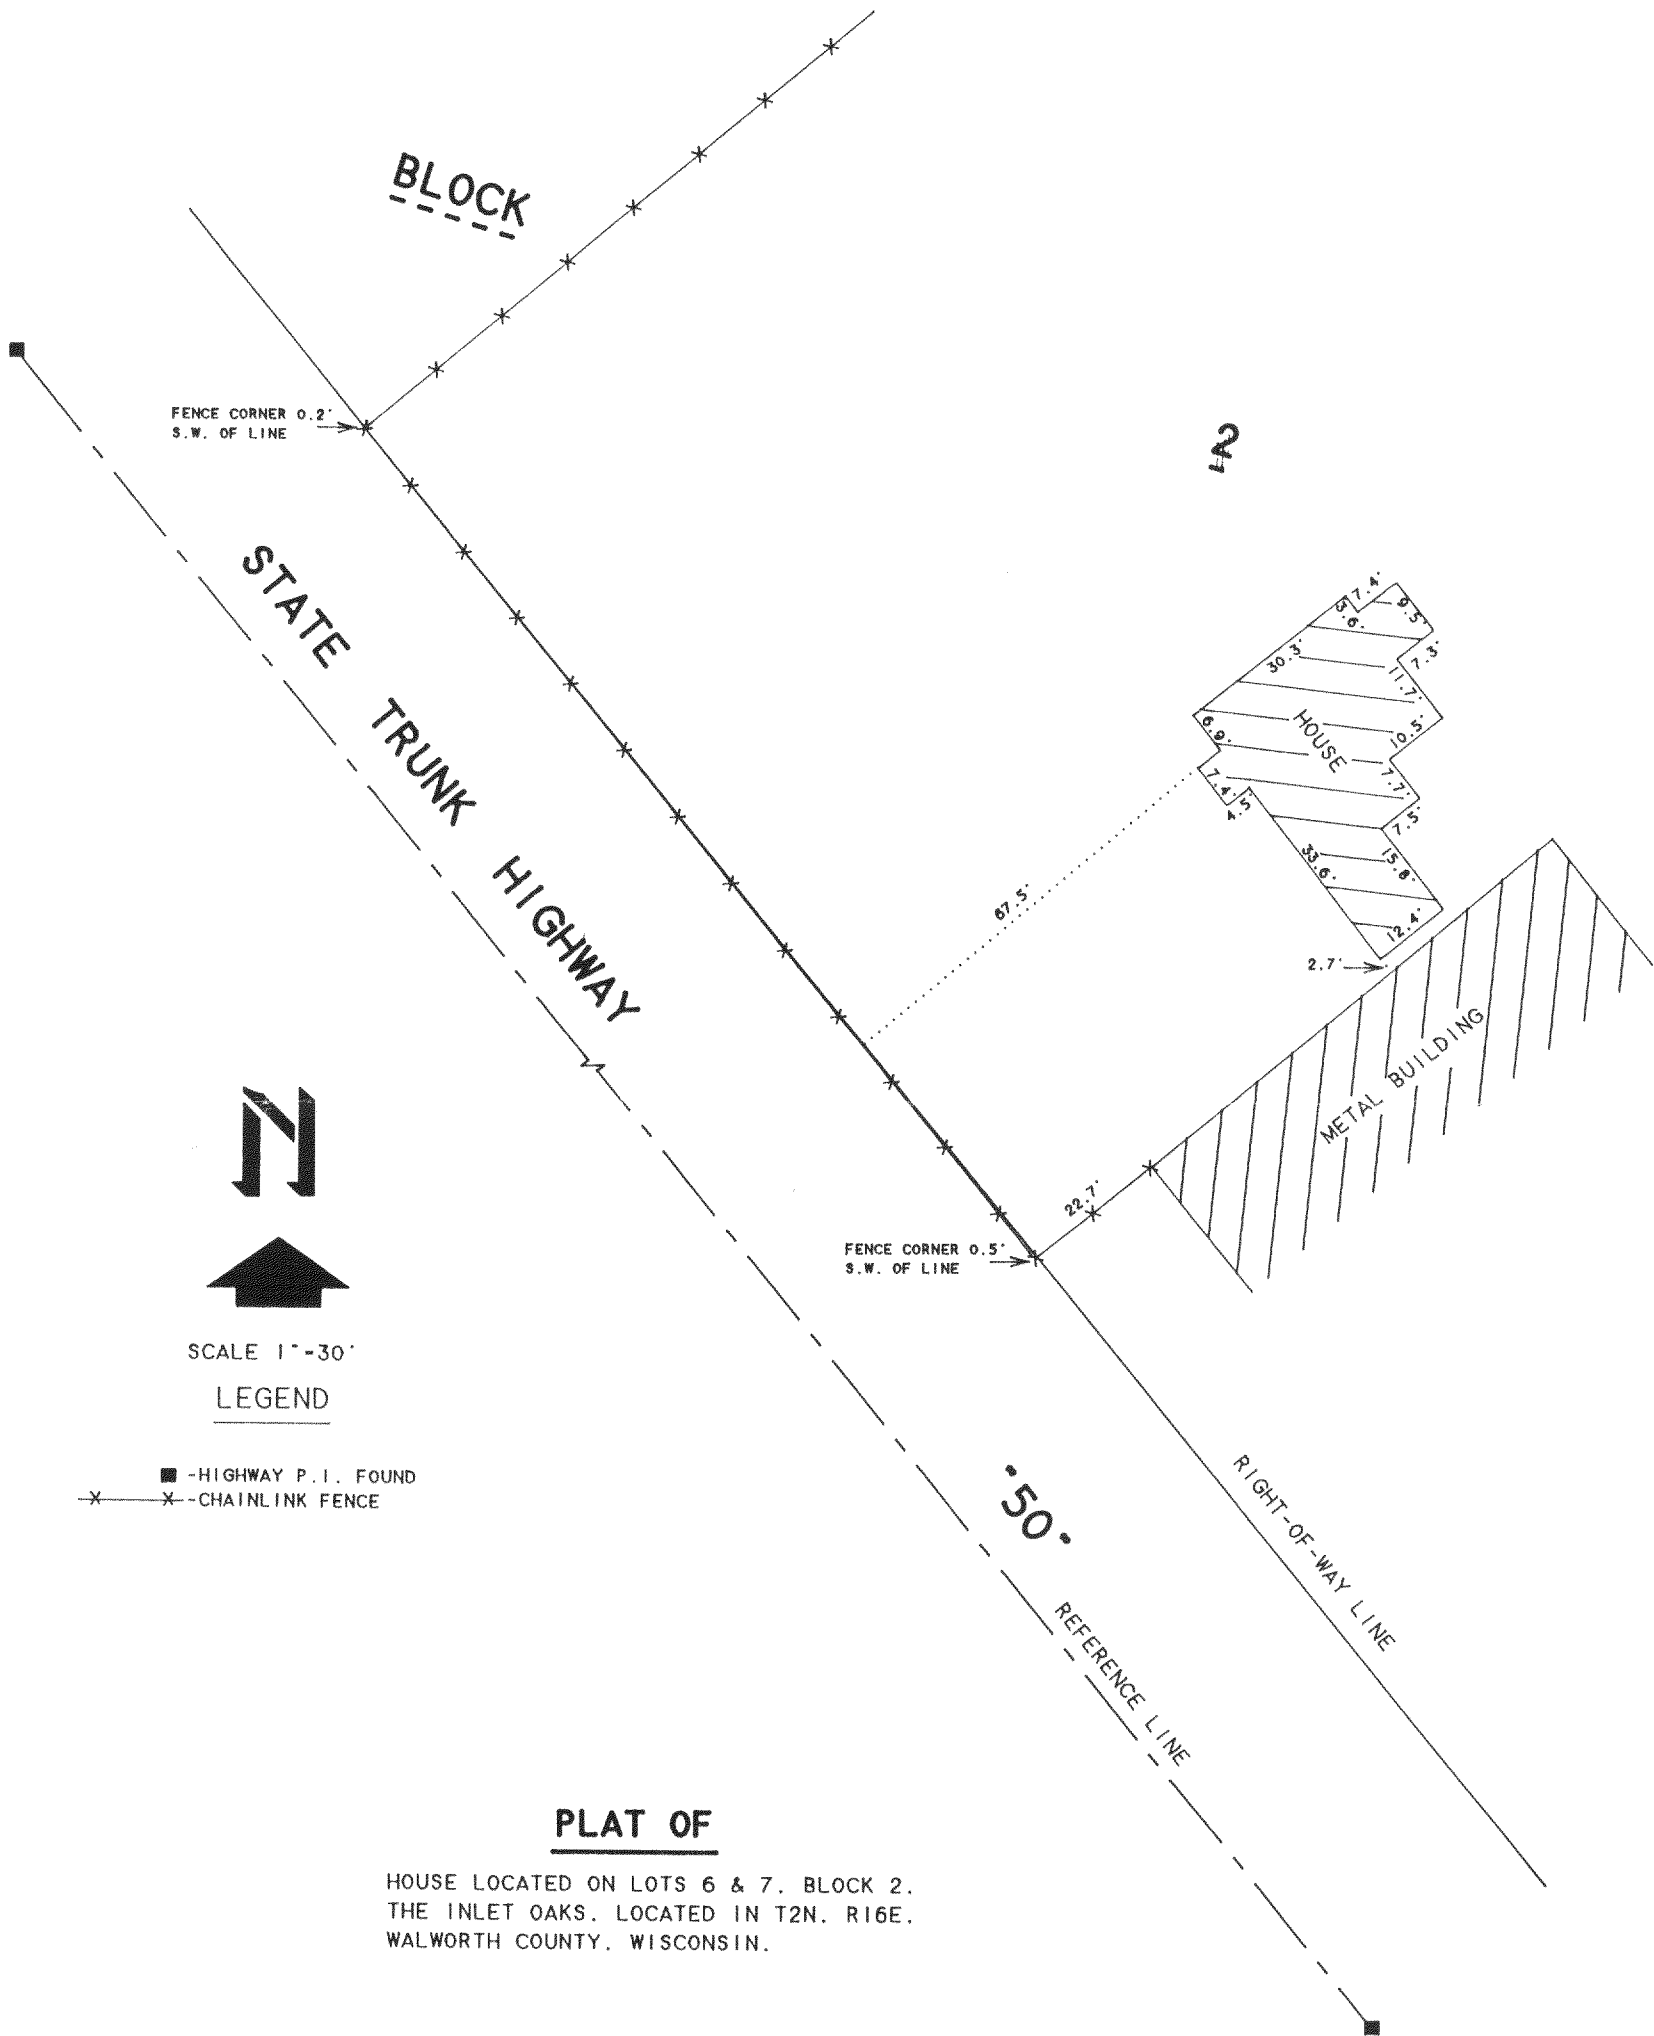

SCALE 1"=30'


LEGEND

- -HIGHWAY P.I. FOUND
- X-X-CHAINLINK FENCE

PLAT OF

HOUSE LOCATED ON LOTS 6 & 7, BLOCK 2,
THE INLET OAKS, LOCATED IN T2N, R16E,
WALWORTH COUNTY, WISCONSIN.

ORDERED BY: HAROLD JOHNSON
P.O. BOX 466
DELAVAN, WI. 53115

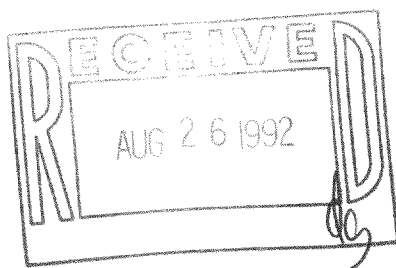

David F. Abell

DAVID F. ABELL
WISCONSIN REGISTERED LAND SURVEYOR, S-1596

JUNE 11, 1992

DATE JOB NUMBER - 92110
NOTE: THIS IS NOT A CERTIFIED COPY UNLESS SEALED.

216-1621

FIN-13
FIN-14