


DUNHAM SURVEYING, S.C.
SURVEYING & SUBDIVIDING
DELAVER, WISCONSIN 53115

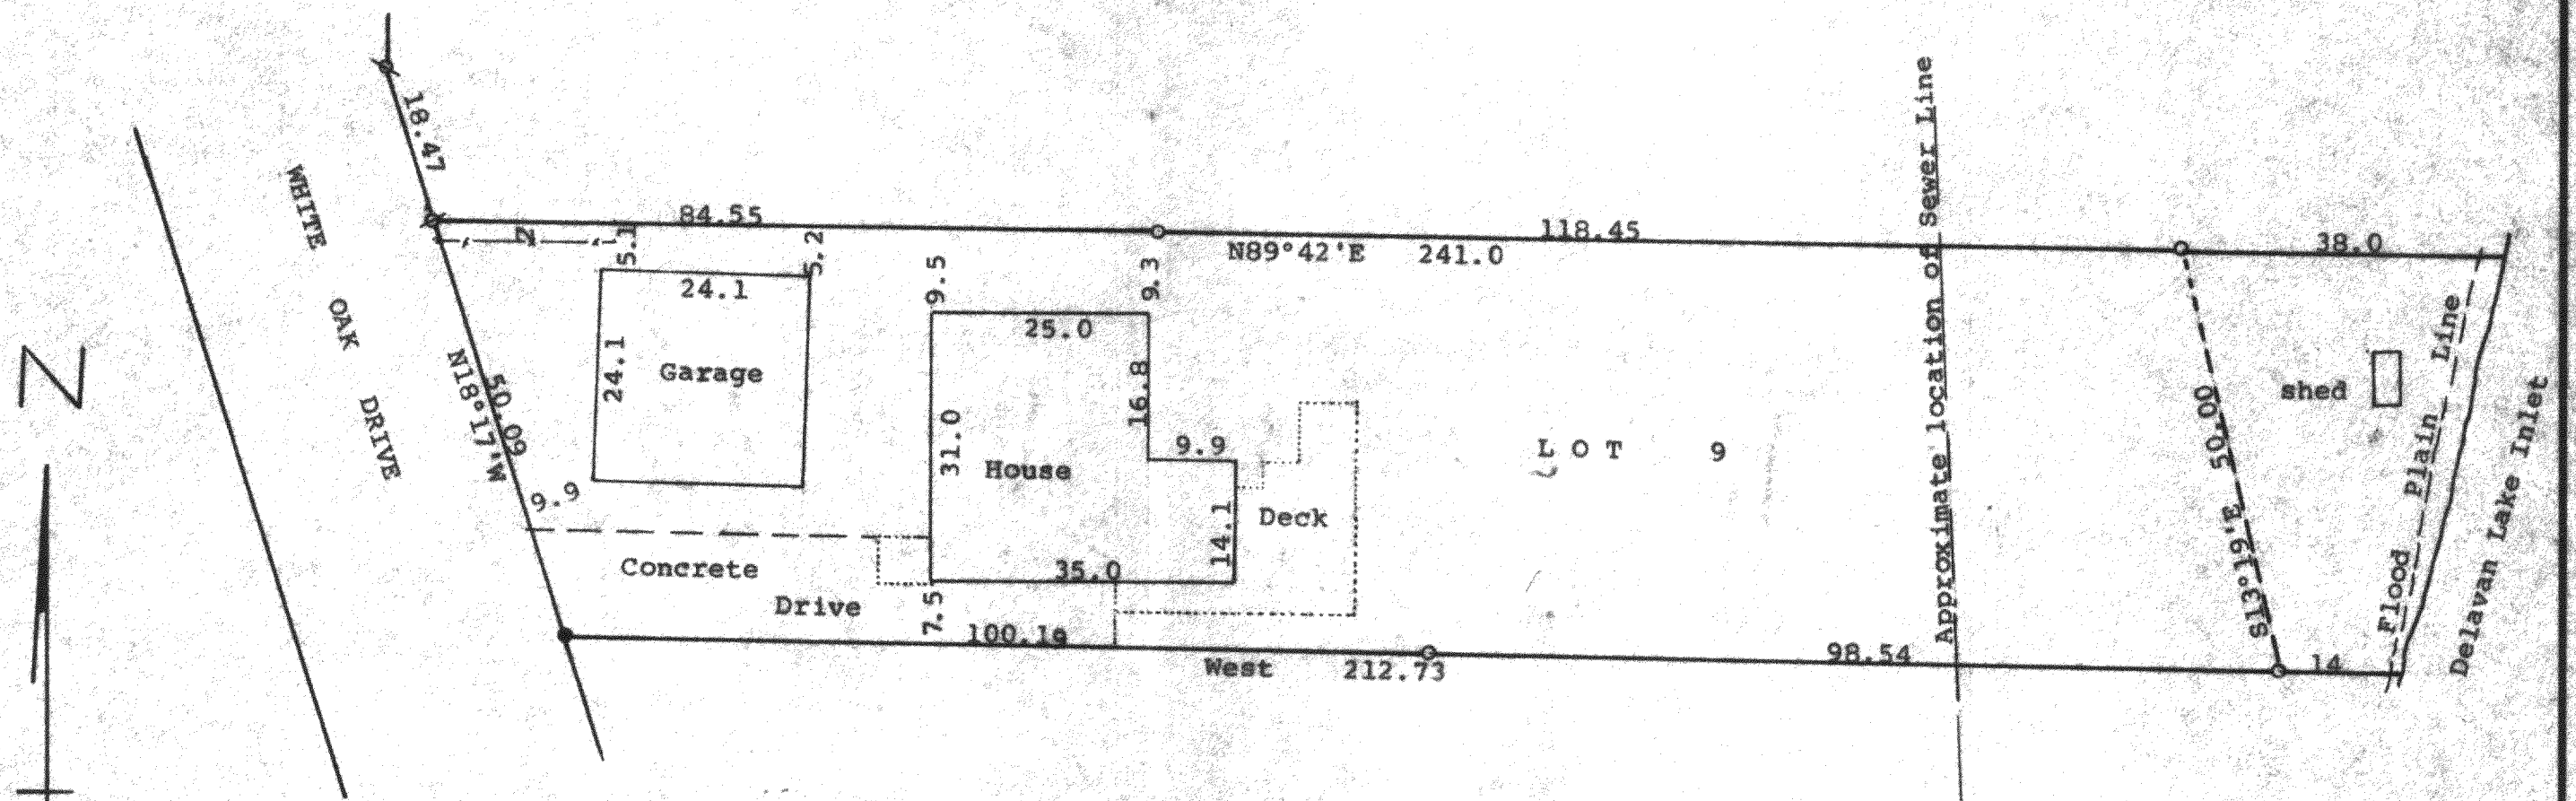

Scale - 1" = 20'
 o = 1" Iron Pipe Found
 o = 3/4" Iron Pipe Found
 o = 1/2" Iron Pipe Found
 o = Bent 1" Iron Pipe Found.
 Pulled and corrected
 --- Fence Line
 Bearings are referenced to the south line of Lot 9, with the assumed bearing of West
 Survey ordered by: The Rauland Agency
 118 Kenosha
 Walworth, WI 53184

STATE OF WISCONSIN) ss
 COUNTY OF WALWORTH)

I, George T. Dunham, Surveyor, certify that I have surveyed the property described as follows:

Lot 9 in The Annex to Inlet Oaks, a subdivision located in Section 22, T 2 N, R 16 E, Walworth County, Wisconsin, subject to easements of record, and that the plat shown hereon is a correct representation thereof and shows the size and location of the property, its exterior boundaries, the location of all visible structures and dimensions of all principal buildings thereon, boundary fences, apparent easements, roadways and visible encroachments, if any, and that I have surveyed the property hereon described, according to the official records, to the best of my knowledge and belief.
 September 23, 1992

George T. Dunham
 George T. Dunham, Surveyor

